


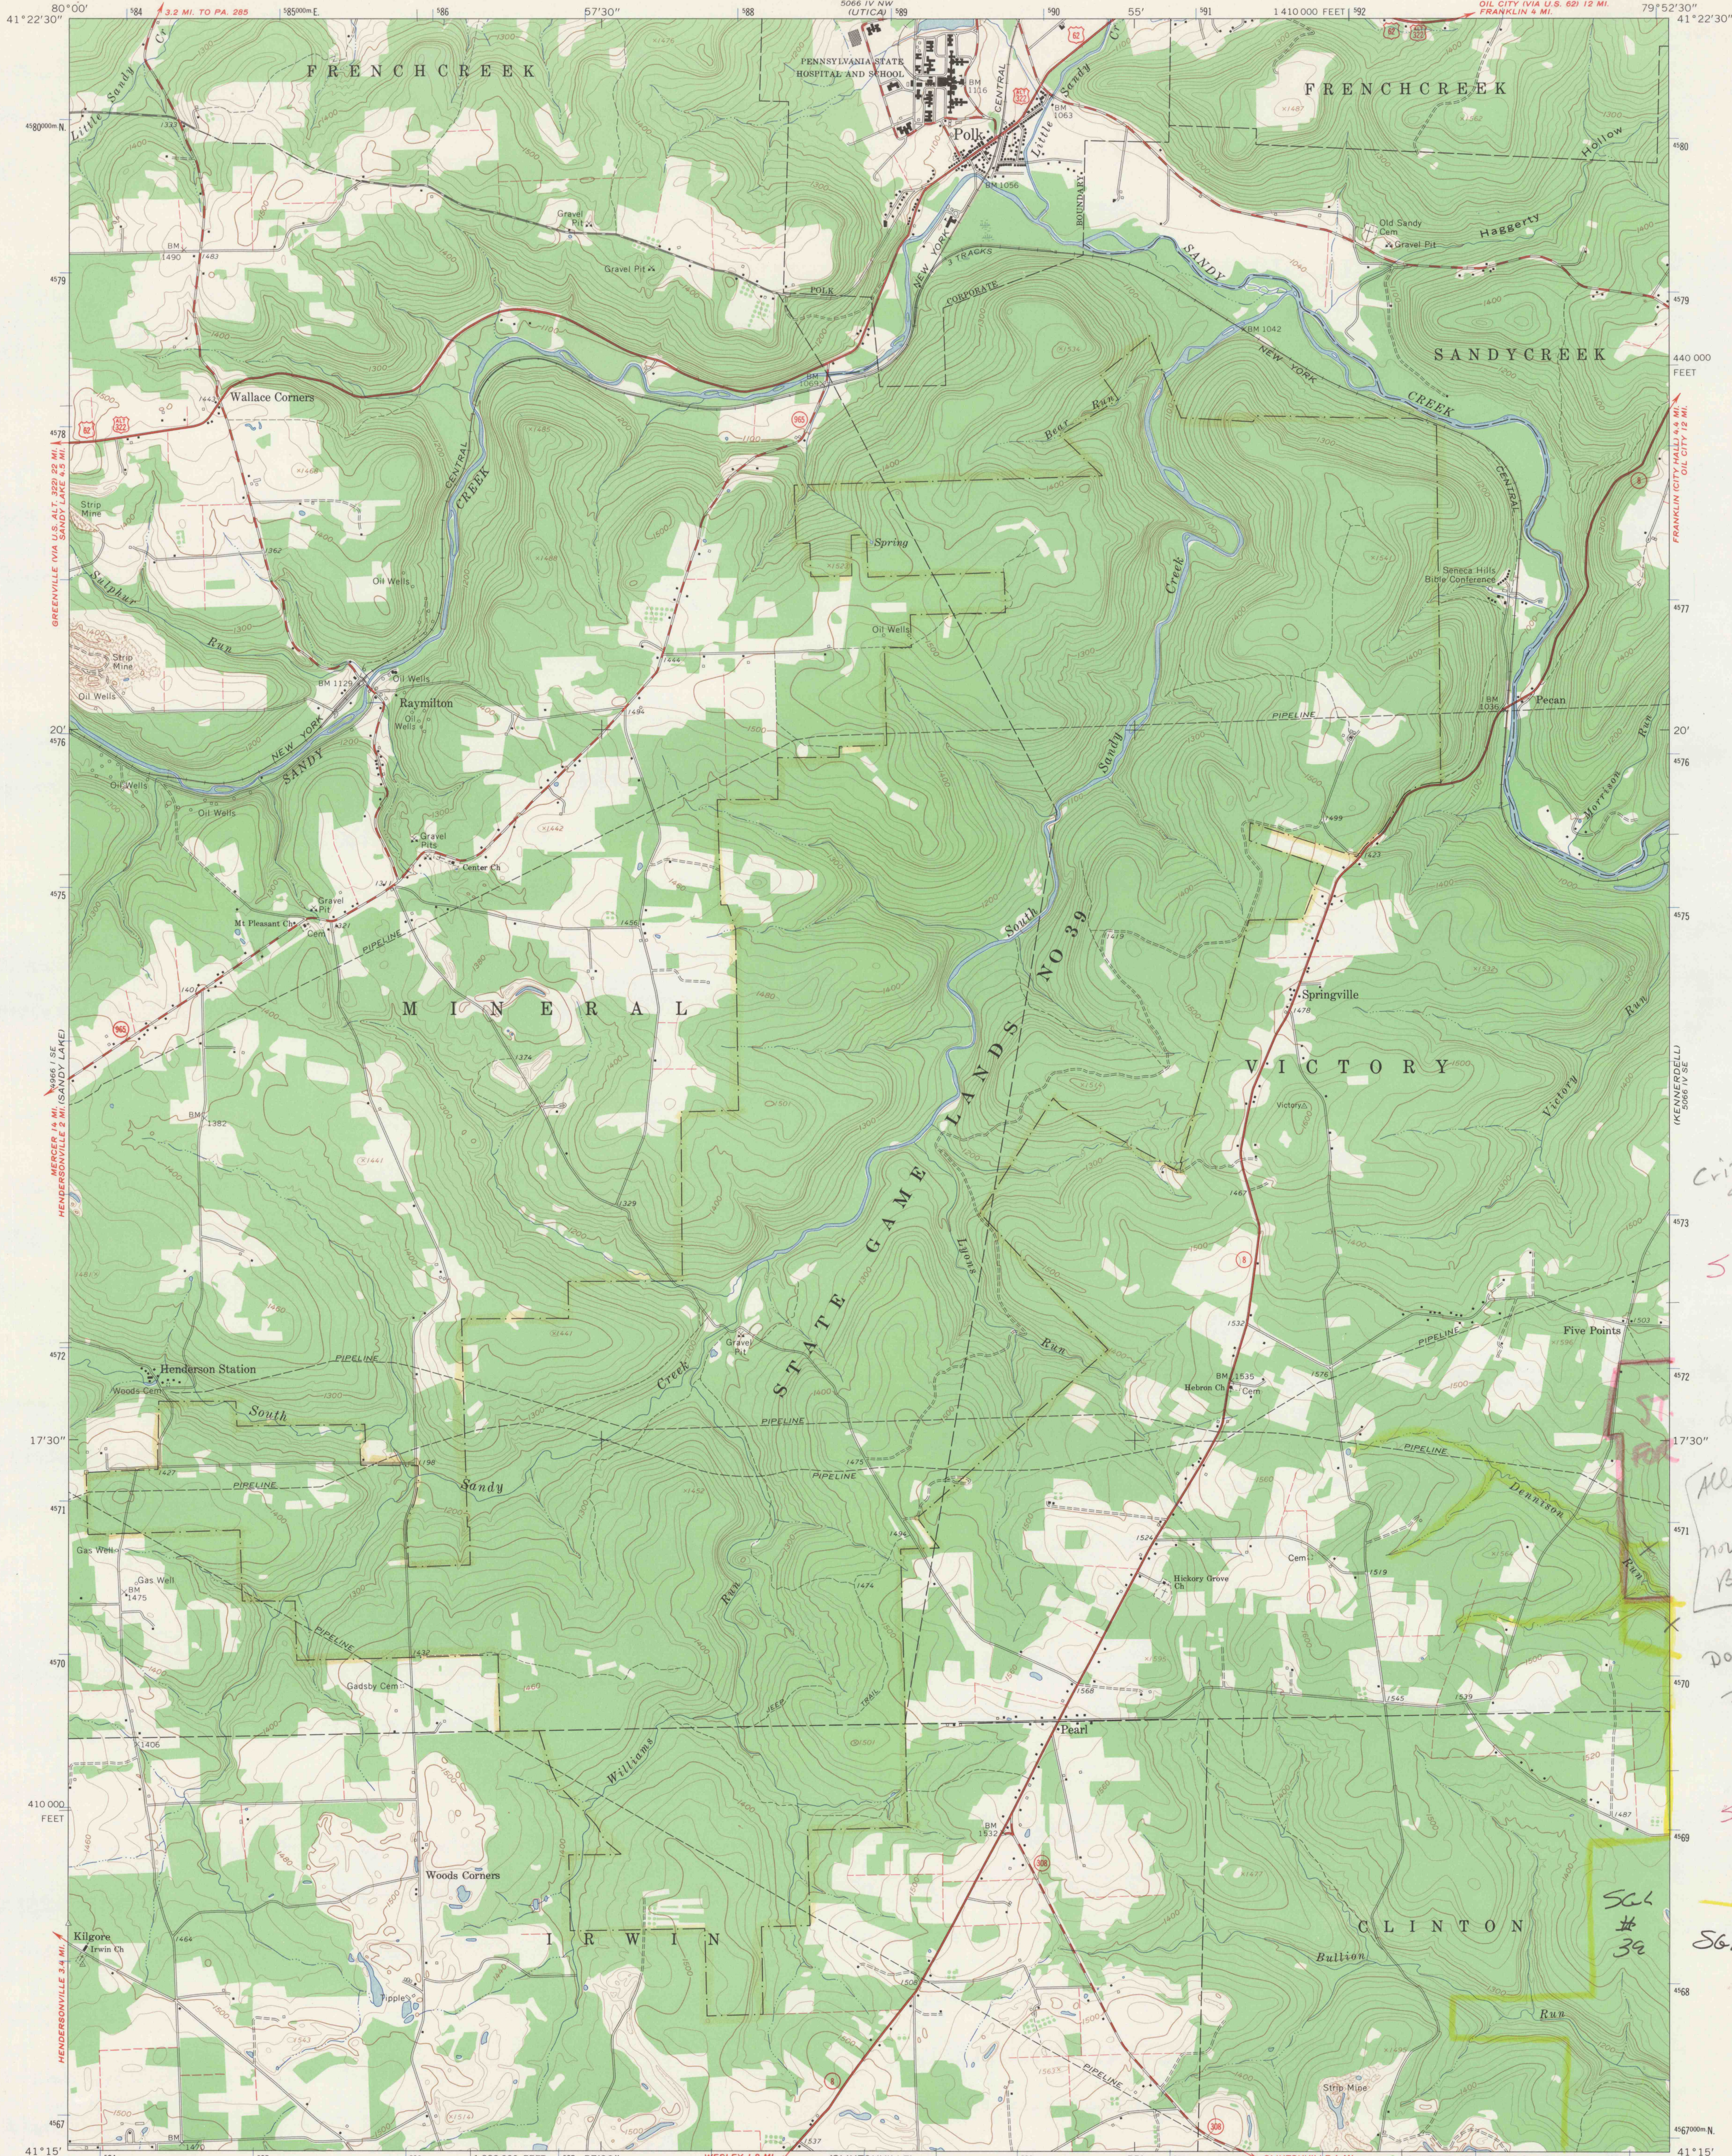

Mapped, edited, and published by the Geological Survey
Control by USGS, USC&GS, USCE, and Pennsylvania Geodetic Survey
Topography by photogrammetric methods from aerial
photographs taken 1962. Field checked 1963
Polyconic projection. 1927 North American datum
10,000-foot grid based on Pennsylvania coordinate system, north zone
1000-meter Universal Transverse Mercator grid ticks,
zone 17, shown in blue
Fine red dashed lines indicate selected fence and field lines where
generally visible on aerial photographs. This information is unchecked

UTM GRID AND 1963 MAGNETIC NORTH
DECLINATION AT CENTER OF SHEET

SCALE 1:24,000
CONTOUR INTERVAL 20 FEET
DATUM IS MEAN SEA LEVEL

PENNSYLVANIA
QUADRANGLE LOCATION

ROAD CLASSIFICATION
Heavy-duty ——— Light-duty ———
Medium-duty ——— Unimproved dirt ———
U.S. Route ——— State Route ———

POLK, PA.
SW 1/4 FRANKLIN 15' QUADRANGLE
N4115—W7952.5/7.5
1963
AMS 5066 IV SW—SERIES V83

DRAWING NUMBER

DRAWING NUMBER

DRAWING NUMBER

PLAN HOLD CORPORATION • FRANK, CALIFORNIA
REPRODUCED BY NUMBER 07549

PLAN HOLD CORPORATION • FRANK, CALIFORNIA
REPRODUCED BY NUMBER 07549

PLAN HOLD CORPORATION • FRANK, CALIFORNIA
REPRODUCED BY NUMBER 07549

3-4.3

NC
3-4.3