

HQ (SEE CARD)  
Moshannon  
State  
Forest


56L # 100  
Quehanna  
wild Area

DRAWING NUMBER


DRAWING NUMBER

DRAWING NUMBER  
SAM 4-11-1

Mapped, edited, and published by the Geological Survey  
Control by USGS and USC&GS  
Topography from aerial photographs by photogrammetric methods  
Aerial photographs taken 1958. Field check 1959  
Polyconic projection. 1927 North American datum  
10,000-foot grid based on Pennsylvania coordinate system,  
north zone  
1000-meter Universal Transverse Mercator grid ticks,  
zone 17, shown in blue  
Fine red dashed lines indicate selected fence and field lines where  
generally visible on aerial photographs. This information is unchecked  
Revisions shown in purple compiled in cooperation with  
State of Pennsylvania agencies from aerial photographs  
taken 1971. This information not field checked

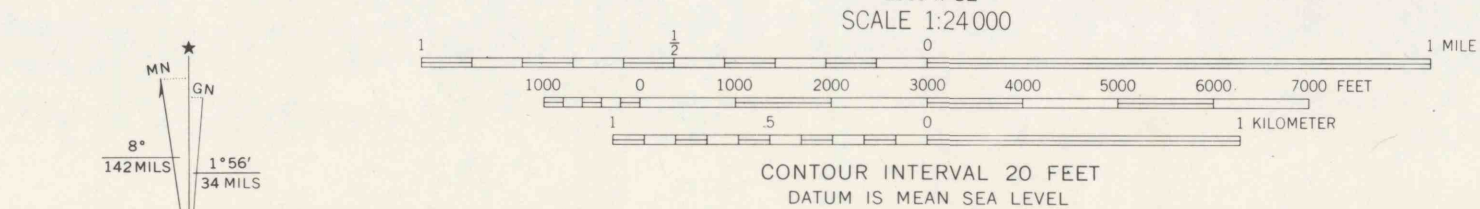

ROAD CLASSIFICATION  
Medium-duty ——— Light-duty ———  
Unimproved dirt - - - - -

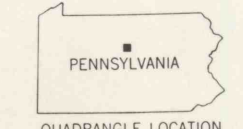

POTTERSDALE, PA.  
N 4107.5—W 7800.7.5  
1959  
PHOTOREVISED 1971  
AMS 5366 II NE—SERIES V 831

4-11-1