



PLAN HOLD

PEEL PROTECTIVE STRIP TO EXPOSE ADHESIVE. POSITION EDGE OF PRINT ON THIS LINE AND RUB TO ADHERE.




PLAN HOLD CORPORATION - TORRANCE - CALIFORNIA
REORDER BY NO. 0783424

DRAWING NUMBER
B/4-11.1

0921 2

COAL 107

B/4-11.1 (Sheet 1 of 2)
0921

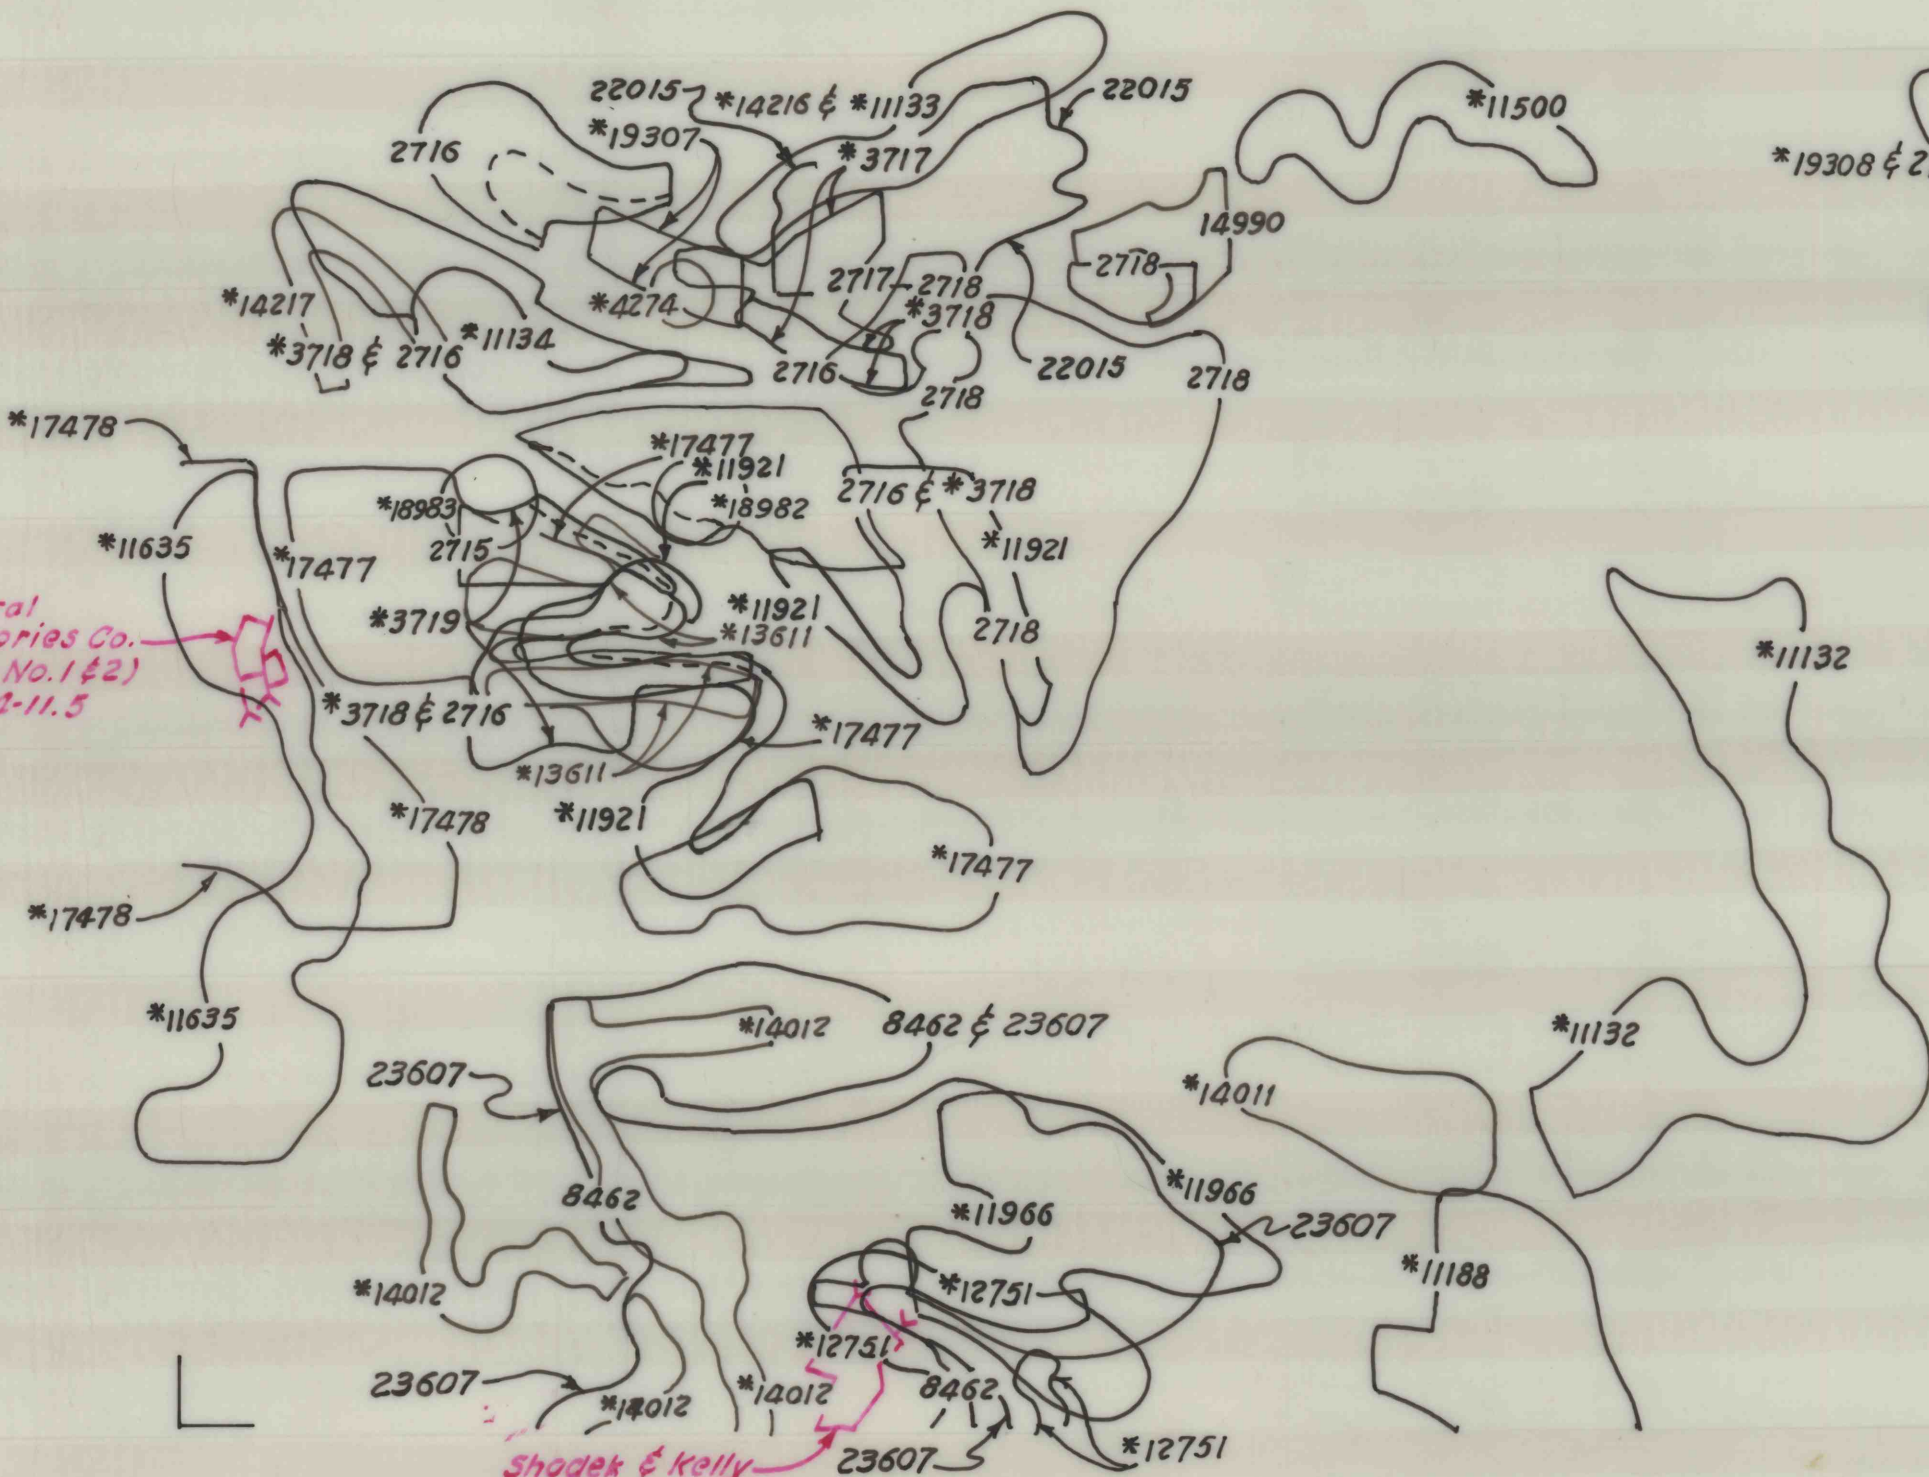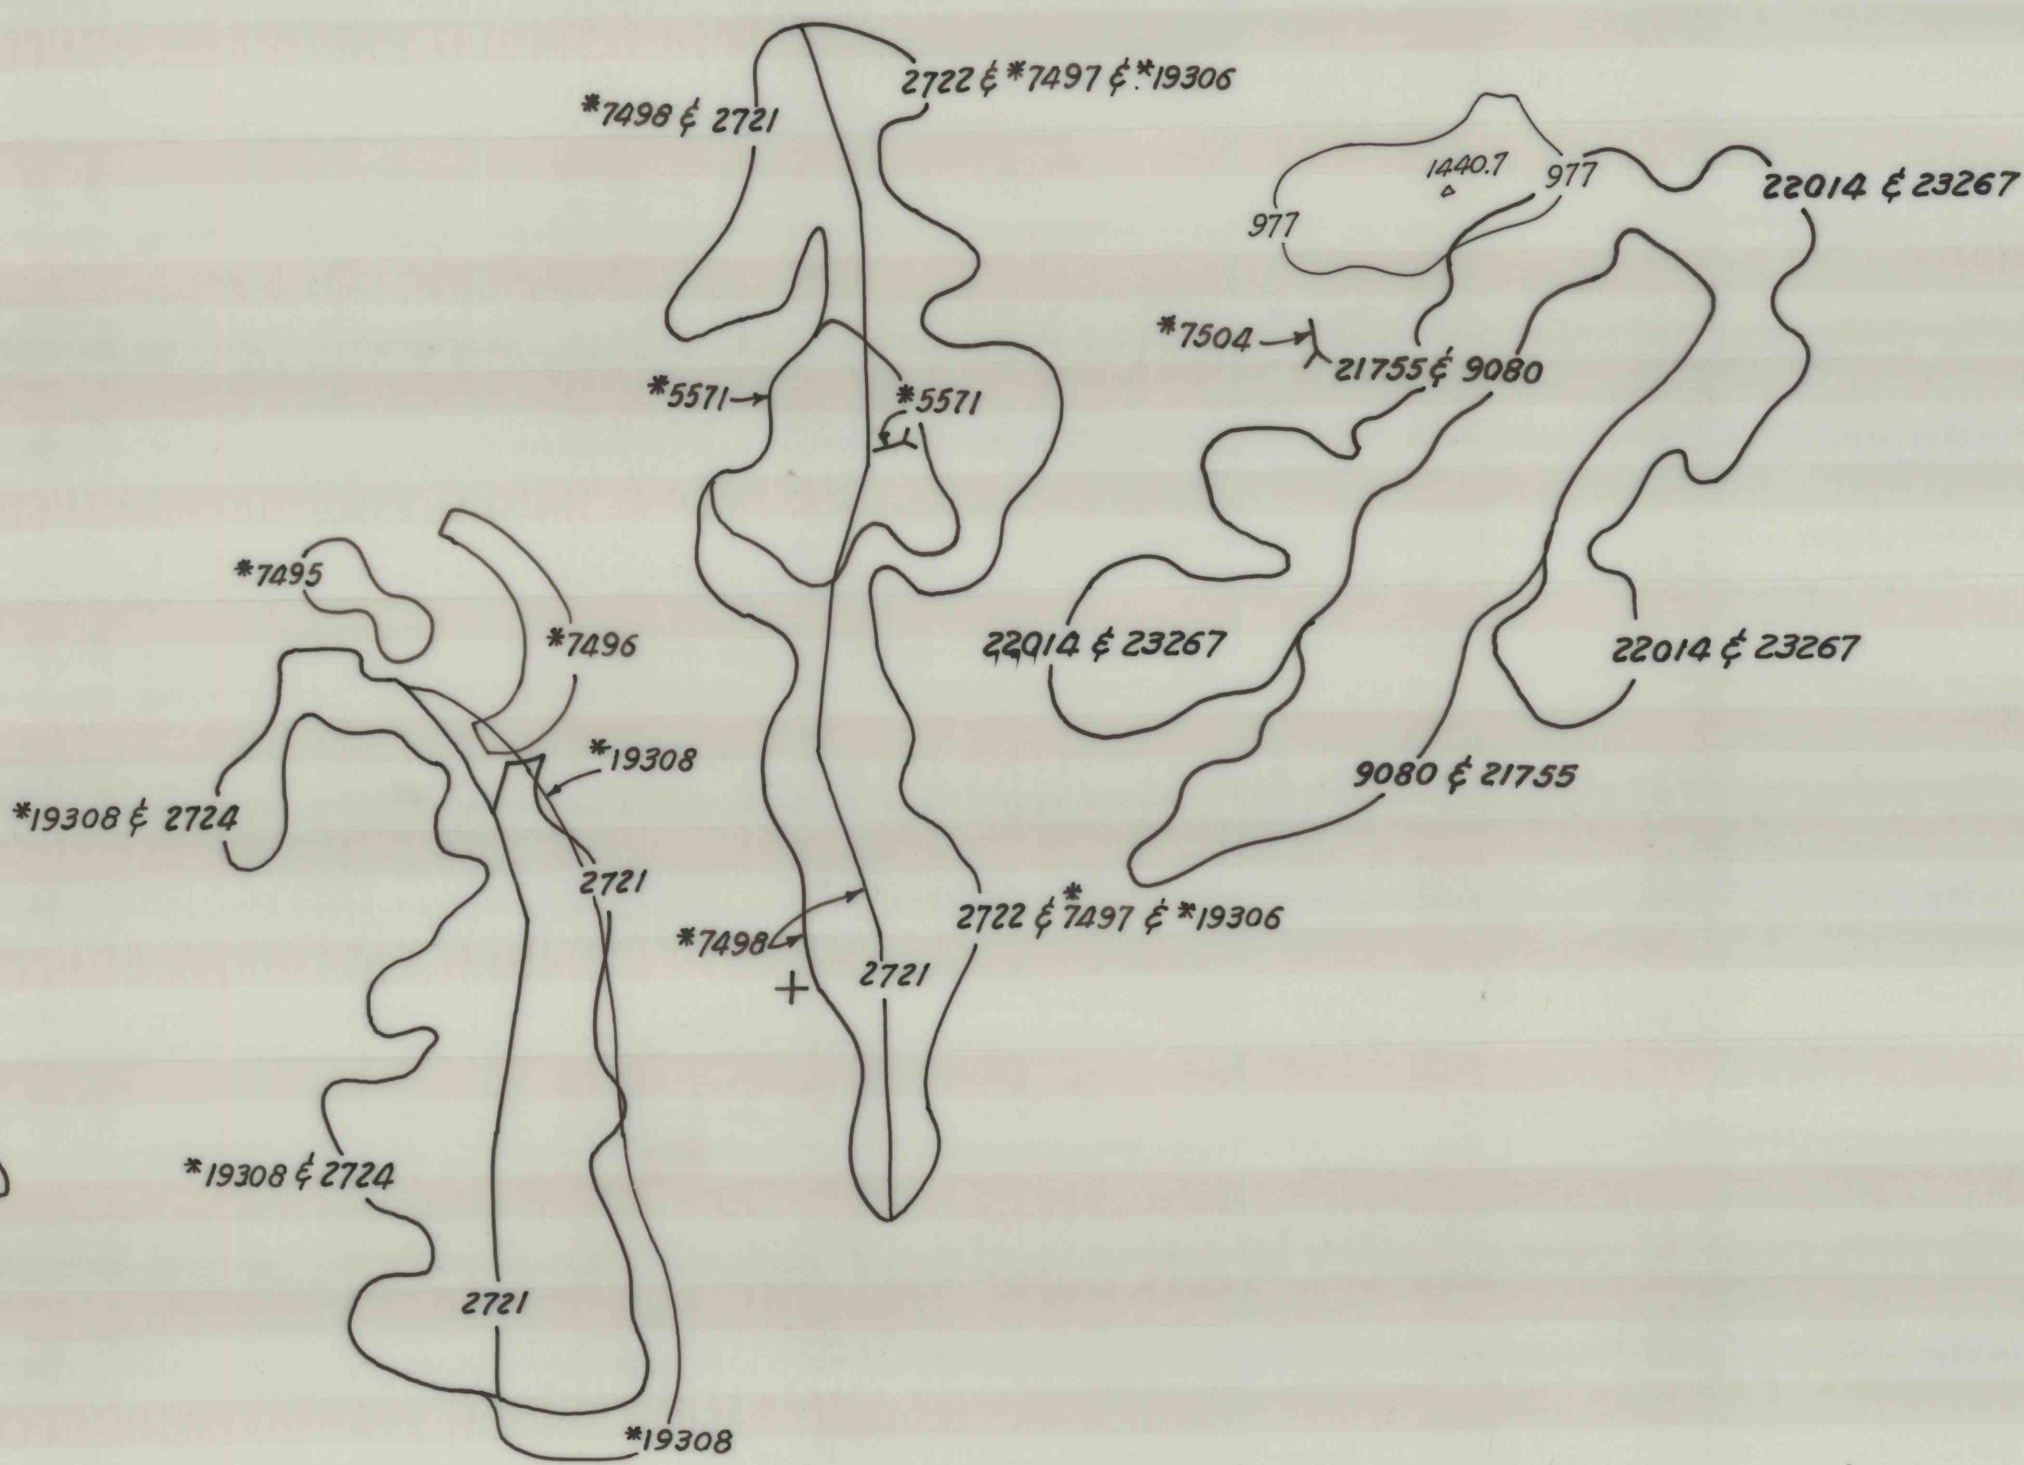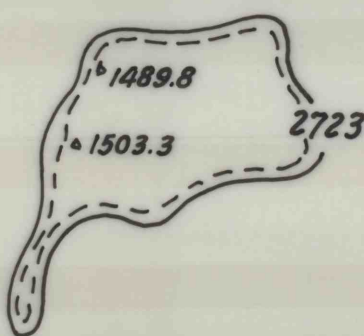

+ +