PLAN HOLD
PEEL PROTECTIVE STRIP TO EXPOSE ADHESIVE. POSITION EDGE OF PRINT ON THIS LINE AND RUB TO ADHERE.
DRAWING NUMBER
C'/4-11.1
PLAN HOLD CORPORATION · TORRANCE · CALIFORNIA
REORDER BY NO. 070SA-24

0921 2

COAL 109
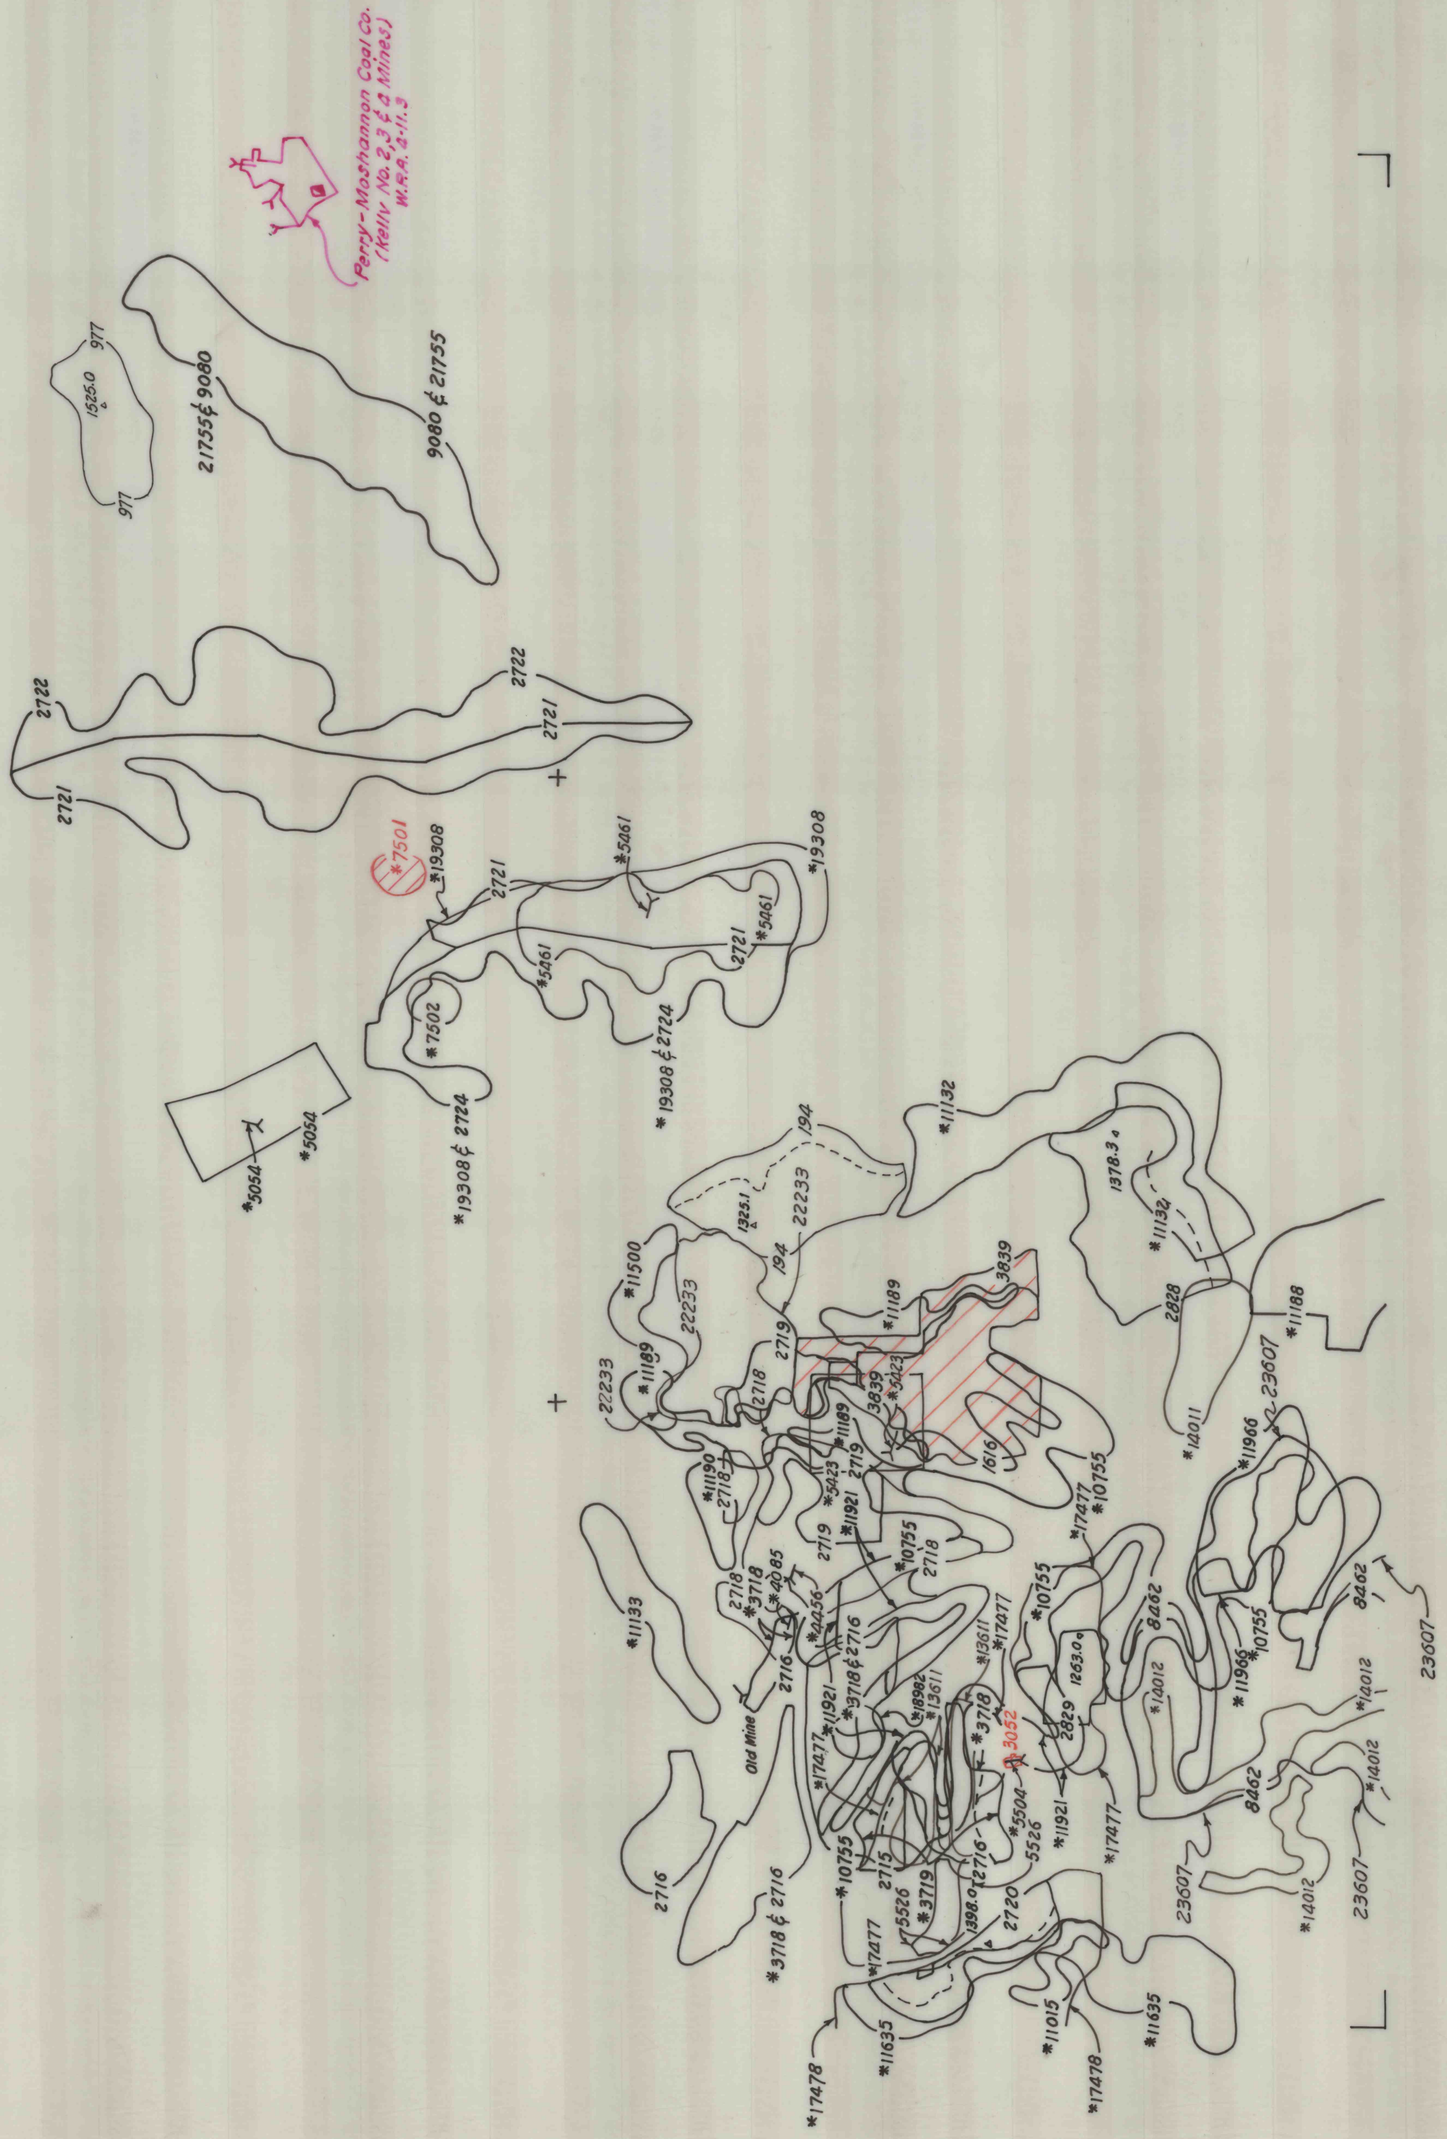
C'/4-11.1 (Sheet 1 of 2)
Q921