PLAN HOLD
PEEL PROTECTIVE STRIP TO EXPOSE ADHESIVE. POSITION EDGE OF PRINT ON THIS LINE AND RUB TO ADHERE.
PLAN HOLD CORPORATION · TORRANCE · CALIFORNIA
REORDER BY NO. 070SA-24

DRAWING NUMBER
D/4-11.1

0921 2

COAL 110
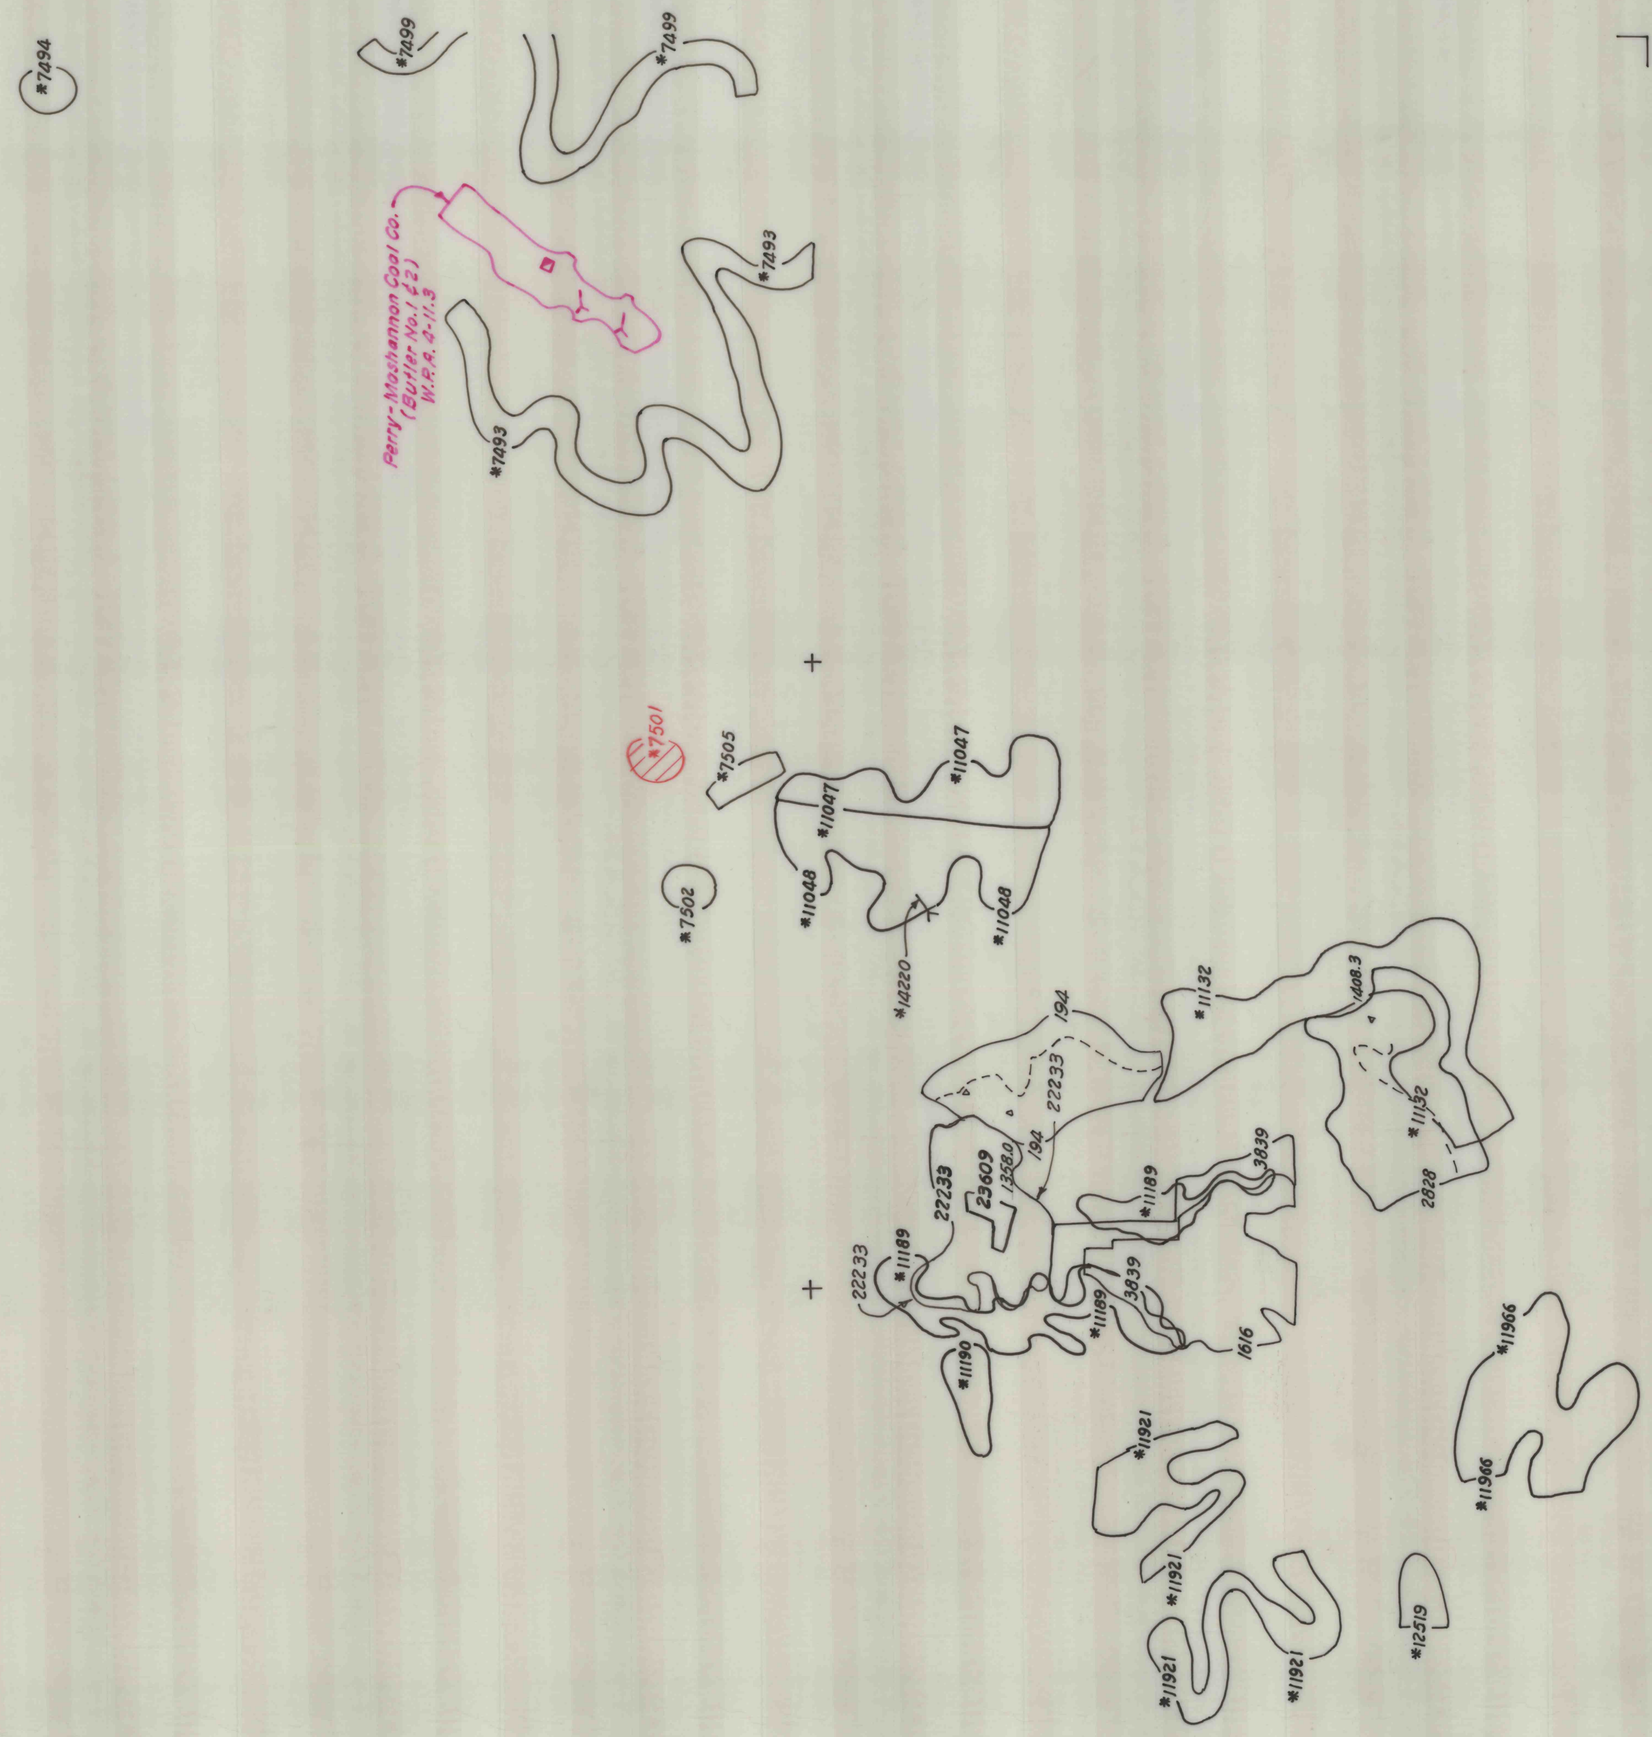
D/4-11.1 (Sheet 1 of 2)
0921