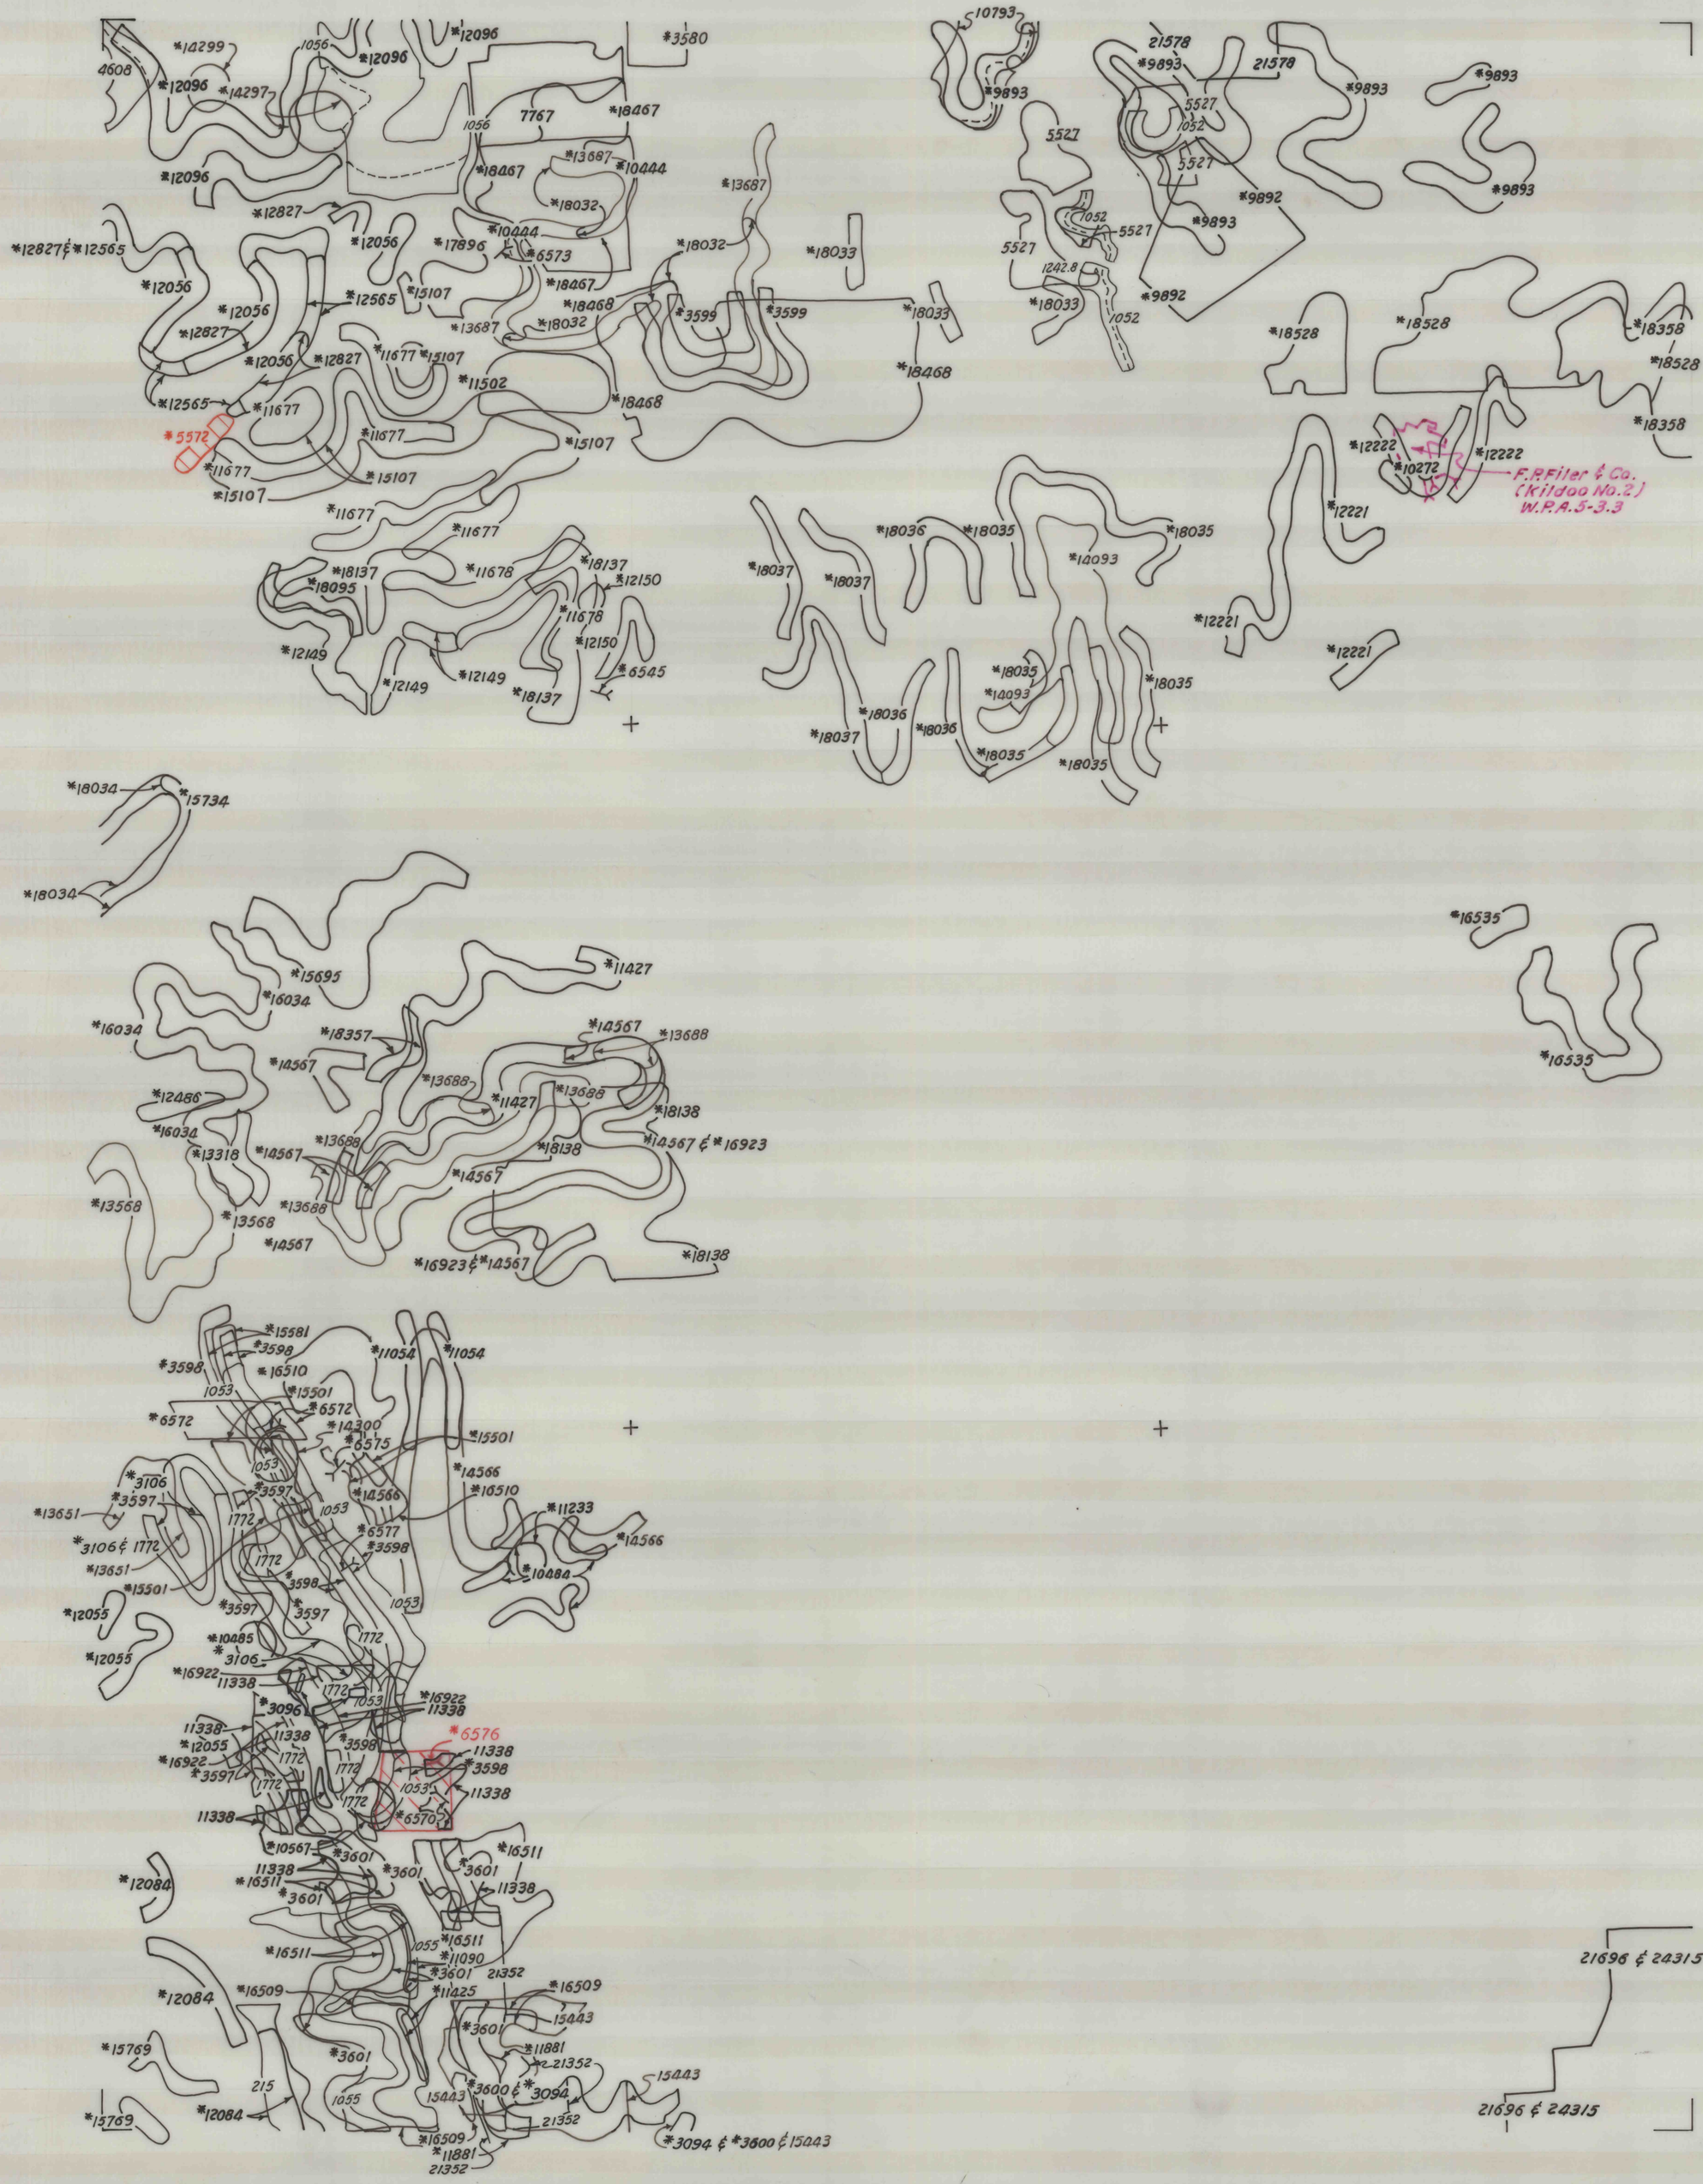


COAL 108

C/5-3.1 (Sheet 1 of 2)
11105

C/5-3.1
5
105
11