



PLAN HOLD

PEEL PROTECTIVE STRIP TO EXPOSE ADHESIVE. POSITION EDGE OF PRINT ON THIS LINE AND RUB TO ADHERE.

NONCOAL


DRAWING NUMBER

MISC./3-20.1

PLAN HOLD CORPORATION, TORRANCE, CALIFORNIA
REORDER BY NO. 0753A.24

0739

MISC./3-20.1
SAND & GRAVEL
SANDSTONE
0739

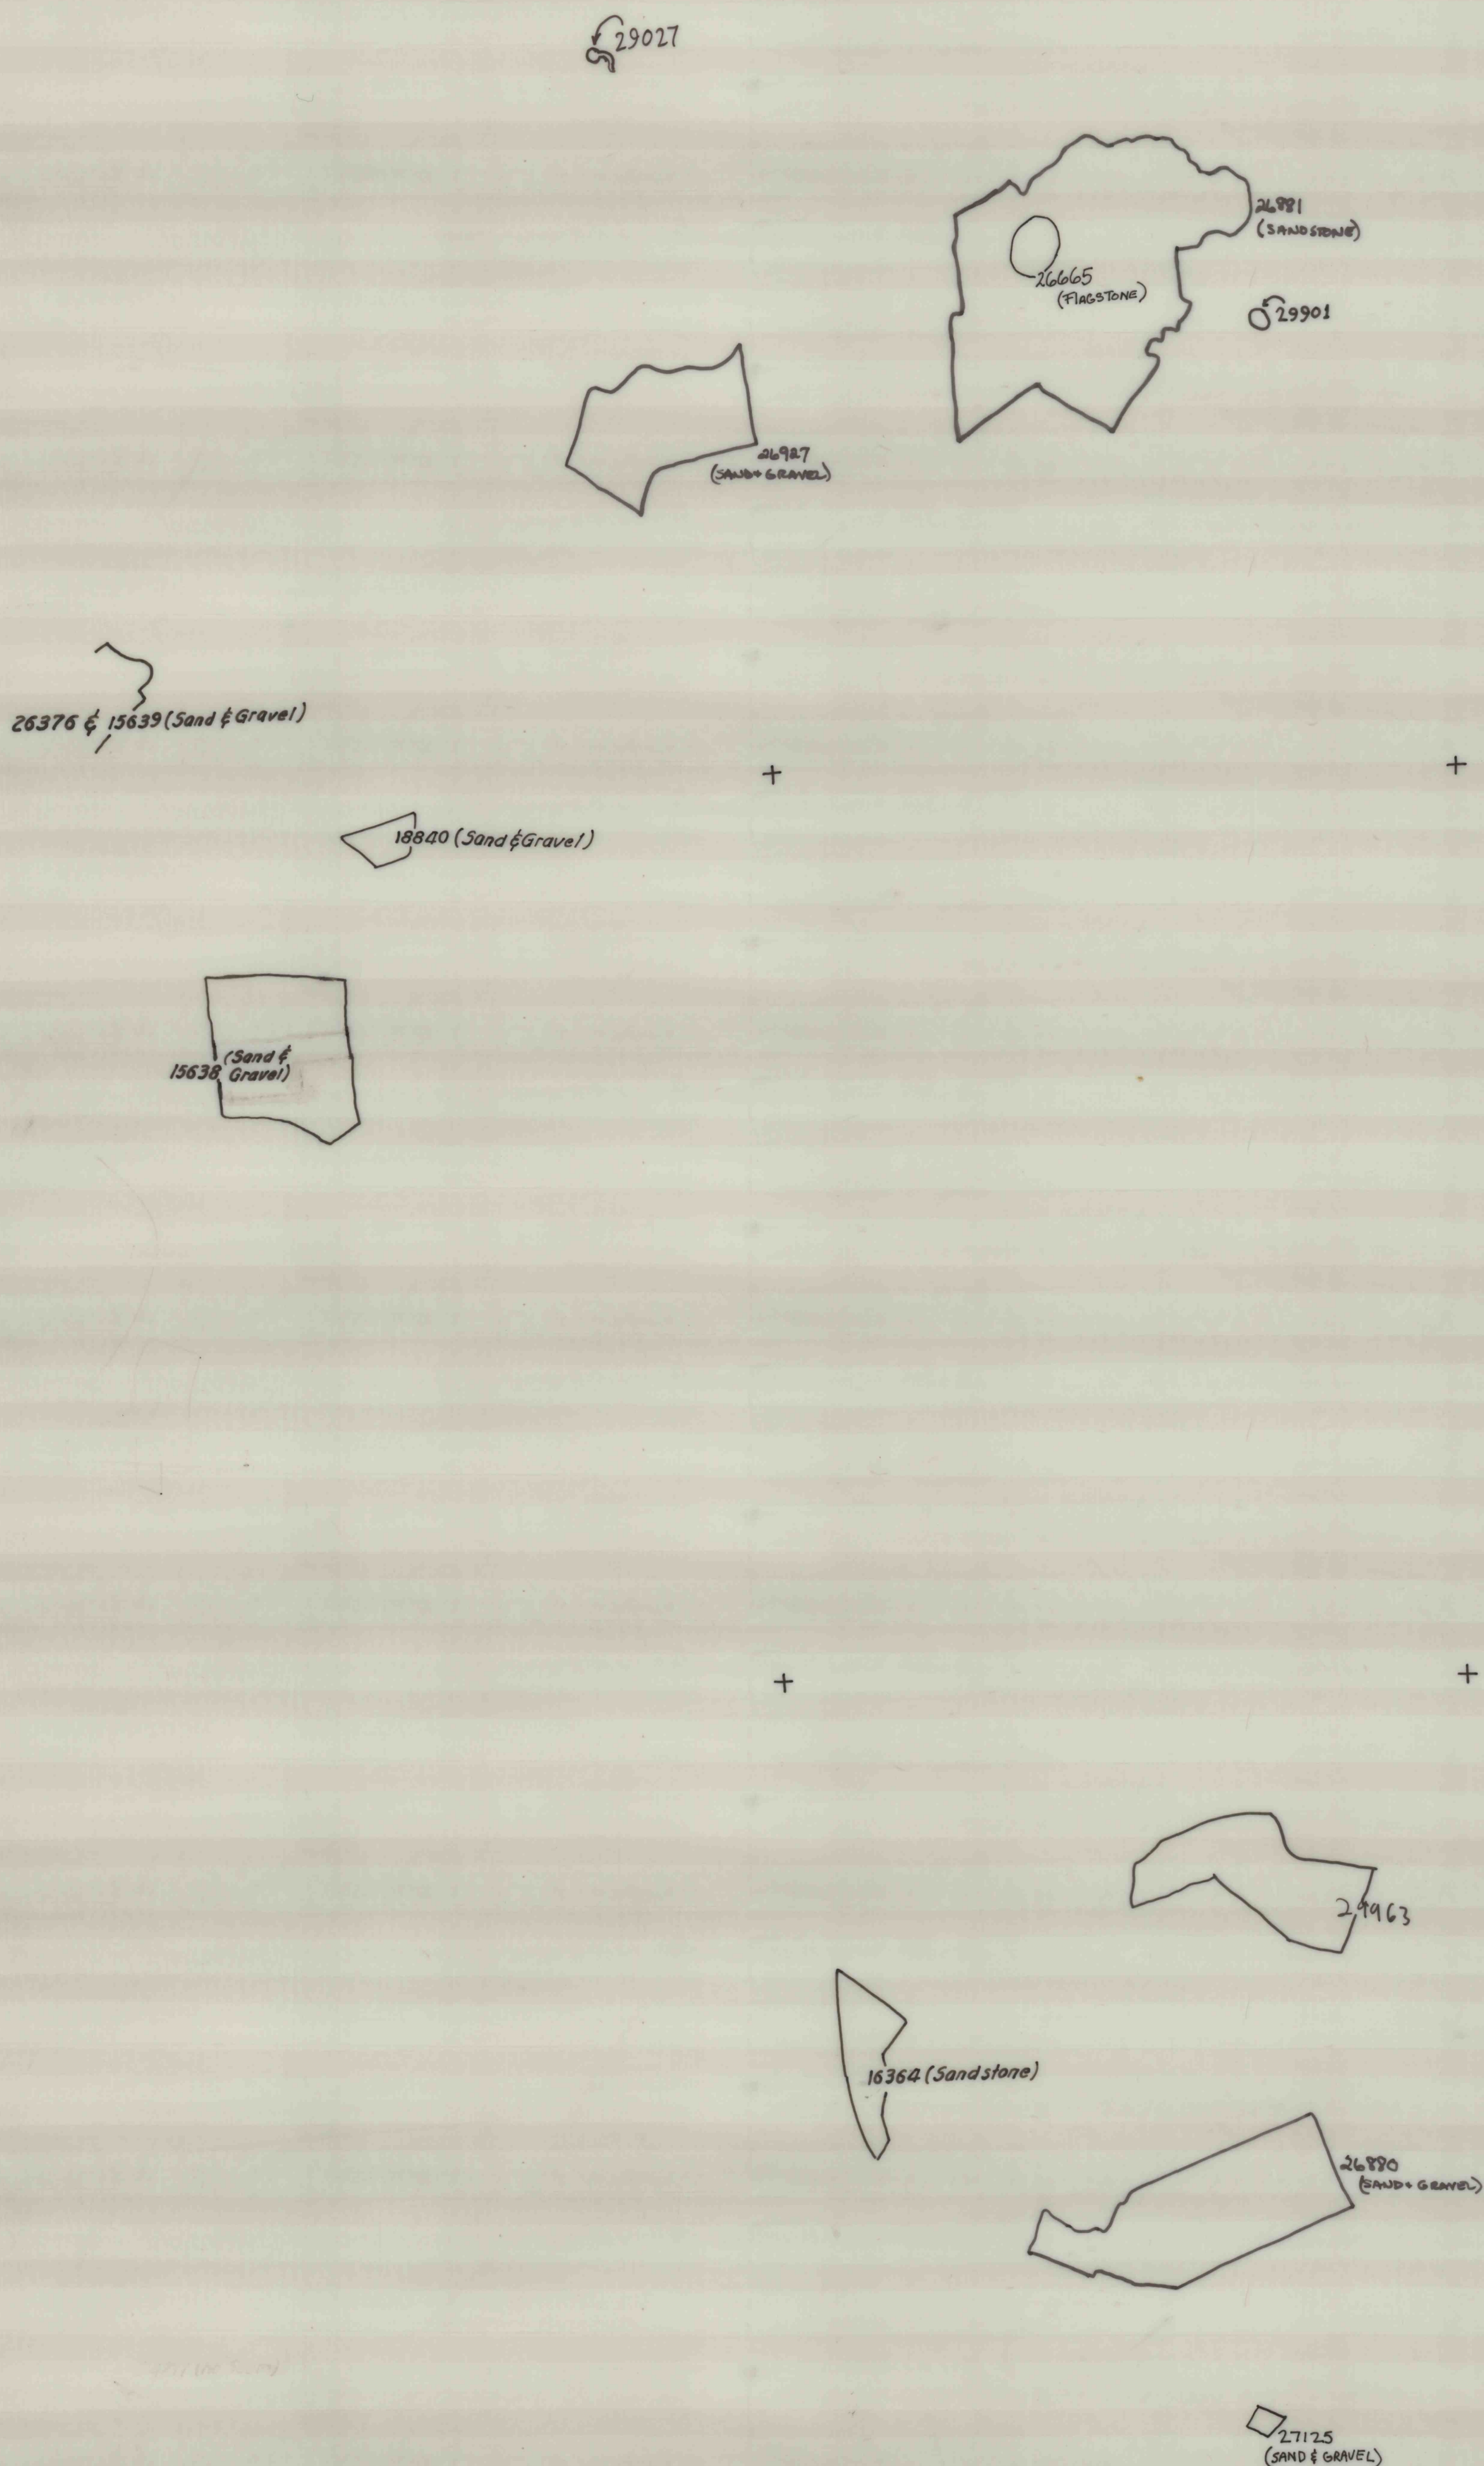

..... Outcrop of base of geologic formation
containing coal beds
----- Outcrop of lowest presently mined coal
----- Shore line of mine water pool