DRAWING NUMBER

PLAN HOLD CORPORATION • IRVINE, CALIFORNIA

REORDER BY NUMBER 07SAR

DRAWING NUMBER

PLAN HOLD CORPORATION • IRVINE, CALIFORNIA

REORDER BY NUMBER 07SAR

DRAWING NUMBER

C. 4-8.3

1014

PLAN HOLD CORPORATION • IRVINE, CALIFORNIA

REORDER BY NUMBER 07SAR

COAL 108

C/4-8.3 (Sheet 1 of 2)
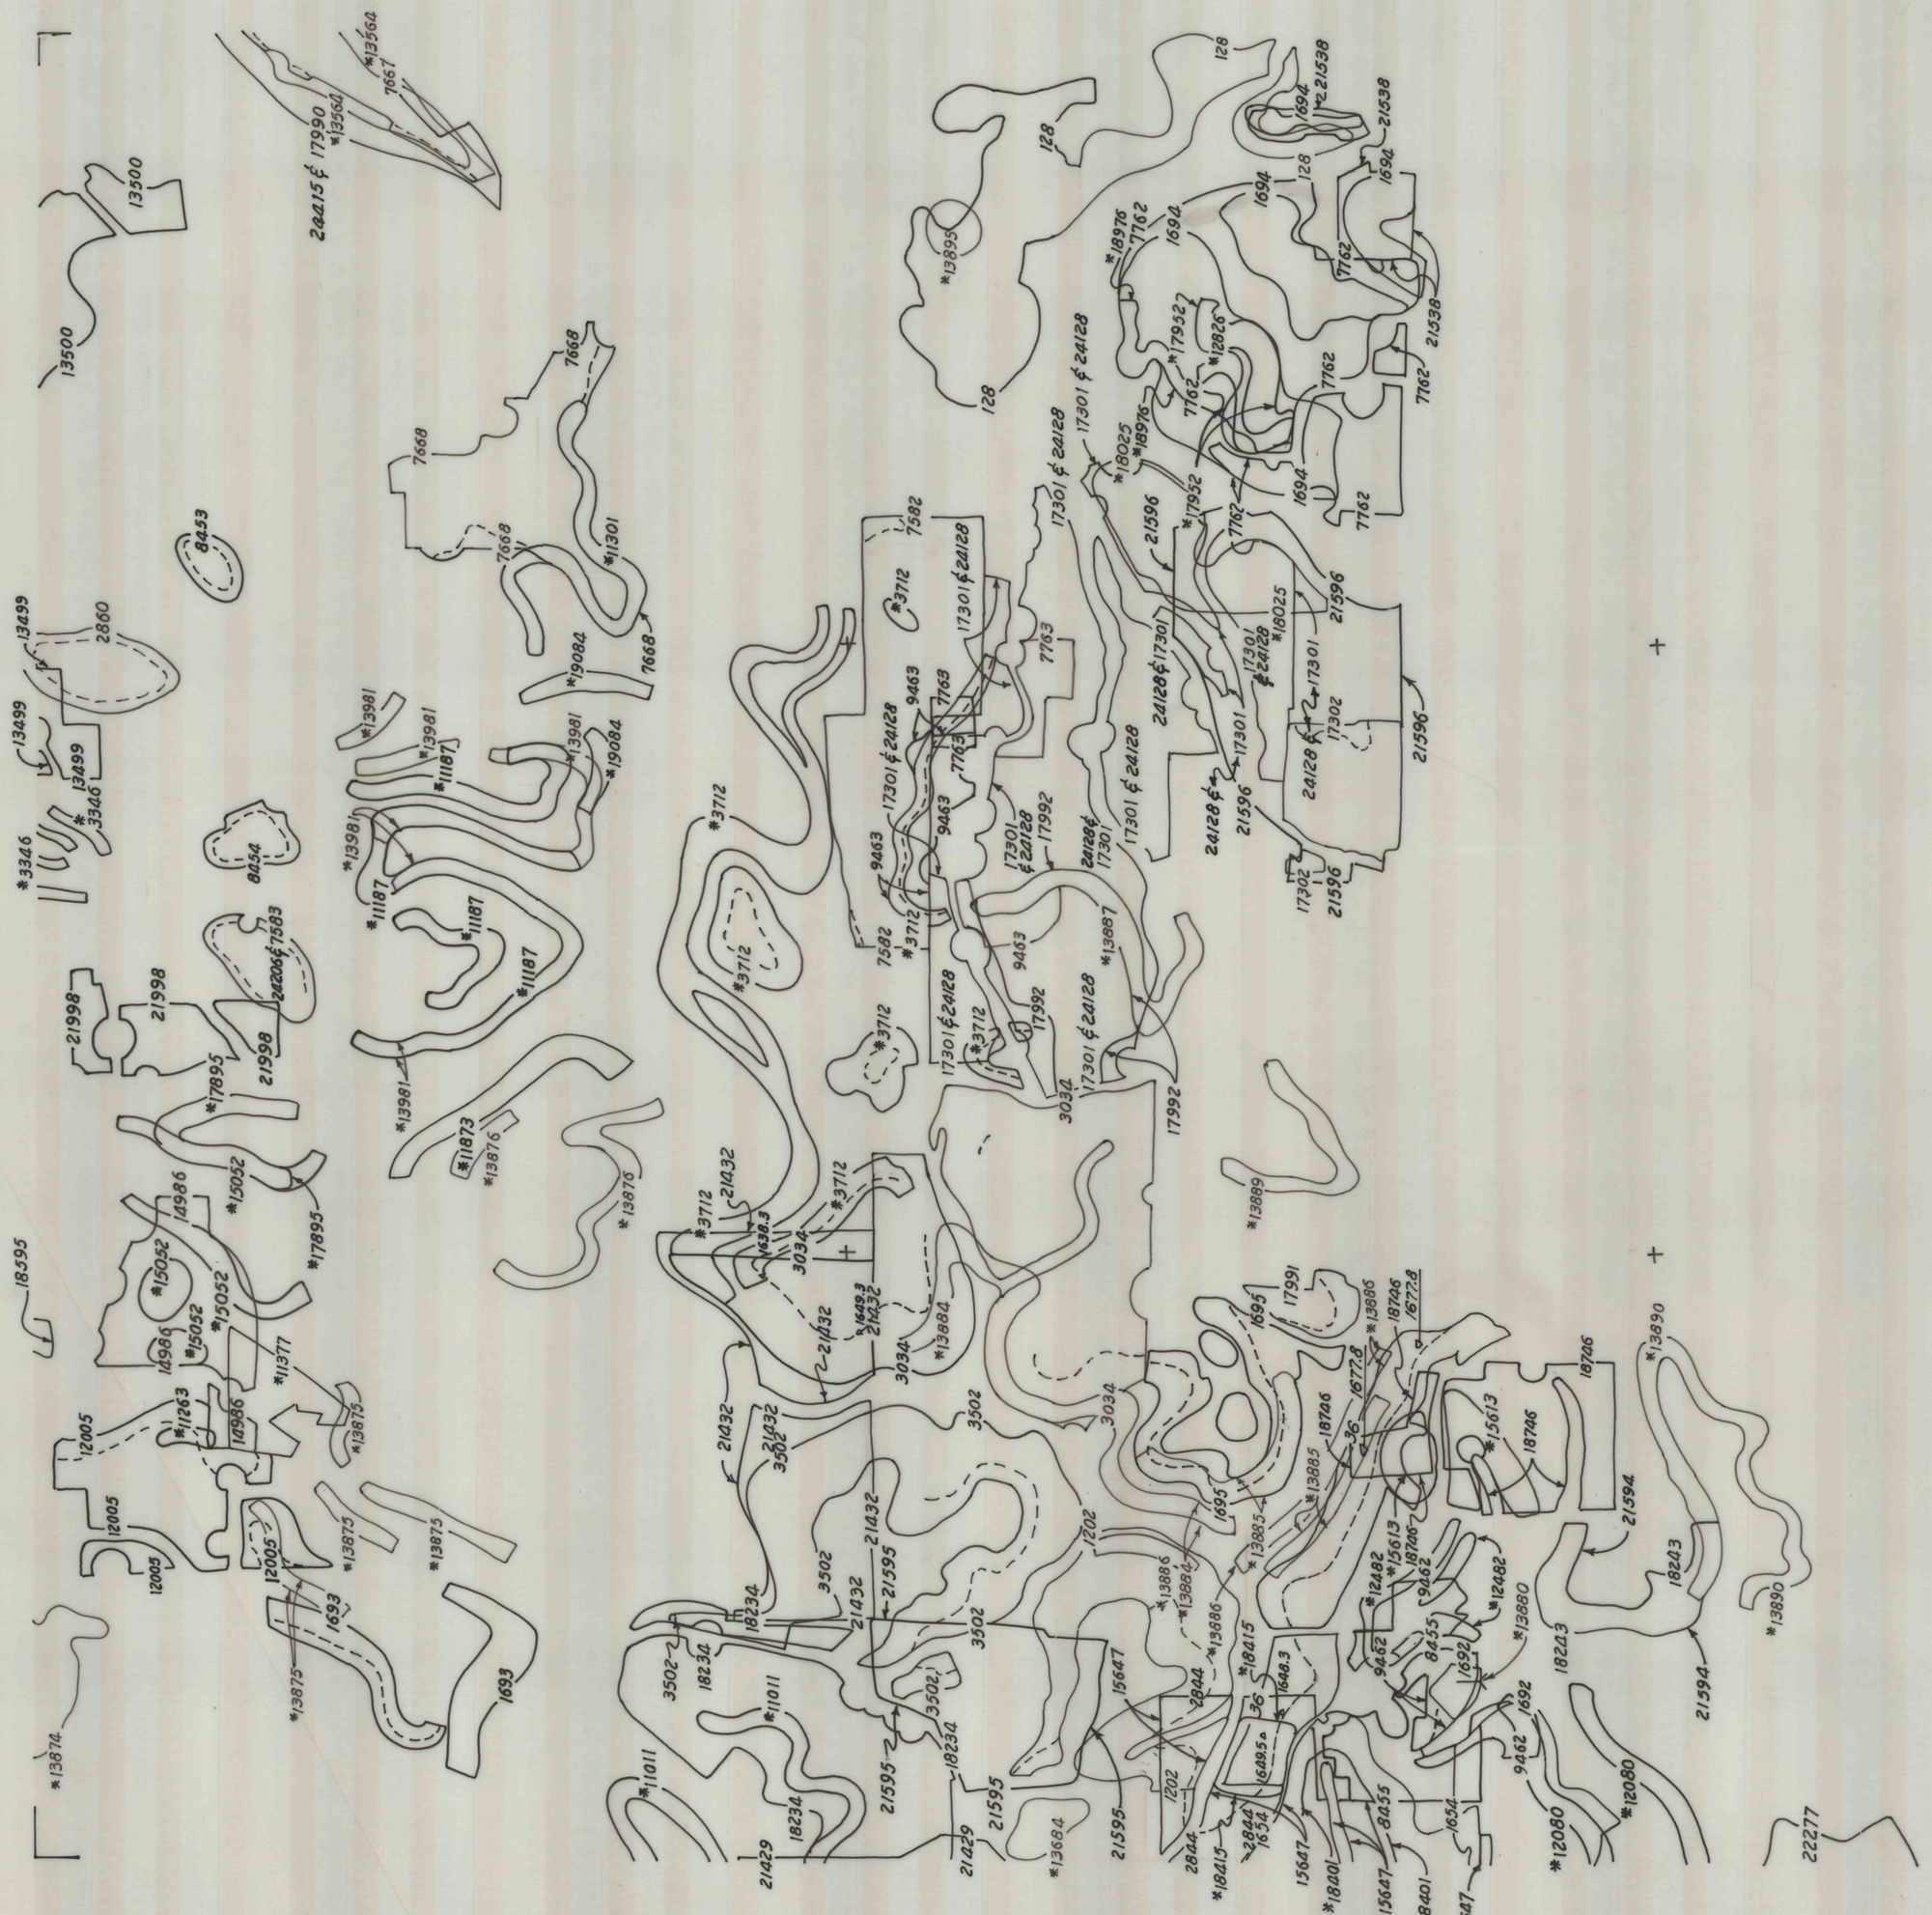
1014