PLAN HOLD
PEEL PROTECTIVE STRIP TO EXPOSE ADHESIVE. POSITION EDGE OF PRINT ON THIS LINE AND RUB TO ADHERE.
PLAN HOLD CORPORATION · TORRANCE · CALIFORNIA
REORDER BY NO. 070SA-24

DRAWING NUMBER
C'/4-8.3

1014

COAL 109
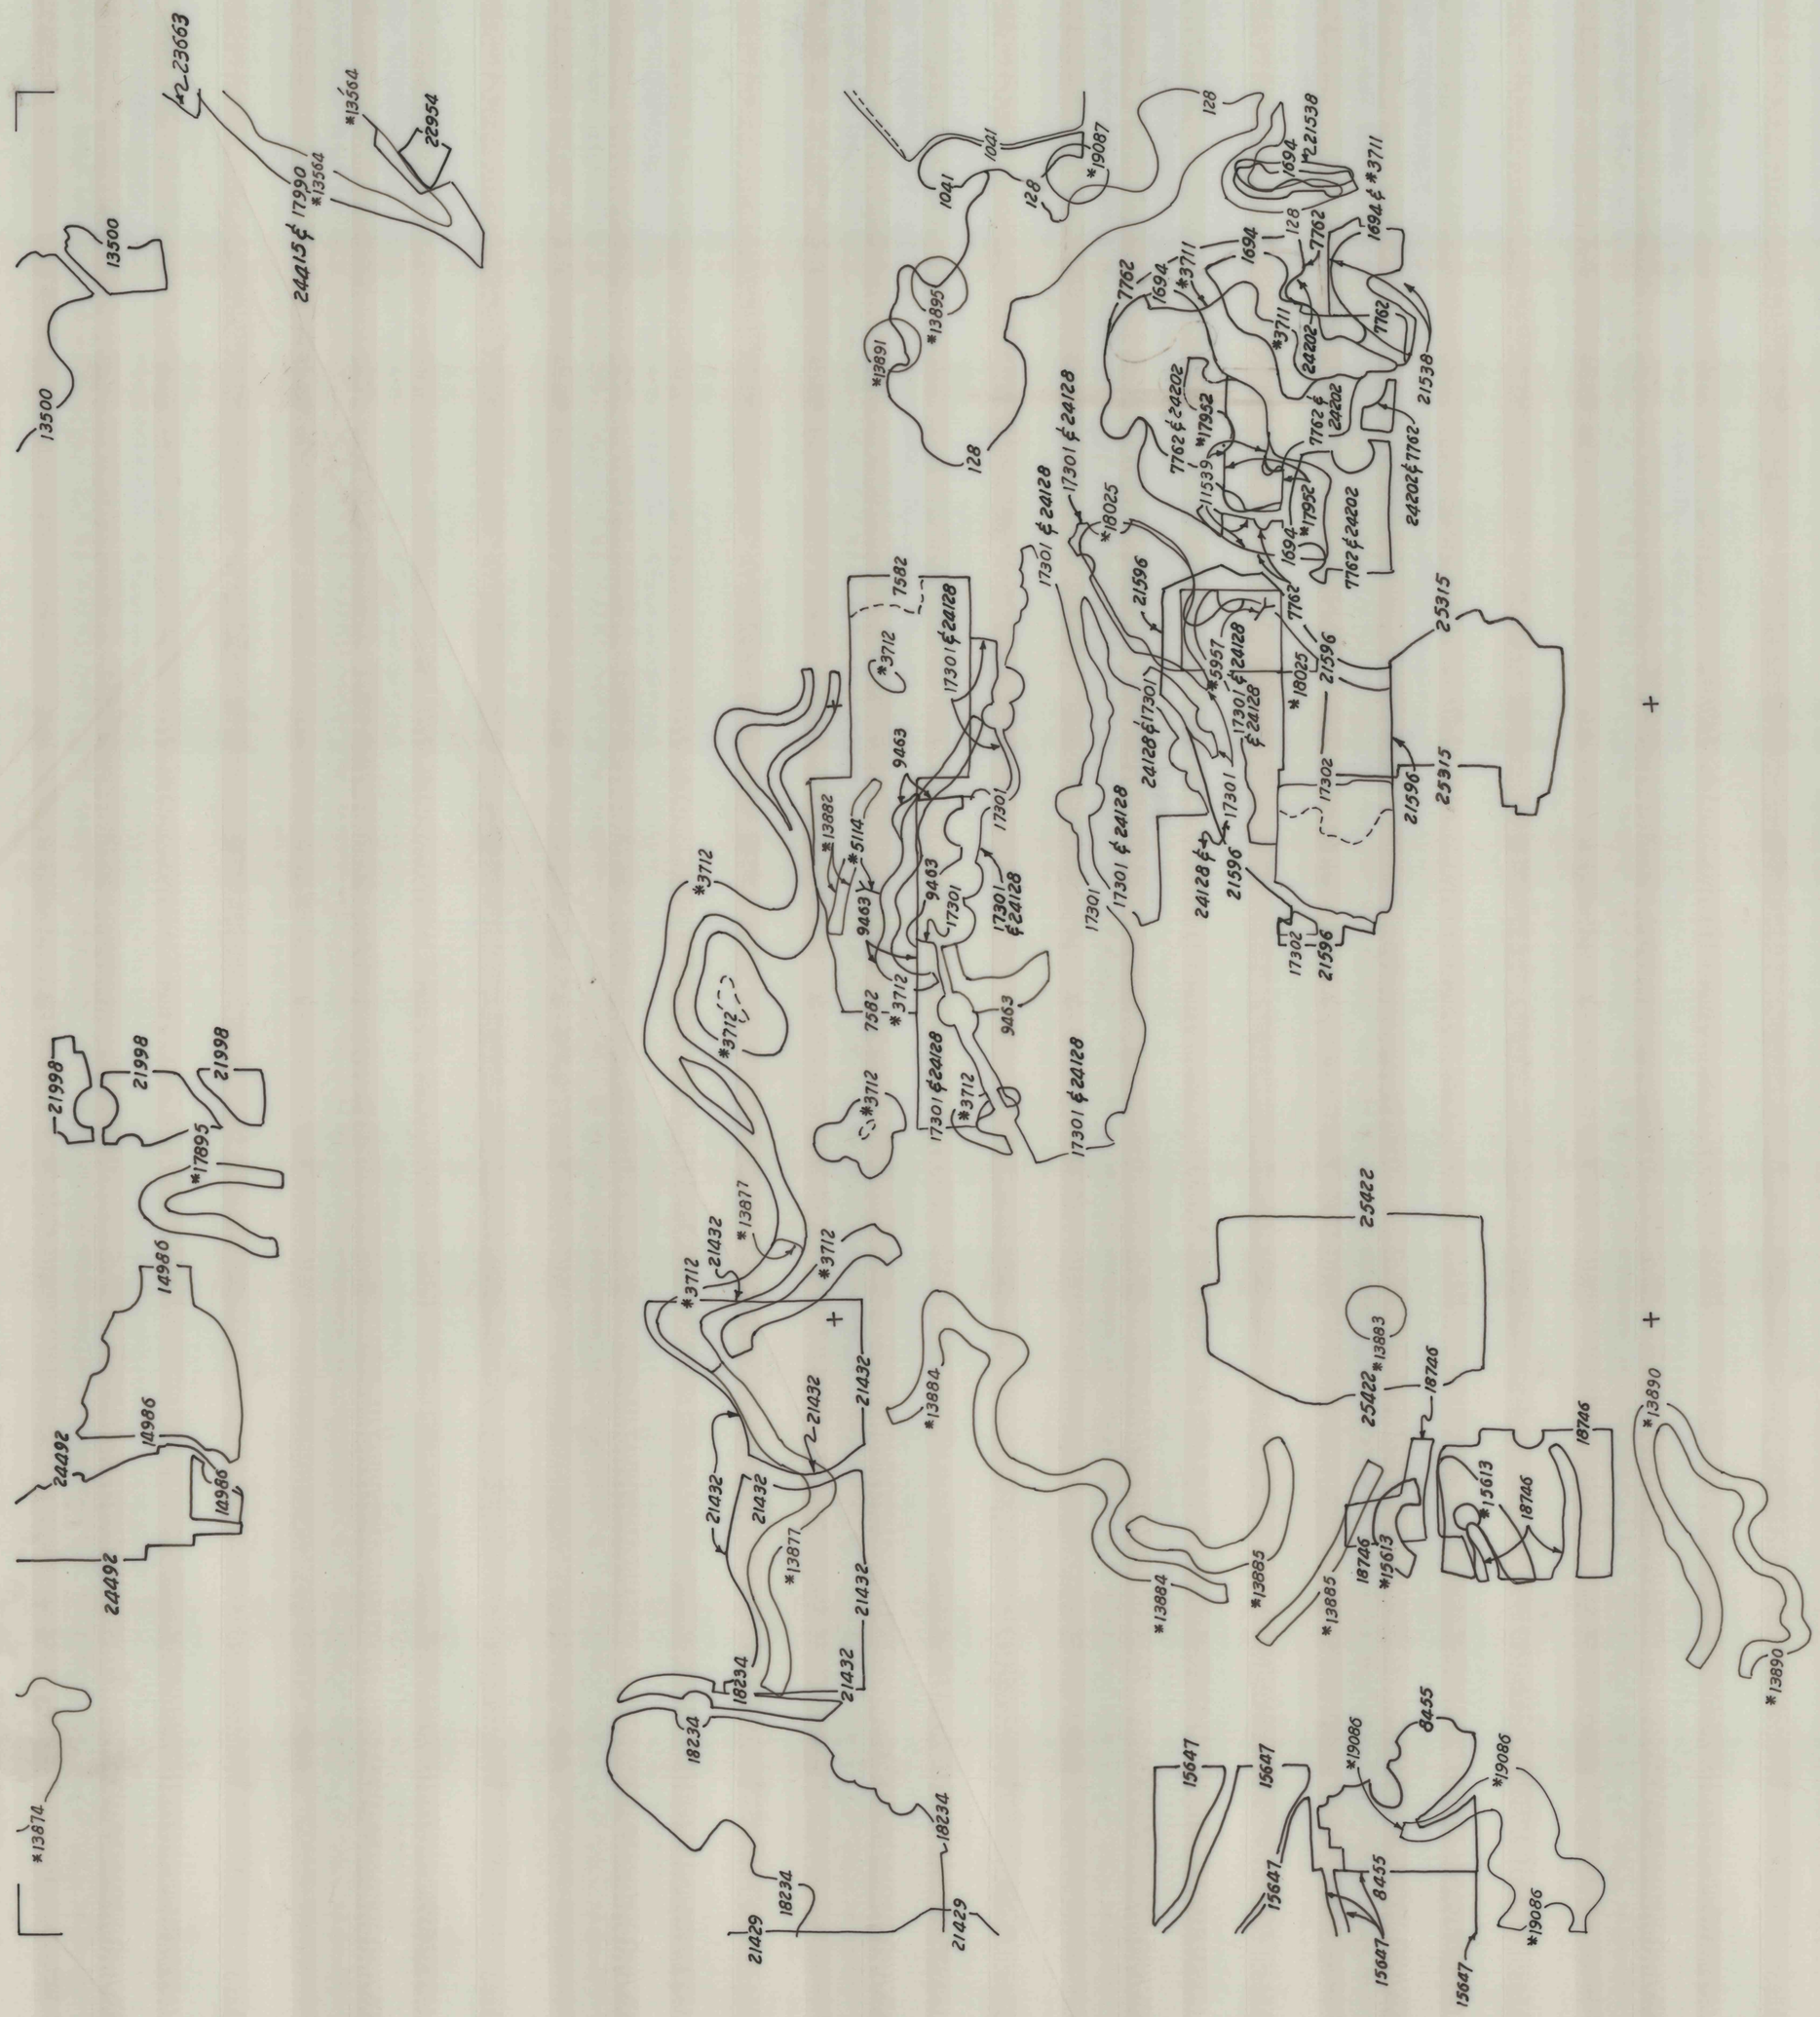
C'/4-8.3 (Sheet 1 of 2)
1014