



PLAN HOLD


PEEL PROTECTIVE STRIP TO EXPOSE ADHESIVE. POSITION EDGE OF PRINT ON THIS LINE AND RUB TO ADHERE.

PLAN HOLD CORPORATION IRVINE CALIFORNIA  
REORDER BY NO. 0705X24

DRAWING NUMBER  
**WS/4-8.3**

1014

3380410101301

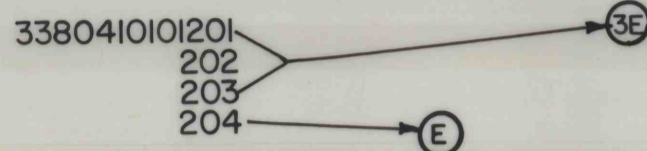

3393410101201 ? loc

WS/4-8.3  
1014

4083

REYNOLDSVILLE