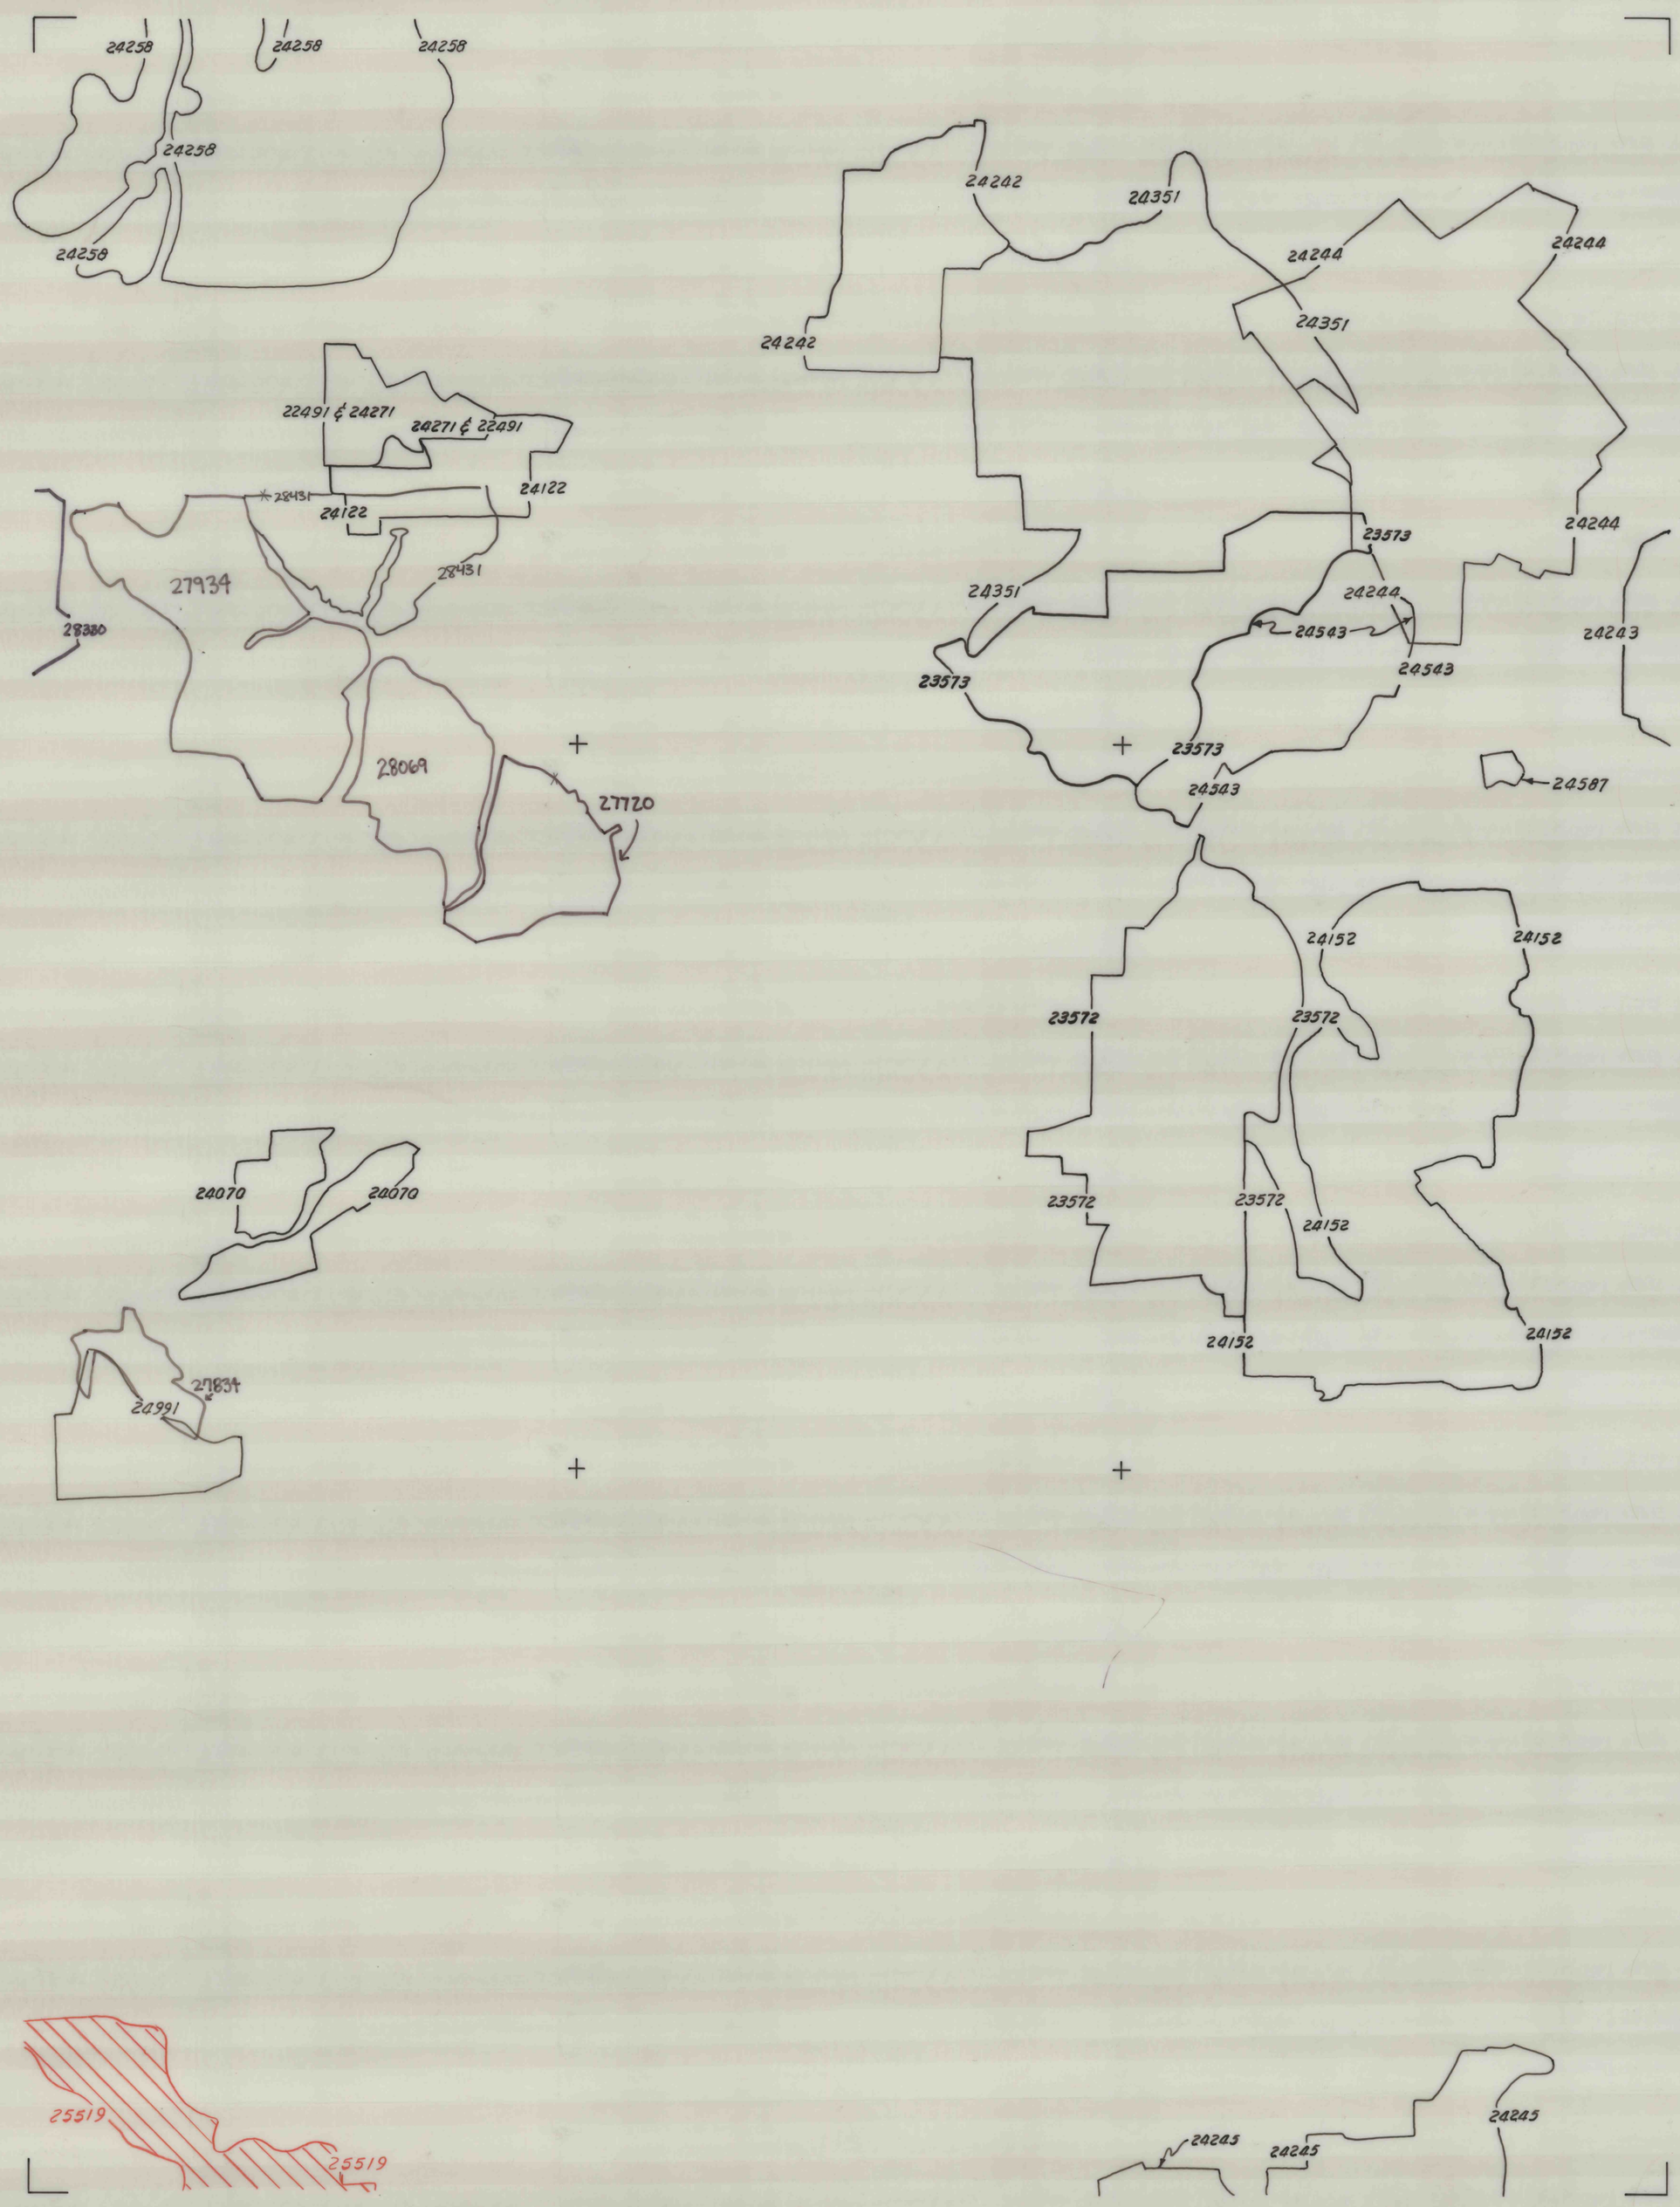

B/4-5.2 (Sheet 2 of 2)
1009
COAL 107

DRAWING NUMBER
B/4-5.2
1009
COAL 107

DRAWING NUMBER

DRAWING NUMBER