



+

+

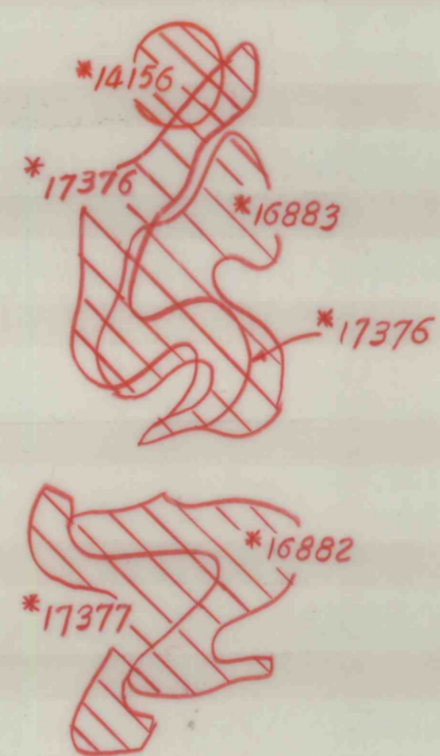

+

+

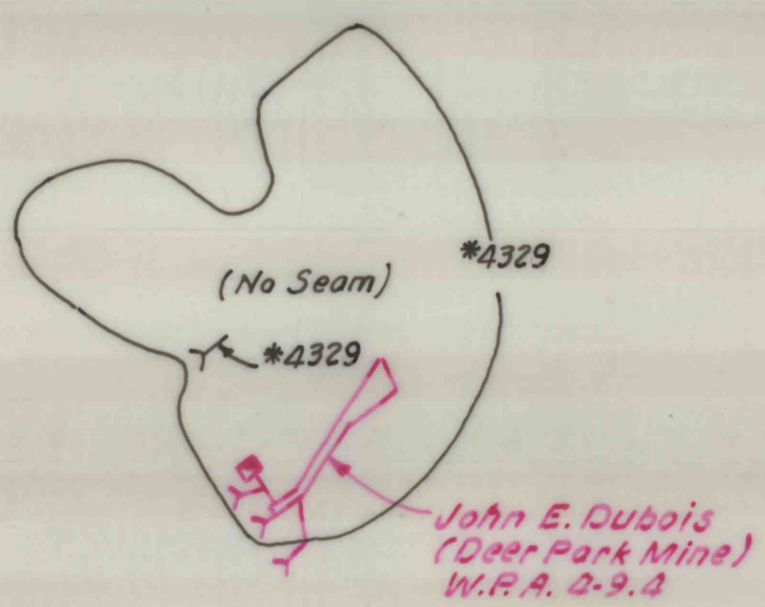

E/4-9.4  
0916