



PLAN HOLD

PEEL PROTECTIVE STRIP TO EXPOSE ADHESIVE. POSITION EDGE OF PRINT ON THE LINE AND RUB TO ADHERE.











PLAN HOLD CORPORATION IRVINE, CALIFORNIA
REPORT BY NO. 0755A-24

DRAWING NUMBER
MISC./3-21.4

0740

NONCOAL

MISC./3-21.4 (Sheet 1 of 2)
COAL REFUSE BANK
CINDERS & FINE COAL
CINDERS & ASHES
0740

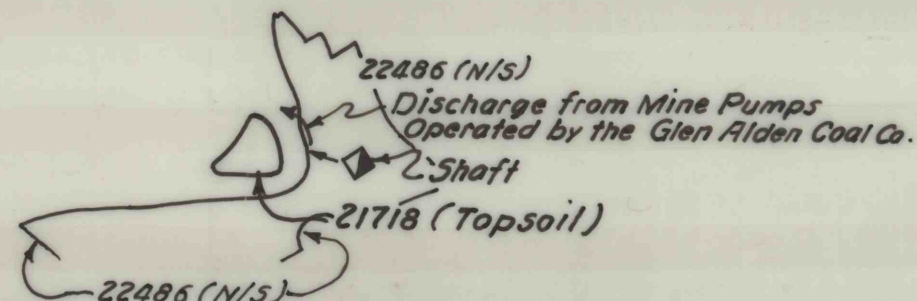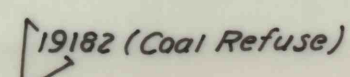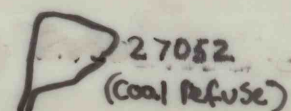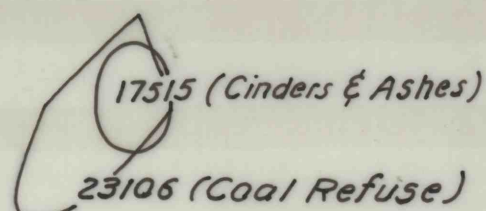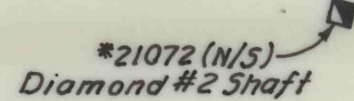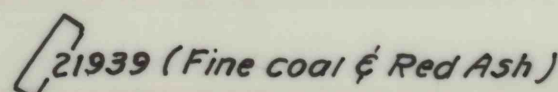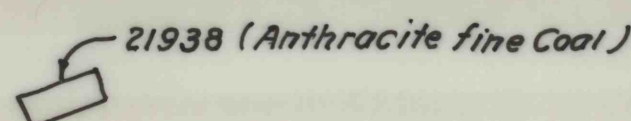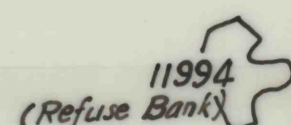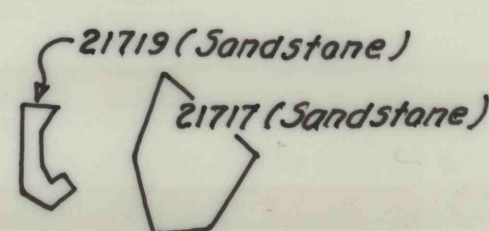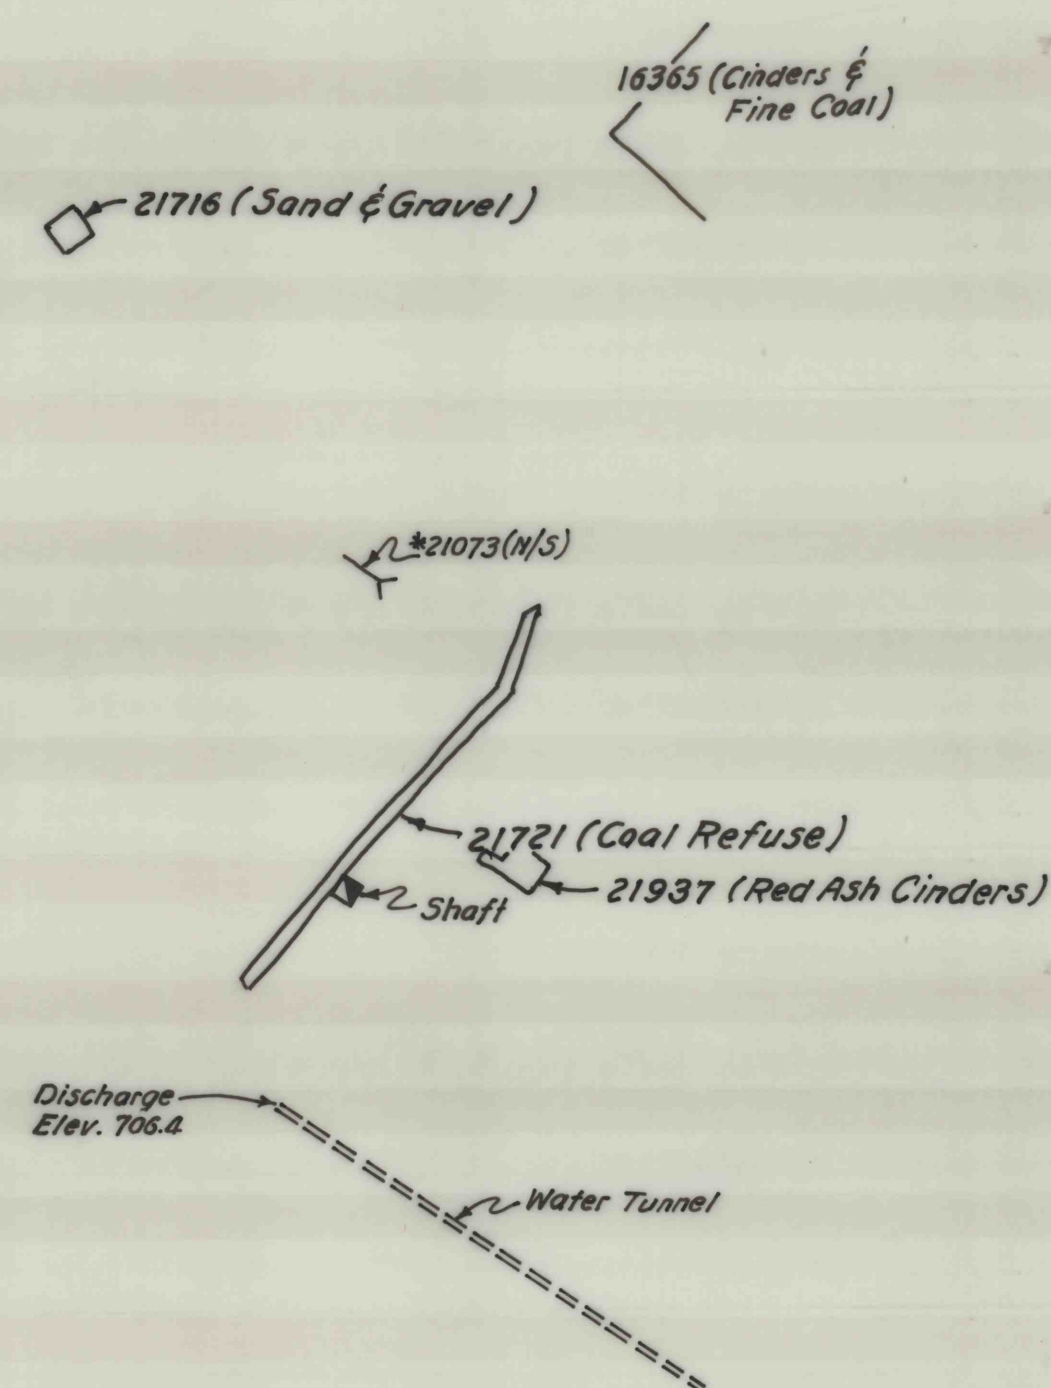

Shaft shown on this sheet is from a 1952 Hudson Coal Co. Engineering Department Report.