
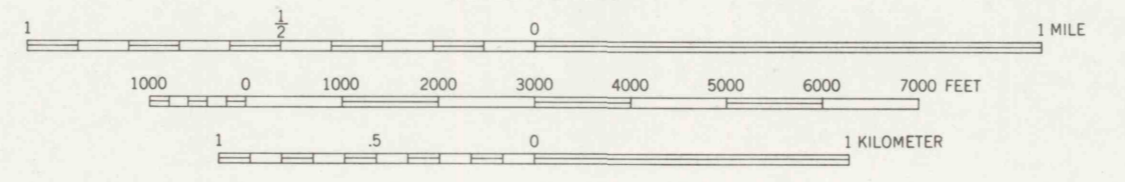



41°15' N

390 000 FEET
380 000 FEET
Mapped, edited, and published by the Geological Survey
Control by USGS and USC&GS
Topography by plane-table surveys 1944, Revised 1954
Polyconic projection, 1927 North American datum
10,000-foot grid based on Pennsylvania coordinate system,
north zone
1000-meter Universal Transverse Mercator grid ticks,
zone 18, shown in blue
Revisions shown in purple compiled from aerial
photographs taken 1969. This information not
field checked

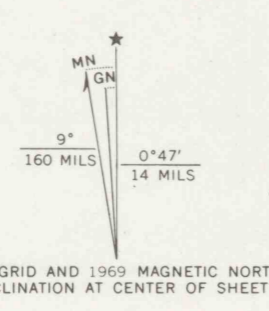

Contour interval 20 feet
Datum is mean sea level

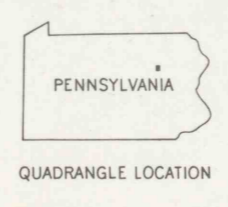

ROAD CLASSIFICATION
Heavy-duty ——— Light-duty ———
Medium-duty ——— Unimproved dirt ———
U. S. Route State Route

SHICKSHINNY, PA.
NW/4 SHICKSHINNY 15' QUADRANGLE
N41075-W76075/75

1954
PHOTOREVISED 1969
AMS 5766 II NW—SERIES V831

Handwritten notes:
H0 Sh cam
Little Shickshinny
ck.
Huntington ck
Source to
Kitchen ck
Kitchen ck
SGV

DRAWING NUMBER

DRAWING NUMBER

DRAWING NUMBER
SPM
4-19.4

Handwritten: 4-19.4