


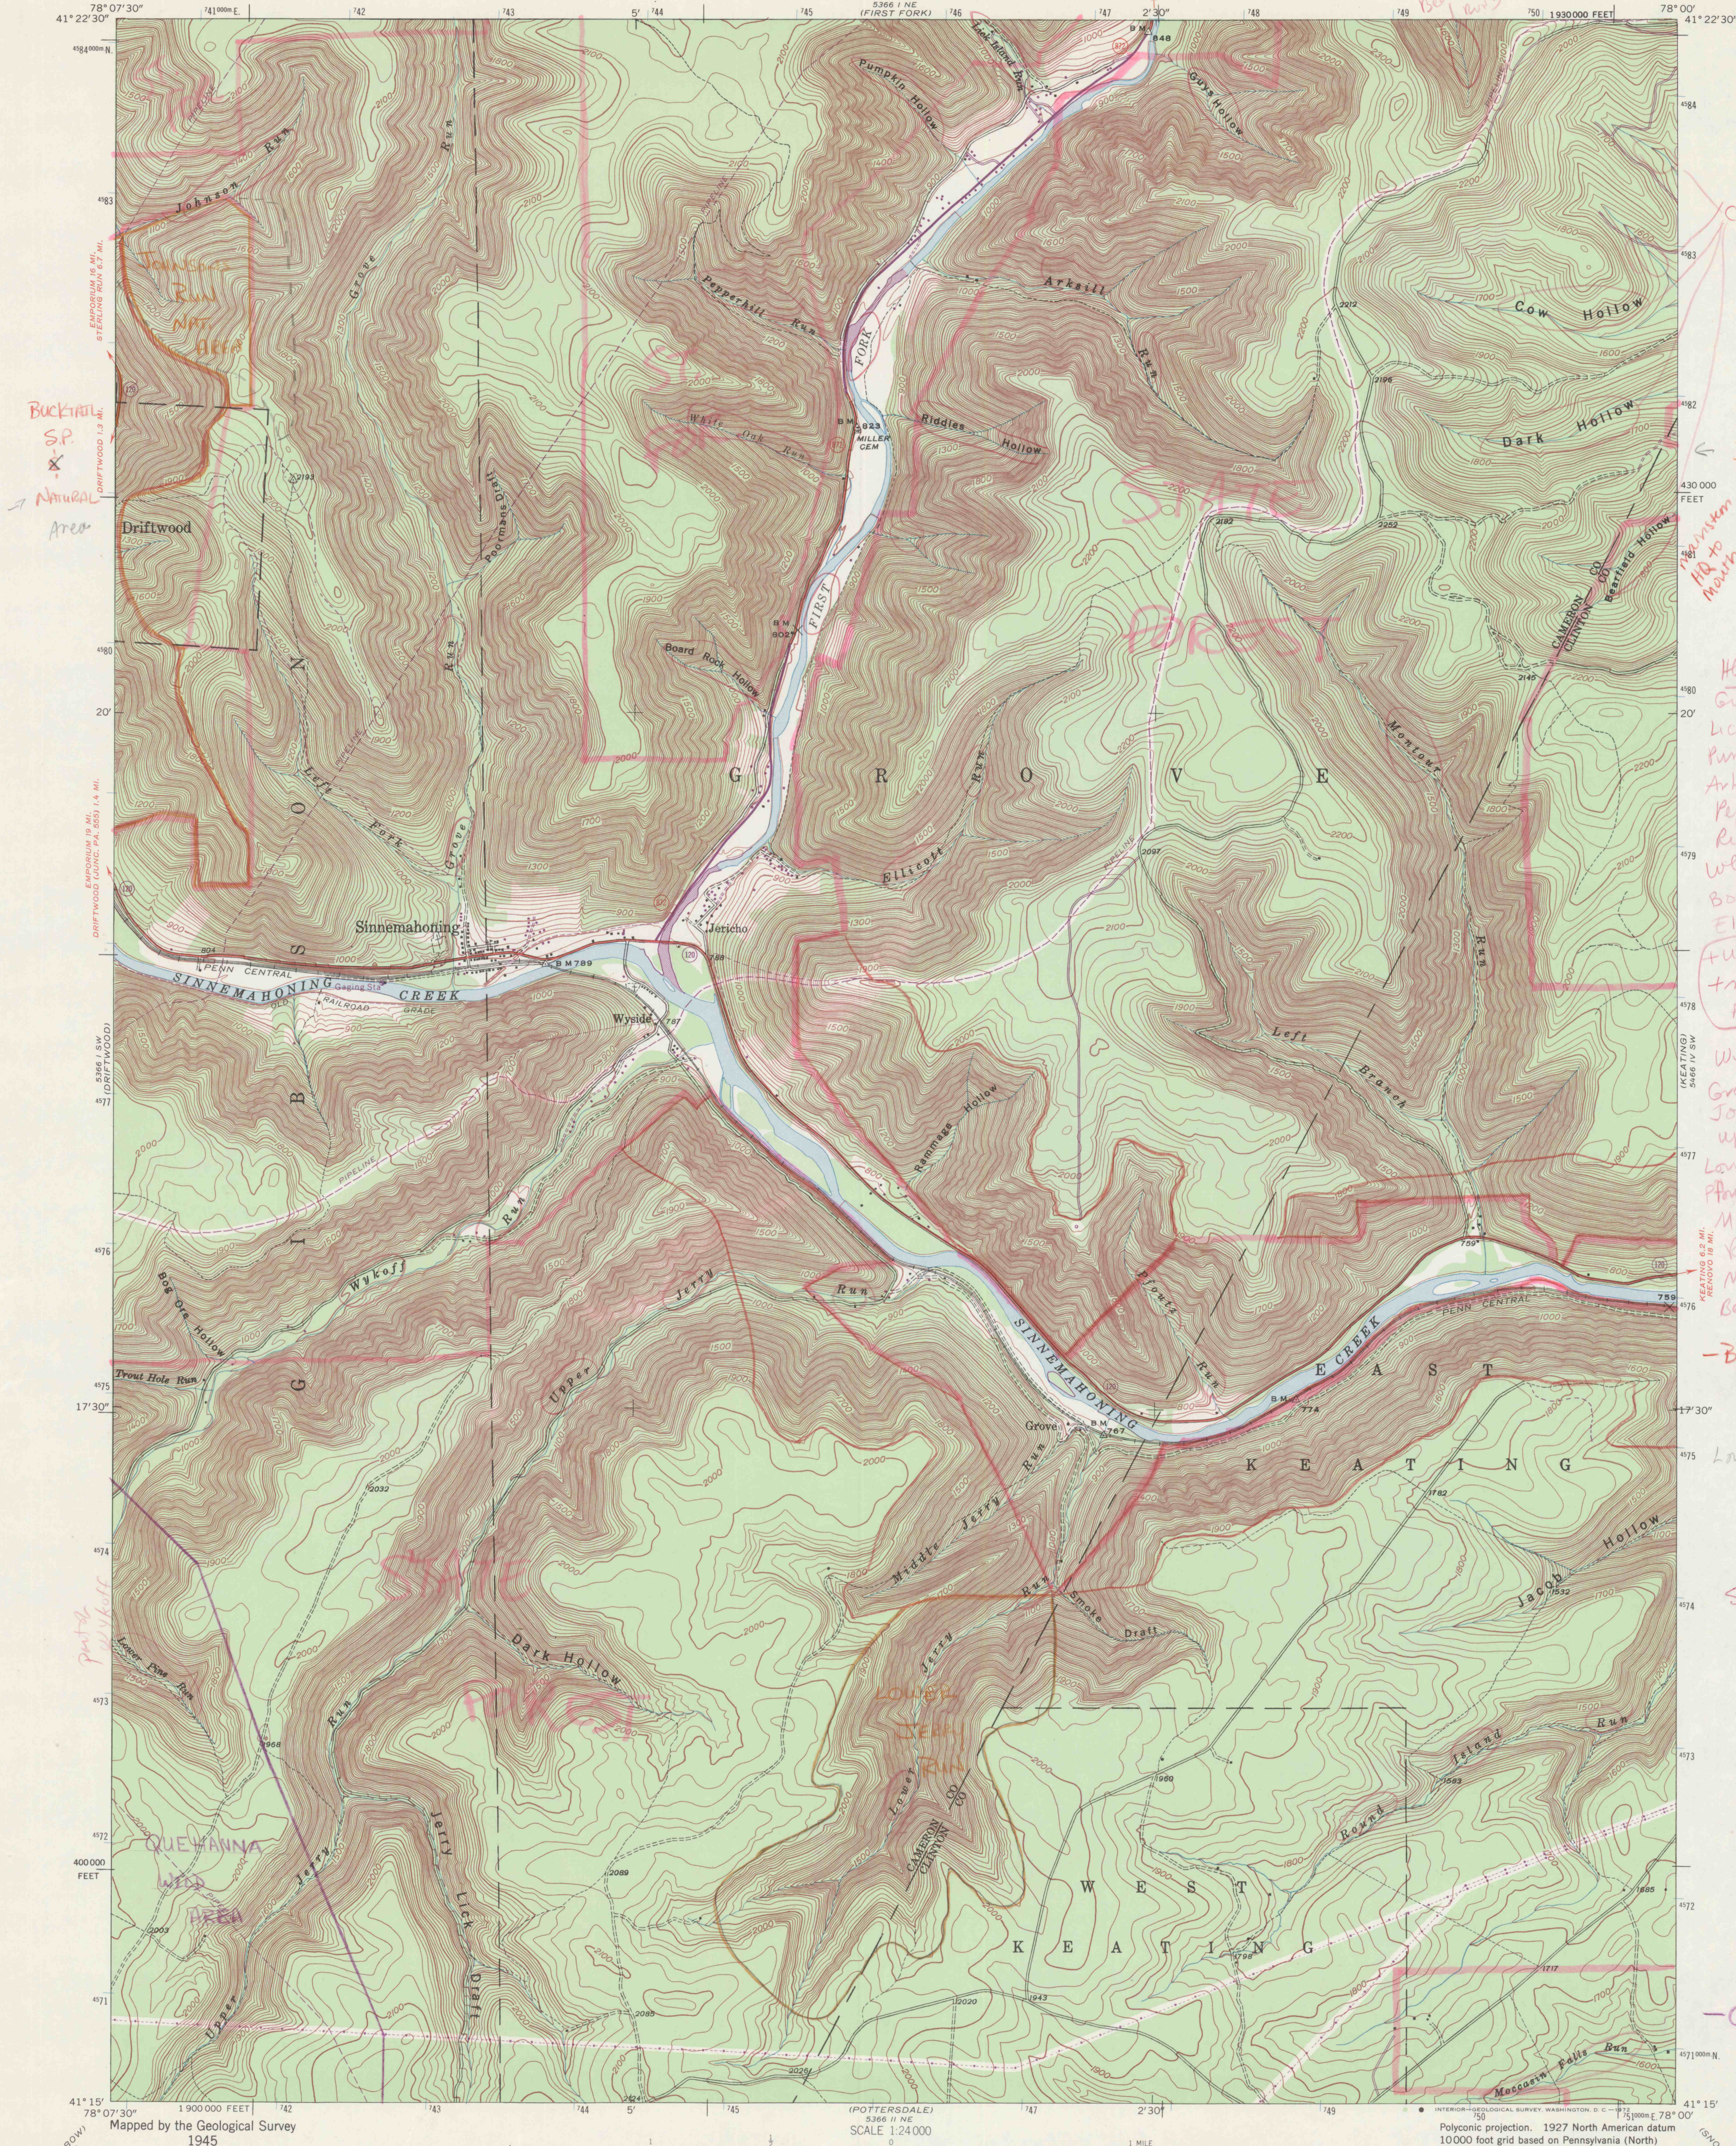

Cocks Run
HQ Basin

JOHNSON RUN
NAT. AREA
Upper
left of
quad

HQ stream
Guys Hollow
Lick Jb En
Pumpkin Hollow
Arksill En
Pepperville En
Riddles Hollow
White oak En
Board Rock Hollow
Ellicott En
+UNTS to First Fk
+main stem
First Fk

Wykoff En
Grove En
Johnson En
upper Jerry En
Lower Jerry En
Pflantz En
Montau En
Round Oak En
Moccasin Falls En
Beason Run B

BUCKTAIL S.P.
NAT. AREA

Lower Jerry Run
Natural Area

State
Forest

QUEHANNA
WILD
AREA

3-11-2

DRAWING NUMBER

DRAWING NUMBER

DRAWING NUMBER

SAM/3-11-2

ROAD CLASSIFICATION

Heavy-duty — 4 LANE 16 LANE Light-duty —
Medium-duty — 4 LANE 16 LANE Unimproved dirt
U.S. Route State Route

UTM GRID AND 1971 MAGNETIC NORTH
DECLINATION AT CENTER OF SHEET

SCALE 1:24,000

CONTOUR INTERVAL 20 FEET
DATUM IS MEAN SEA LEVEL

PENNSYLVANIA
QUADRANGLE LOCATION

Revisions shown in purple compiled in cooperation with State of
Pennsylvania agencies from aerial photographs taken 1971. This
information not field checked

SINNEMAHONING, PA.
SE 4 DRIFTWOOD 15' QUADRANGLE
N 4115—W 7800/7.5

1945
PLATE REVISED 1971
AMS 5566 1 SE—SERIES V 831