

UNITED STATES
DEPARTMENT OF THE INTERIOR
GEOLOGICAL SURVEY

SKYTOP QUADRANGLE
PENNSYLVANIA
7.5 MINUTE SERIES (TOPOGRAPHIC)

stream Update
Aug. 21, 1997

HQ-CWF
Mill Creek Basin
Goose Pond Run
Leavitt Branch B.
Bush Kill Creek Basin

EV Spruce Cabin Rn
basin
Stony Run

Pennell R
PENNELL RUN
NATA AREA

02027

Geol Feature
Indian Ladder Falls sec
High Falls sec 3
Spruce Cabin Falls sec
Leavitt Falls sec 1
Round Hole sec 3

HQ
Brookhead Ck.
EV
Stony Run

Snow Hill
SF Picnic Area
#04036

EV stream
Poplar Run
HQ STREAMS
ALL EXCEPT

DRAWING NUMBER




DRAWING NUMBER

DRAWING NUMBER
SAM 4-23.4

DRAWING NUMBER



Maped, edited, and published by the Geological Survey
Control by USGS and USC&GS
Topography by photogrammetric methods from aerial photographs
Field checked 1943
Polyconic projection, 1927 North American datum
10,000-foot grid based on Pennsylvania coordinate system, north zone
1000-meter Universal Transverse Mercator grid ticks,
zone 18, shown in blue
Revisions shown in purple compiled in cooperation with
State of Pennsylvania agencies, from aerial photographs taken 1968
This information not field checked

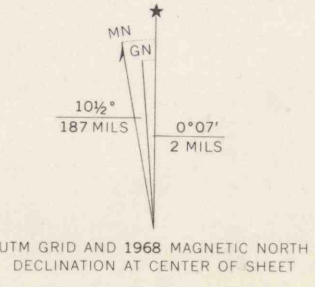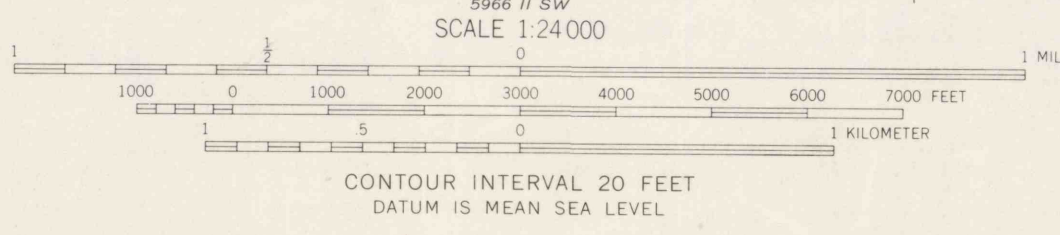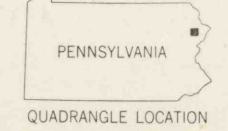

ROAD CLASSIFICATION
Medium-duty ——— Light-duty ———
Unimproved dirt ———
State Route ———

SKYTOP, PA.
N4107.5—W7507.5/7.5

1943
PHOTOREVISED 1968
AMS 5966 II NW—SERIES V631