

PEEL PROTECTIVE STRIP TO EXPOSE ADHESIVE. POSITION EDGE OF PRINT ON THIS LINE AND RUB TO ADHERE.



PLAN HOLD CORPORATION - TORRANCE - CALIFORNIA
REORDER BY NO. 07934-24

DRAWING NUMBER
A/4-6-1

1160

COAL 104

A/4-6-1 (Sheet 1 of 2)
0911

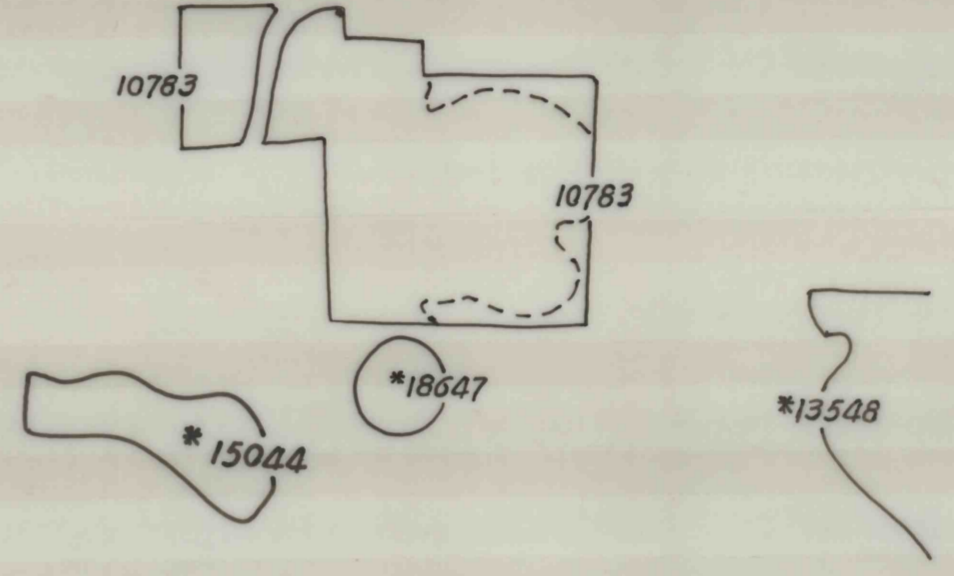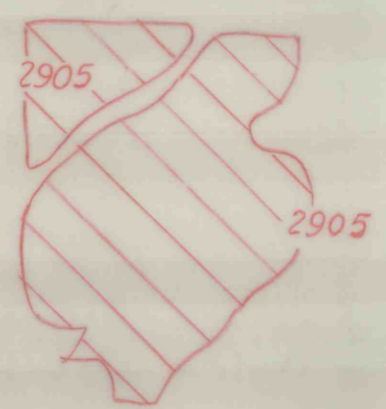

*Strattonville Coal Co.
(Strattonville Mine)
W.P.A. 2-5-3*

