PLAN HOLD

PEEL PROTECTIVE STRIP TO EXPOSE ADHESIVE. POSITION EDGE OF PRINT ON THIS LINE AND RUB TO ADHERE.

PLAN HOLD CORPORATION · TORRANCE · CALIFORNIA
REORDER BY NO. 070SA-24

DRAWING NUMBER
A'14-6.1

0911

COAL 105
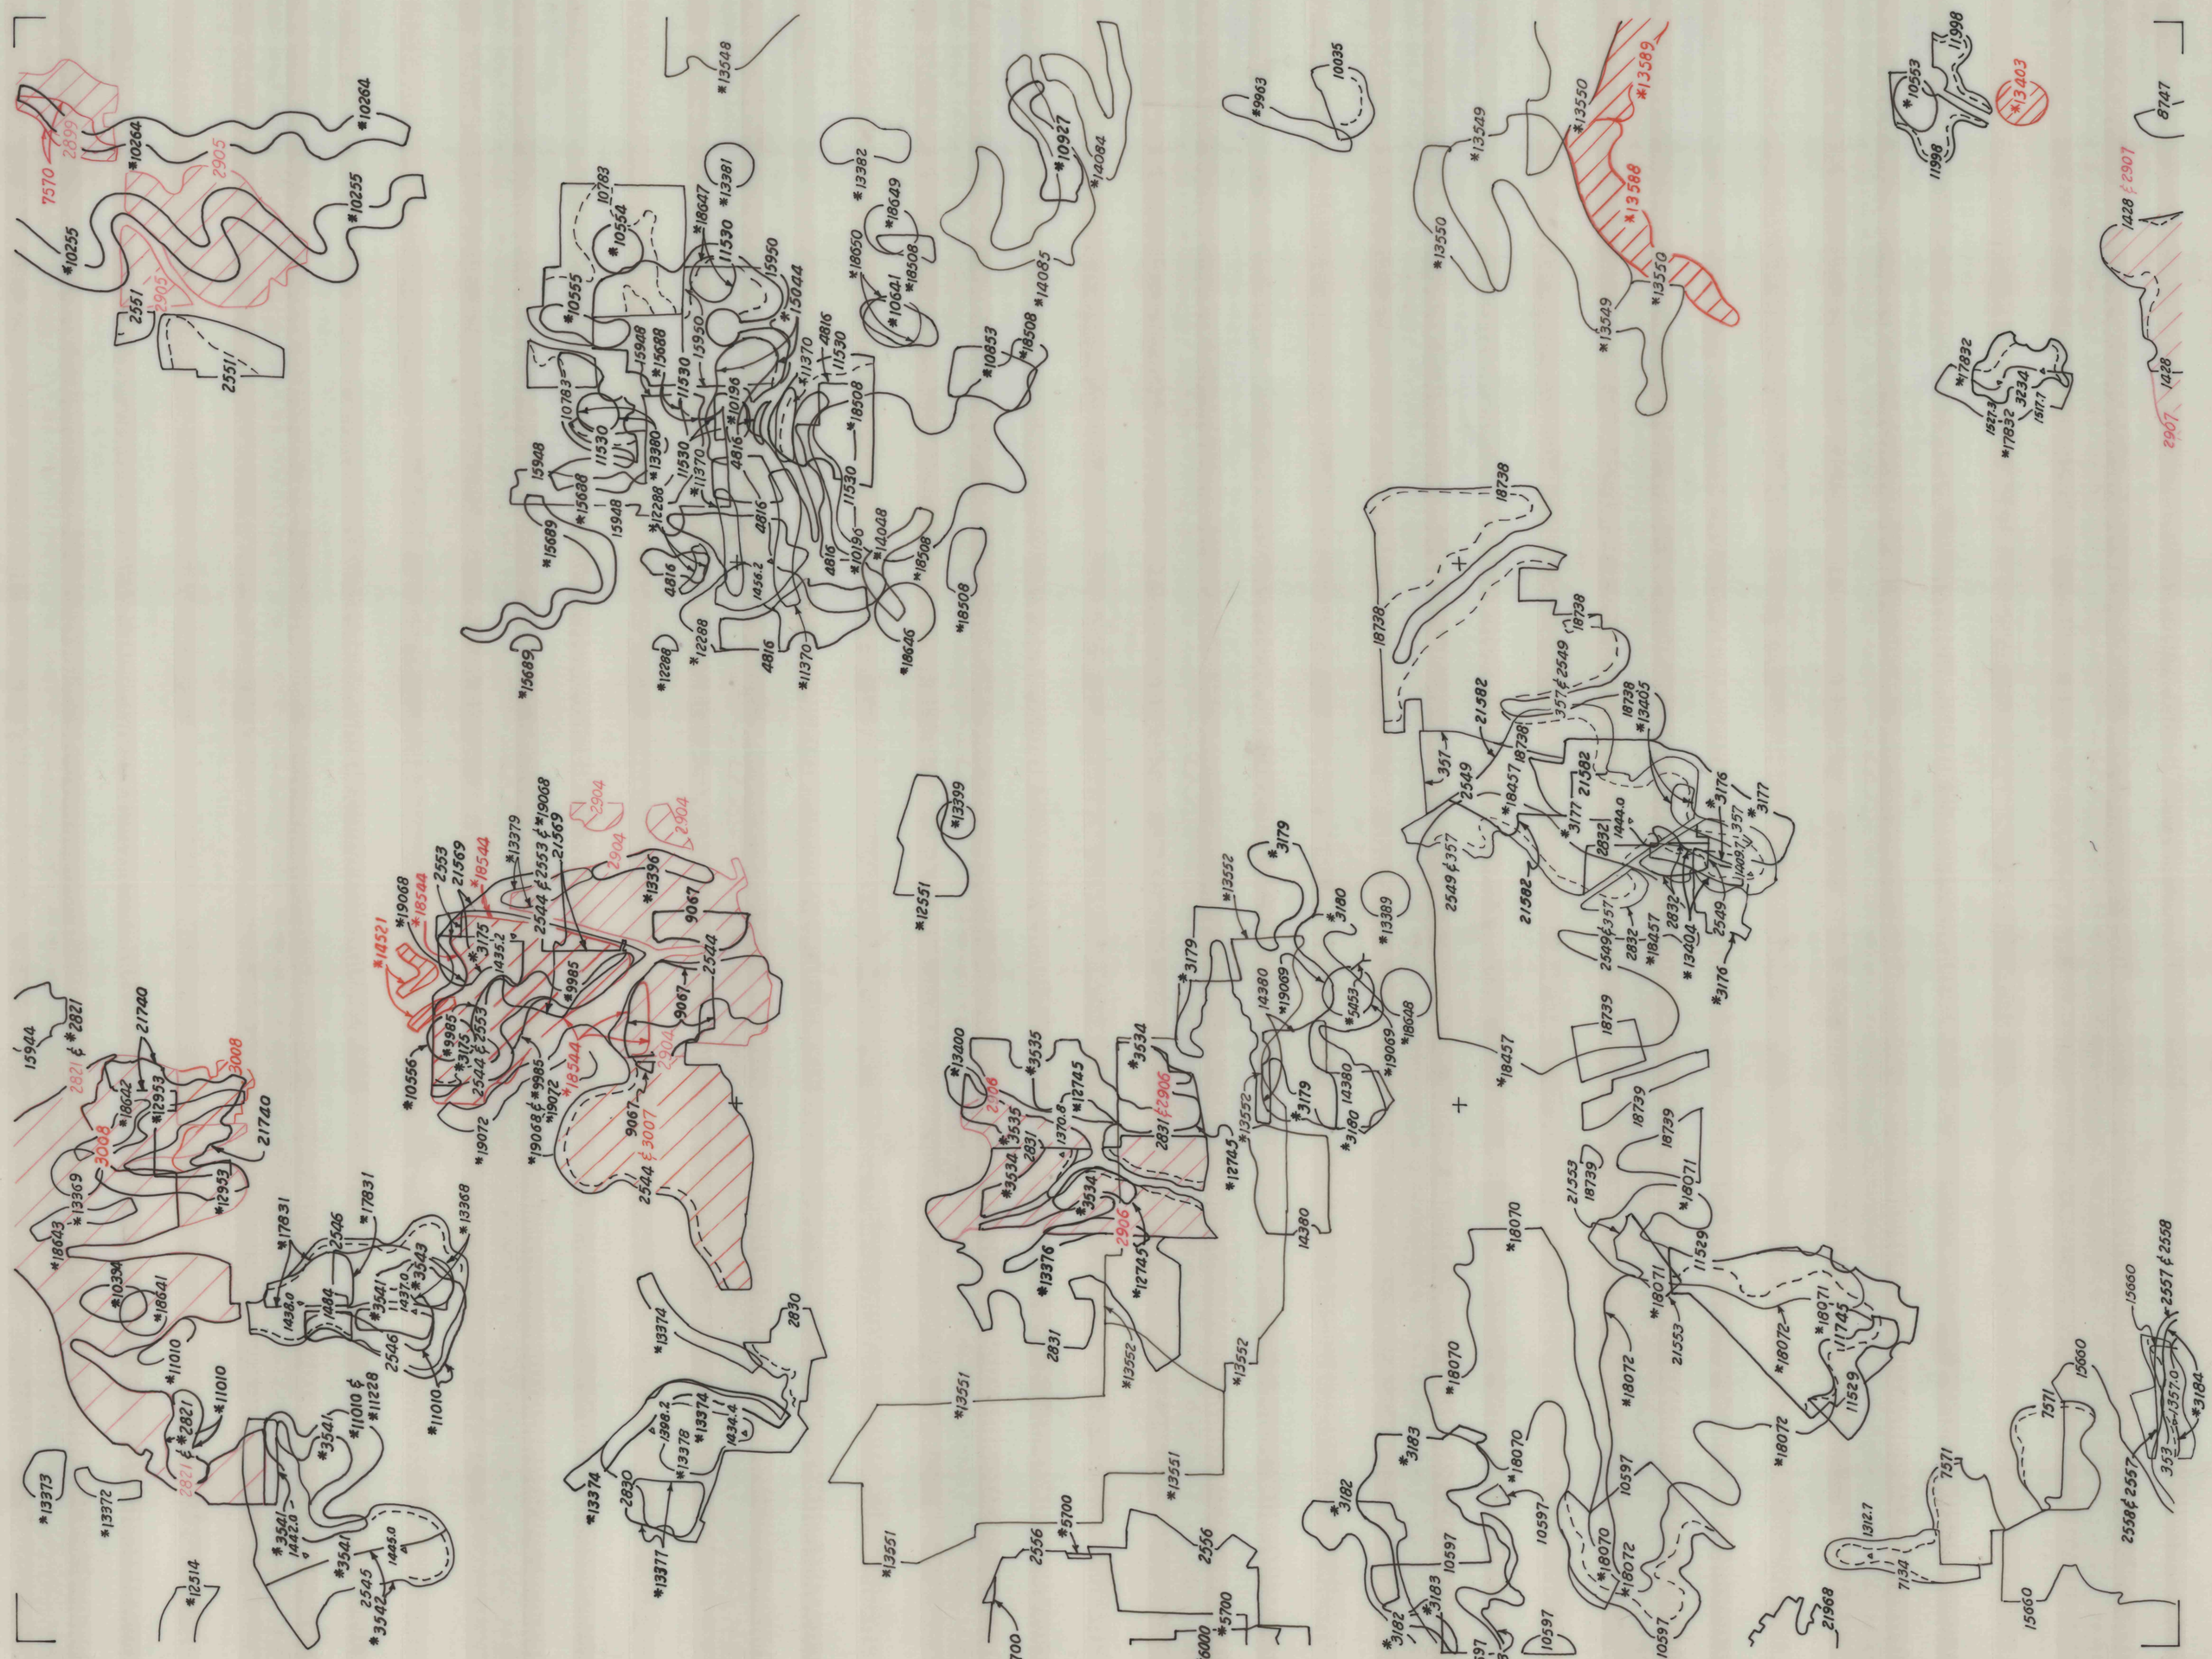
A'14-6.1 (Sheet 1 of 2)
0911