PLAN HOLD

PEEL PROTECTIVE STRIP TO EXPOSE ADHESIVE. POSITION EDGE OF PRINT ON THIS LINE AND RUB TO ADHERE.

DRAWING NUMBER

C'/4-6.1

0911

PLAN HOLD CORPORATION · TORRANCE · CALIFORNIA

REORDER BY NO. 070SA-24

COAL 109

C'/4-6.1 (Sheet 1 of 2)
0911

*16833
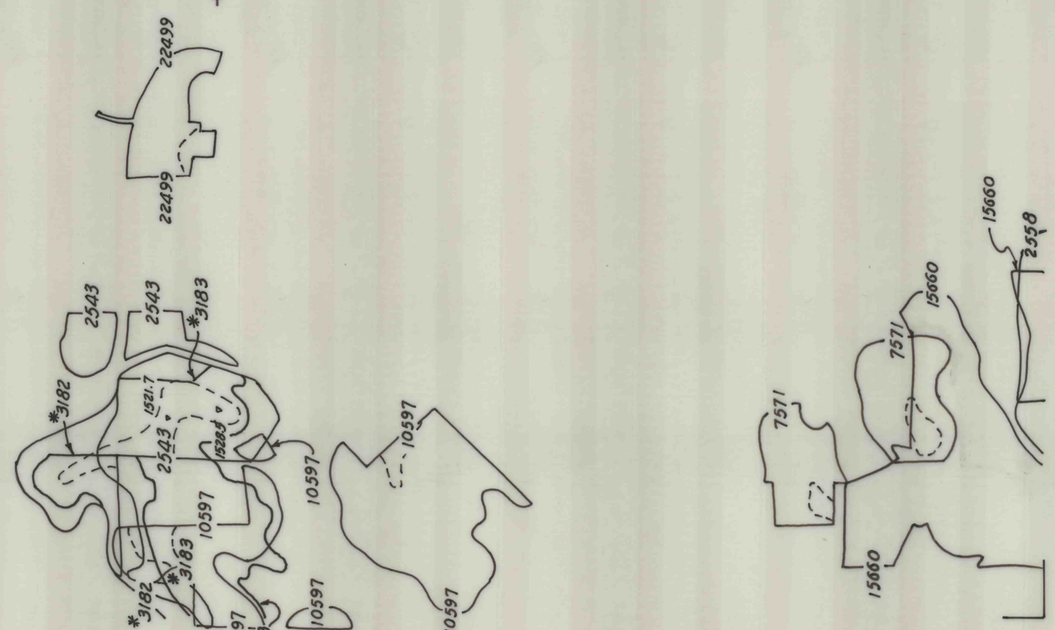
*13394