DRAWING NUMBER

PLAN HOLD CORPORATION • IRVINE, CALIFORNIA

REORDER BY NUMBER 070AR

POSITION EDGE OF PRINT ON THIS LINE

A/4-7.3

1012

COAL104

A/4-7.3
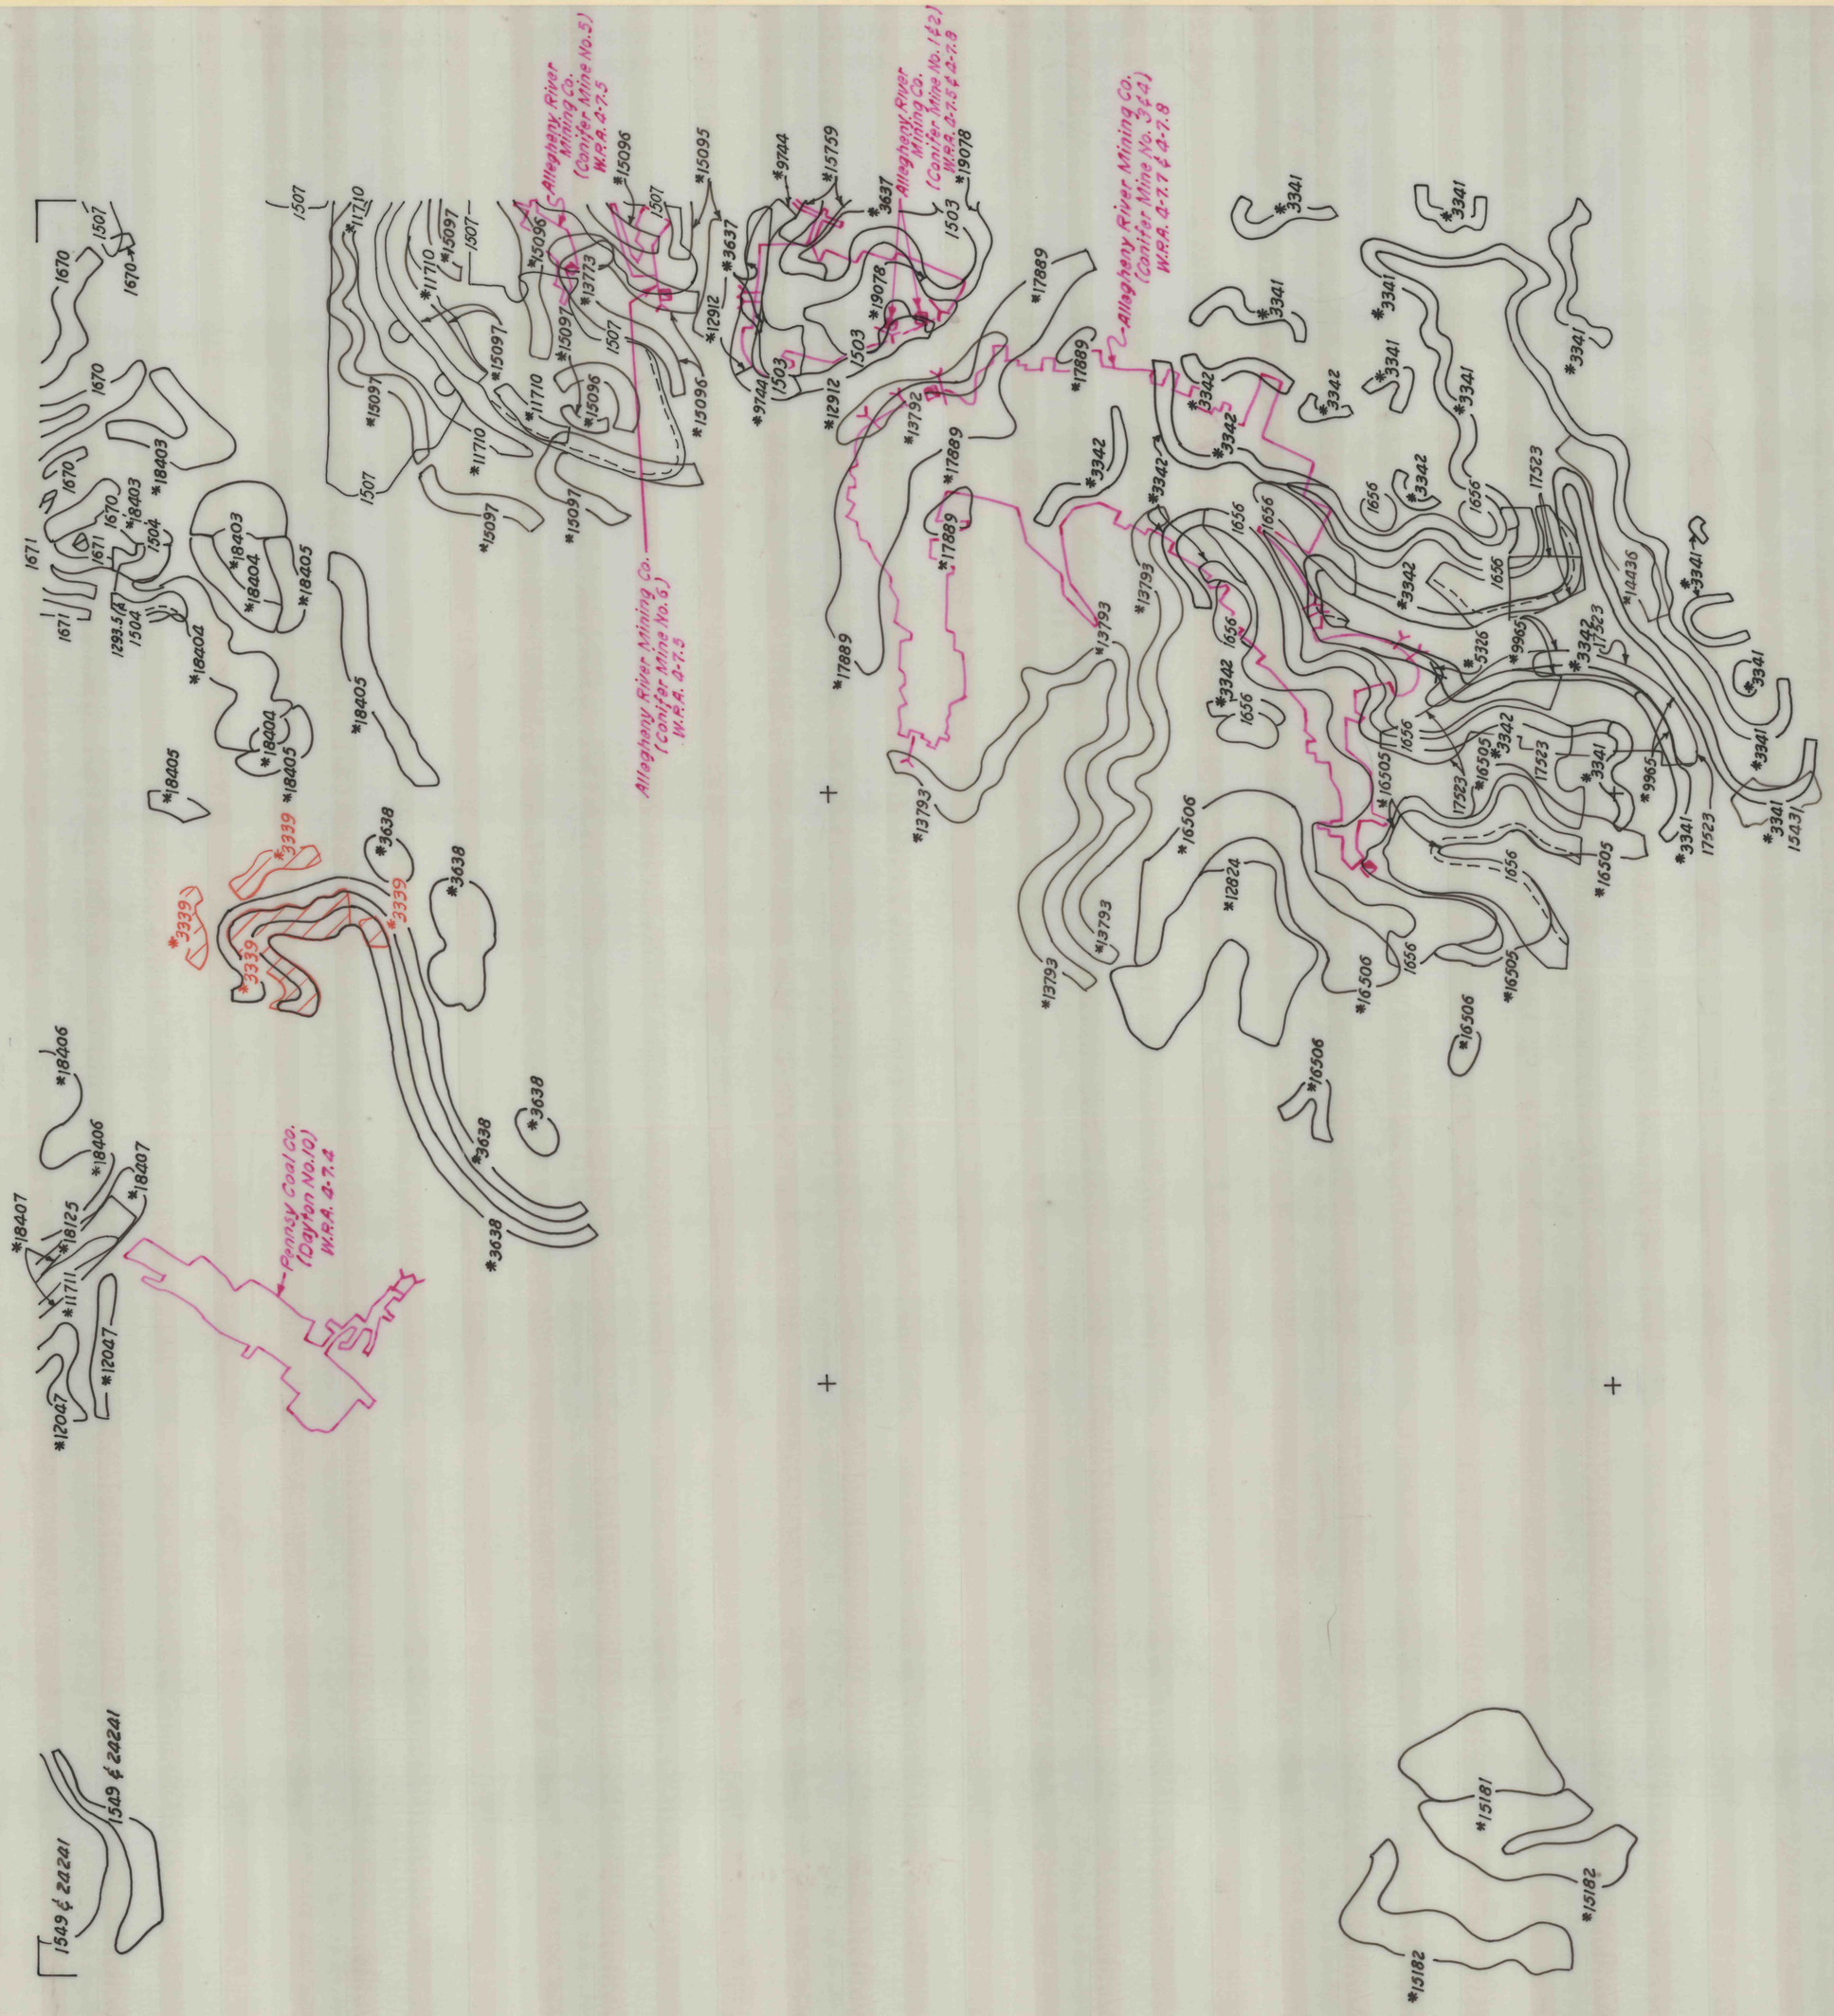
1012