


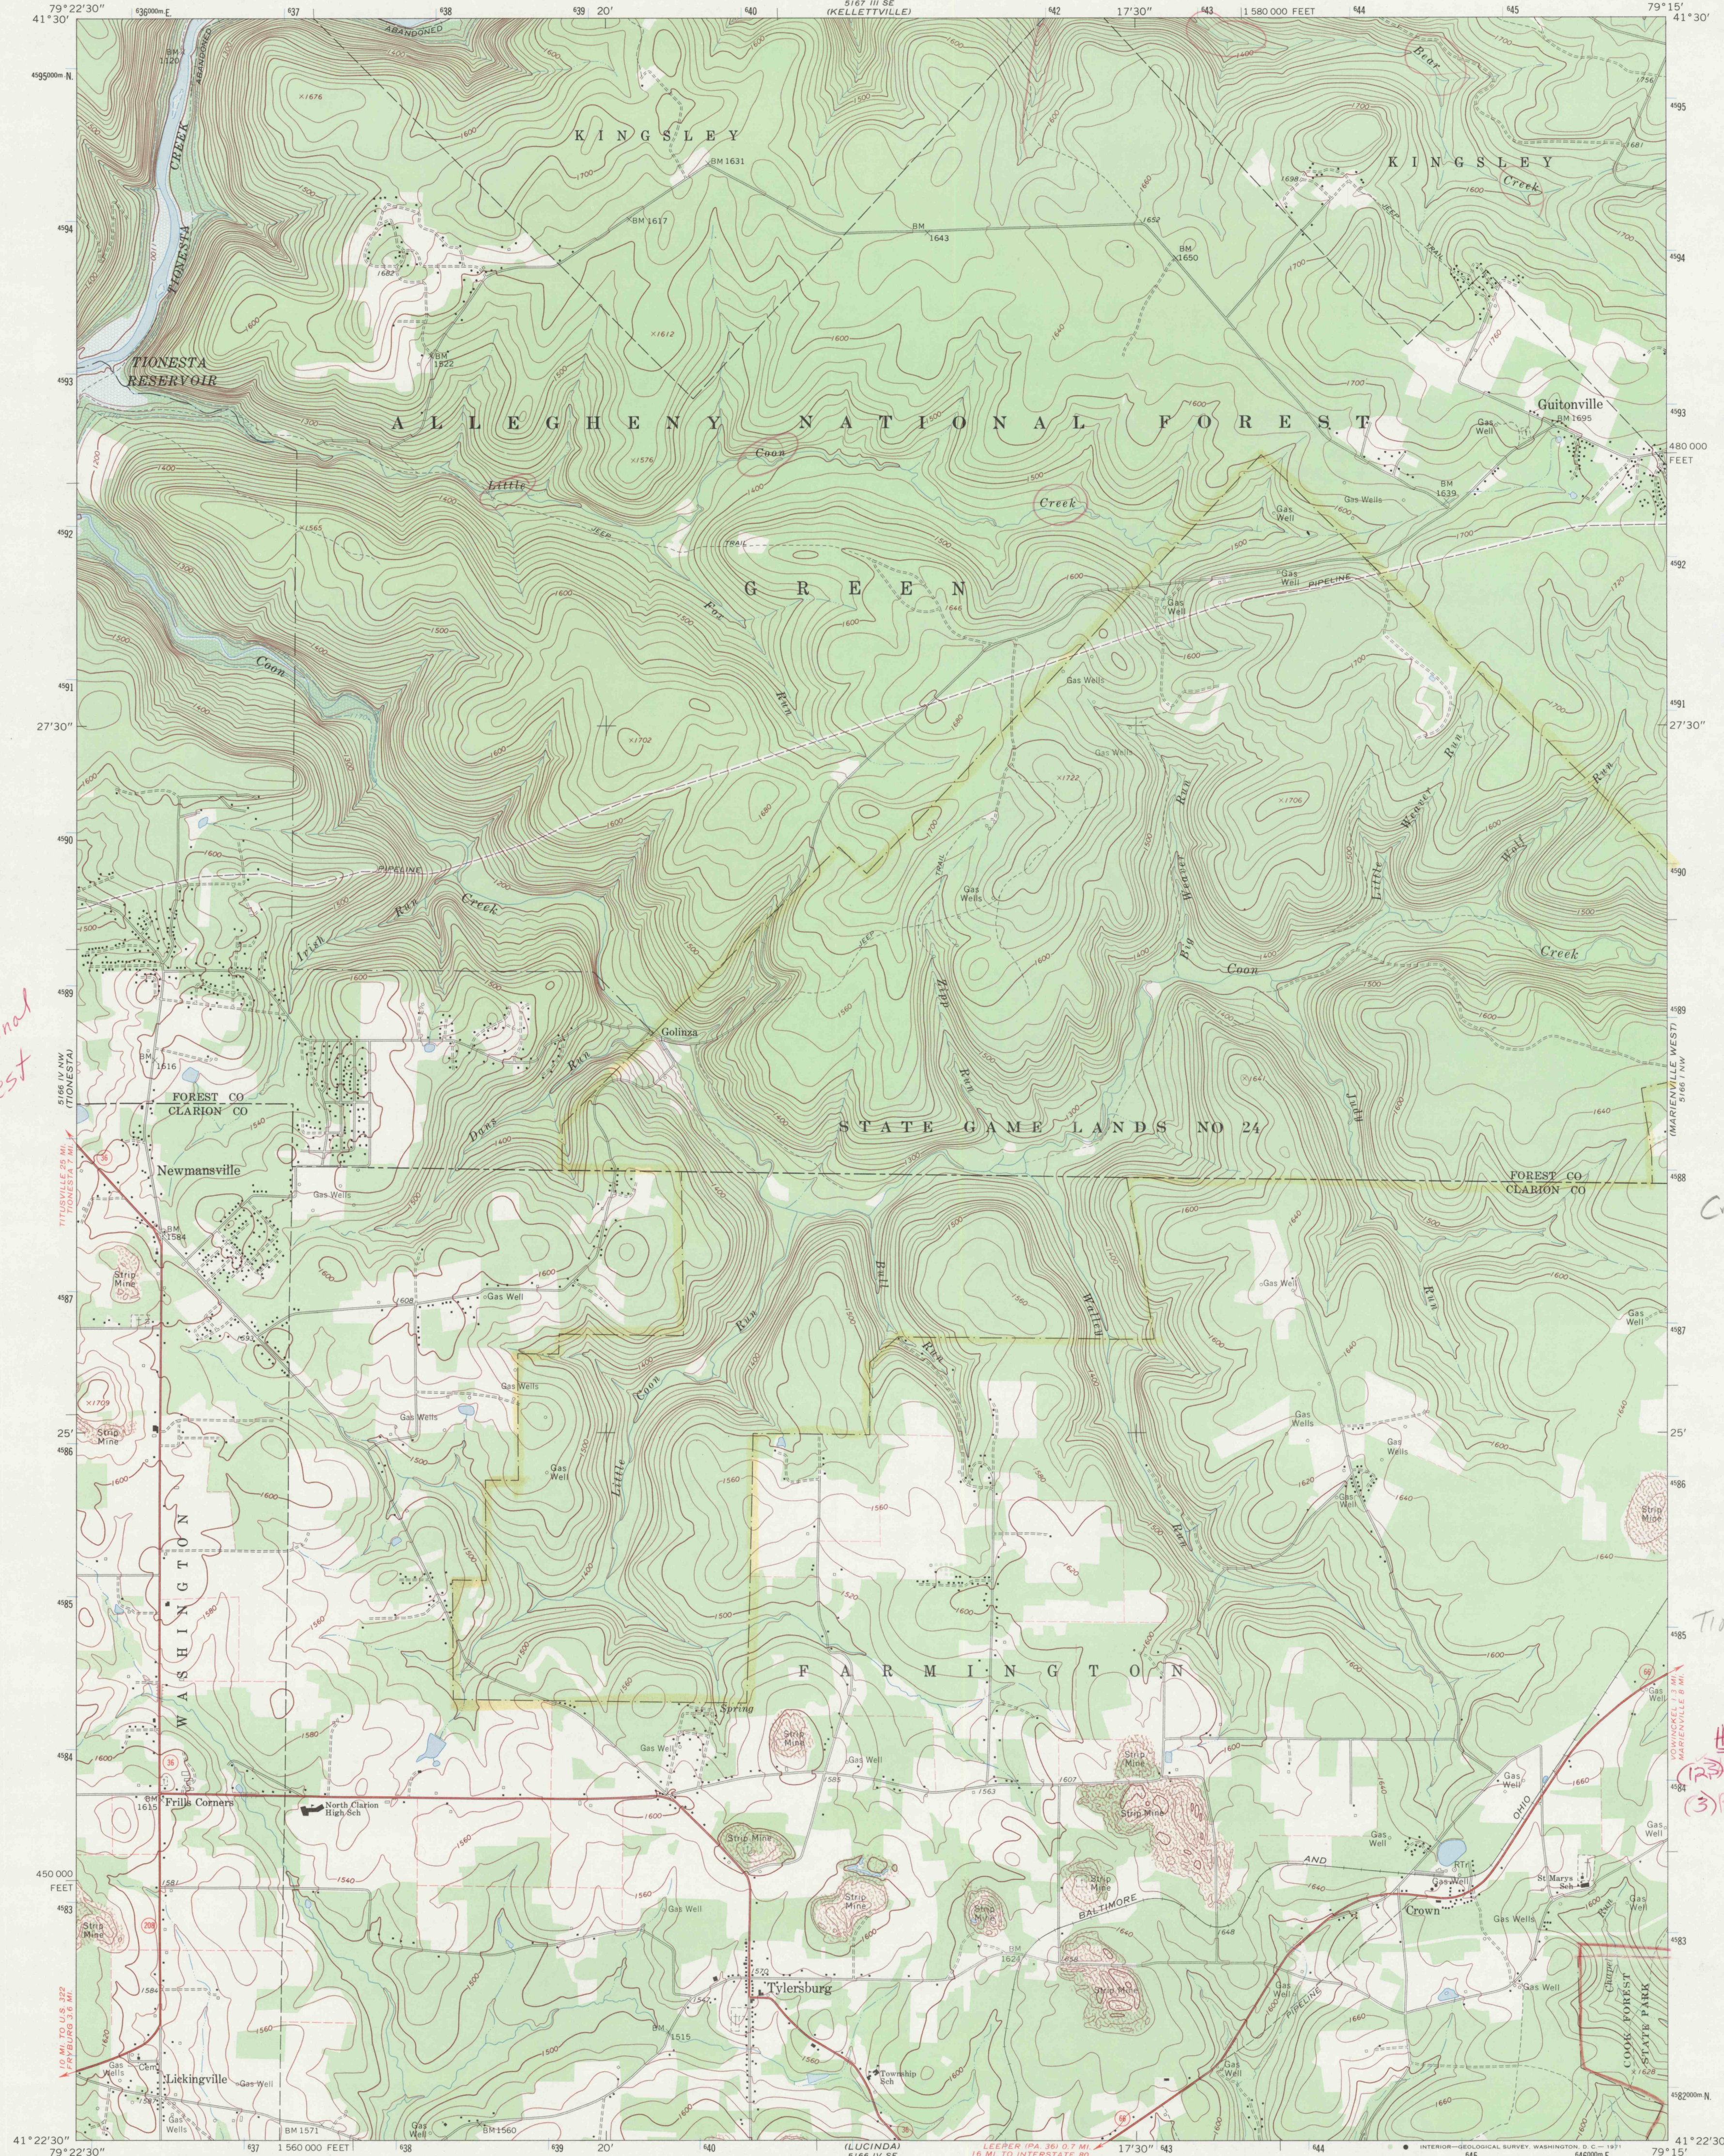


Mapped, edited, and published by the Geological Survey
Control by USGS and USC&GS

Topography by photogrammetric methods from aerial photographs
taken 1967 and 1968. Field checked 1967


Polyconic projection, 1927 North American datum
10,000-foot grid based on Pennsylvania coordinate system, north zone
1000-meter Universal Transverse Mercator grid ticks, zone 17,
shown in blue

Fine red dashed lines indicate selected fence and field lines where
generally visible on aerial photographs. This information is unchecked
Areas covered by dashed light-blue pattern are subject to controlled
inundation

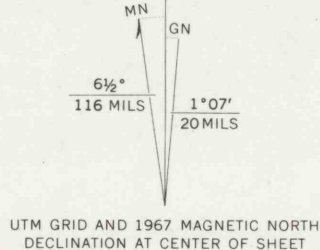

SCALE 1:24,000
CONTOUR INTERVAL 20 FEET
DATUM IS MEAN SEA LEVEL

ROAD CLASSIFICATION
Primary highway, all weather, Light duty road, all weather,
hard surface, improved surface
Unimproved road, fair or dry
weather
State Route

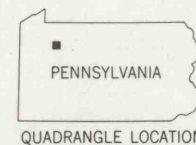

TYLERSBURG, PA.
NE/4 TIONESTA 15' QUADRANGLE
N4122.5-W7915/7.5

1967

AMS 5166 IV NE-SERIES V831

DRAWING NUMBER
PLAN-HOLD CORPORATION • PINE, CALIFORNIA
REORDER NUMBER 07349

DRAWING NUMBER
PLAN-HOLD CORPORATION • PINE, CALIFORNIA
REORDER NUMBER 07349

DRAWING NUMBER
PLAN-HOLD CORPORATION • PINE, CALIFORNIA
REORDER NUMBER 07349

DRAWING NUMBER
PLAN-HOLD CORPORATION • PINE, CALIFORNIA
REORDER NUMBER 07349