


UNITED STATES
DEPARTMENT OF THE INTERIOR
GEOLOGICAL SURVEY

WAYMART QUADRANGLE
PENNSYLVANIA
7.5 MINUTE SERIES (TOPOGRAPHIC)

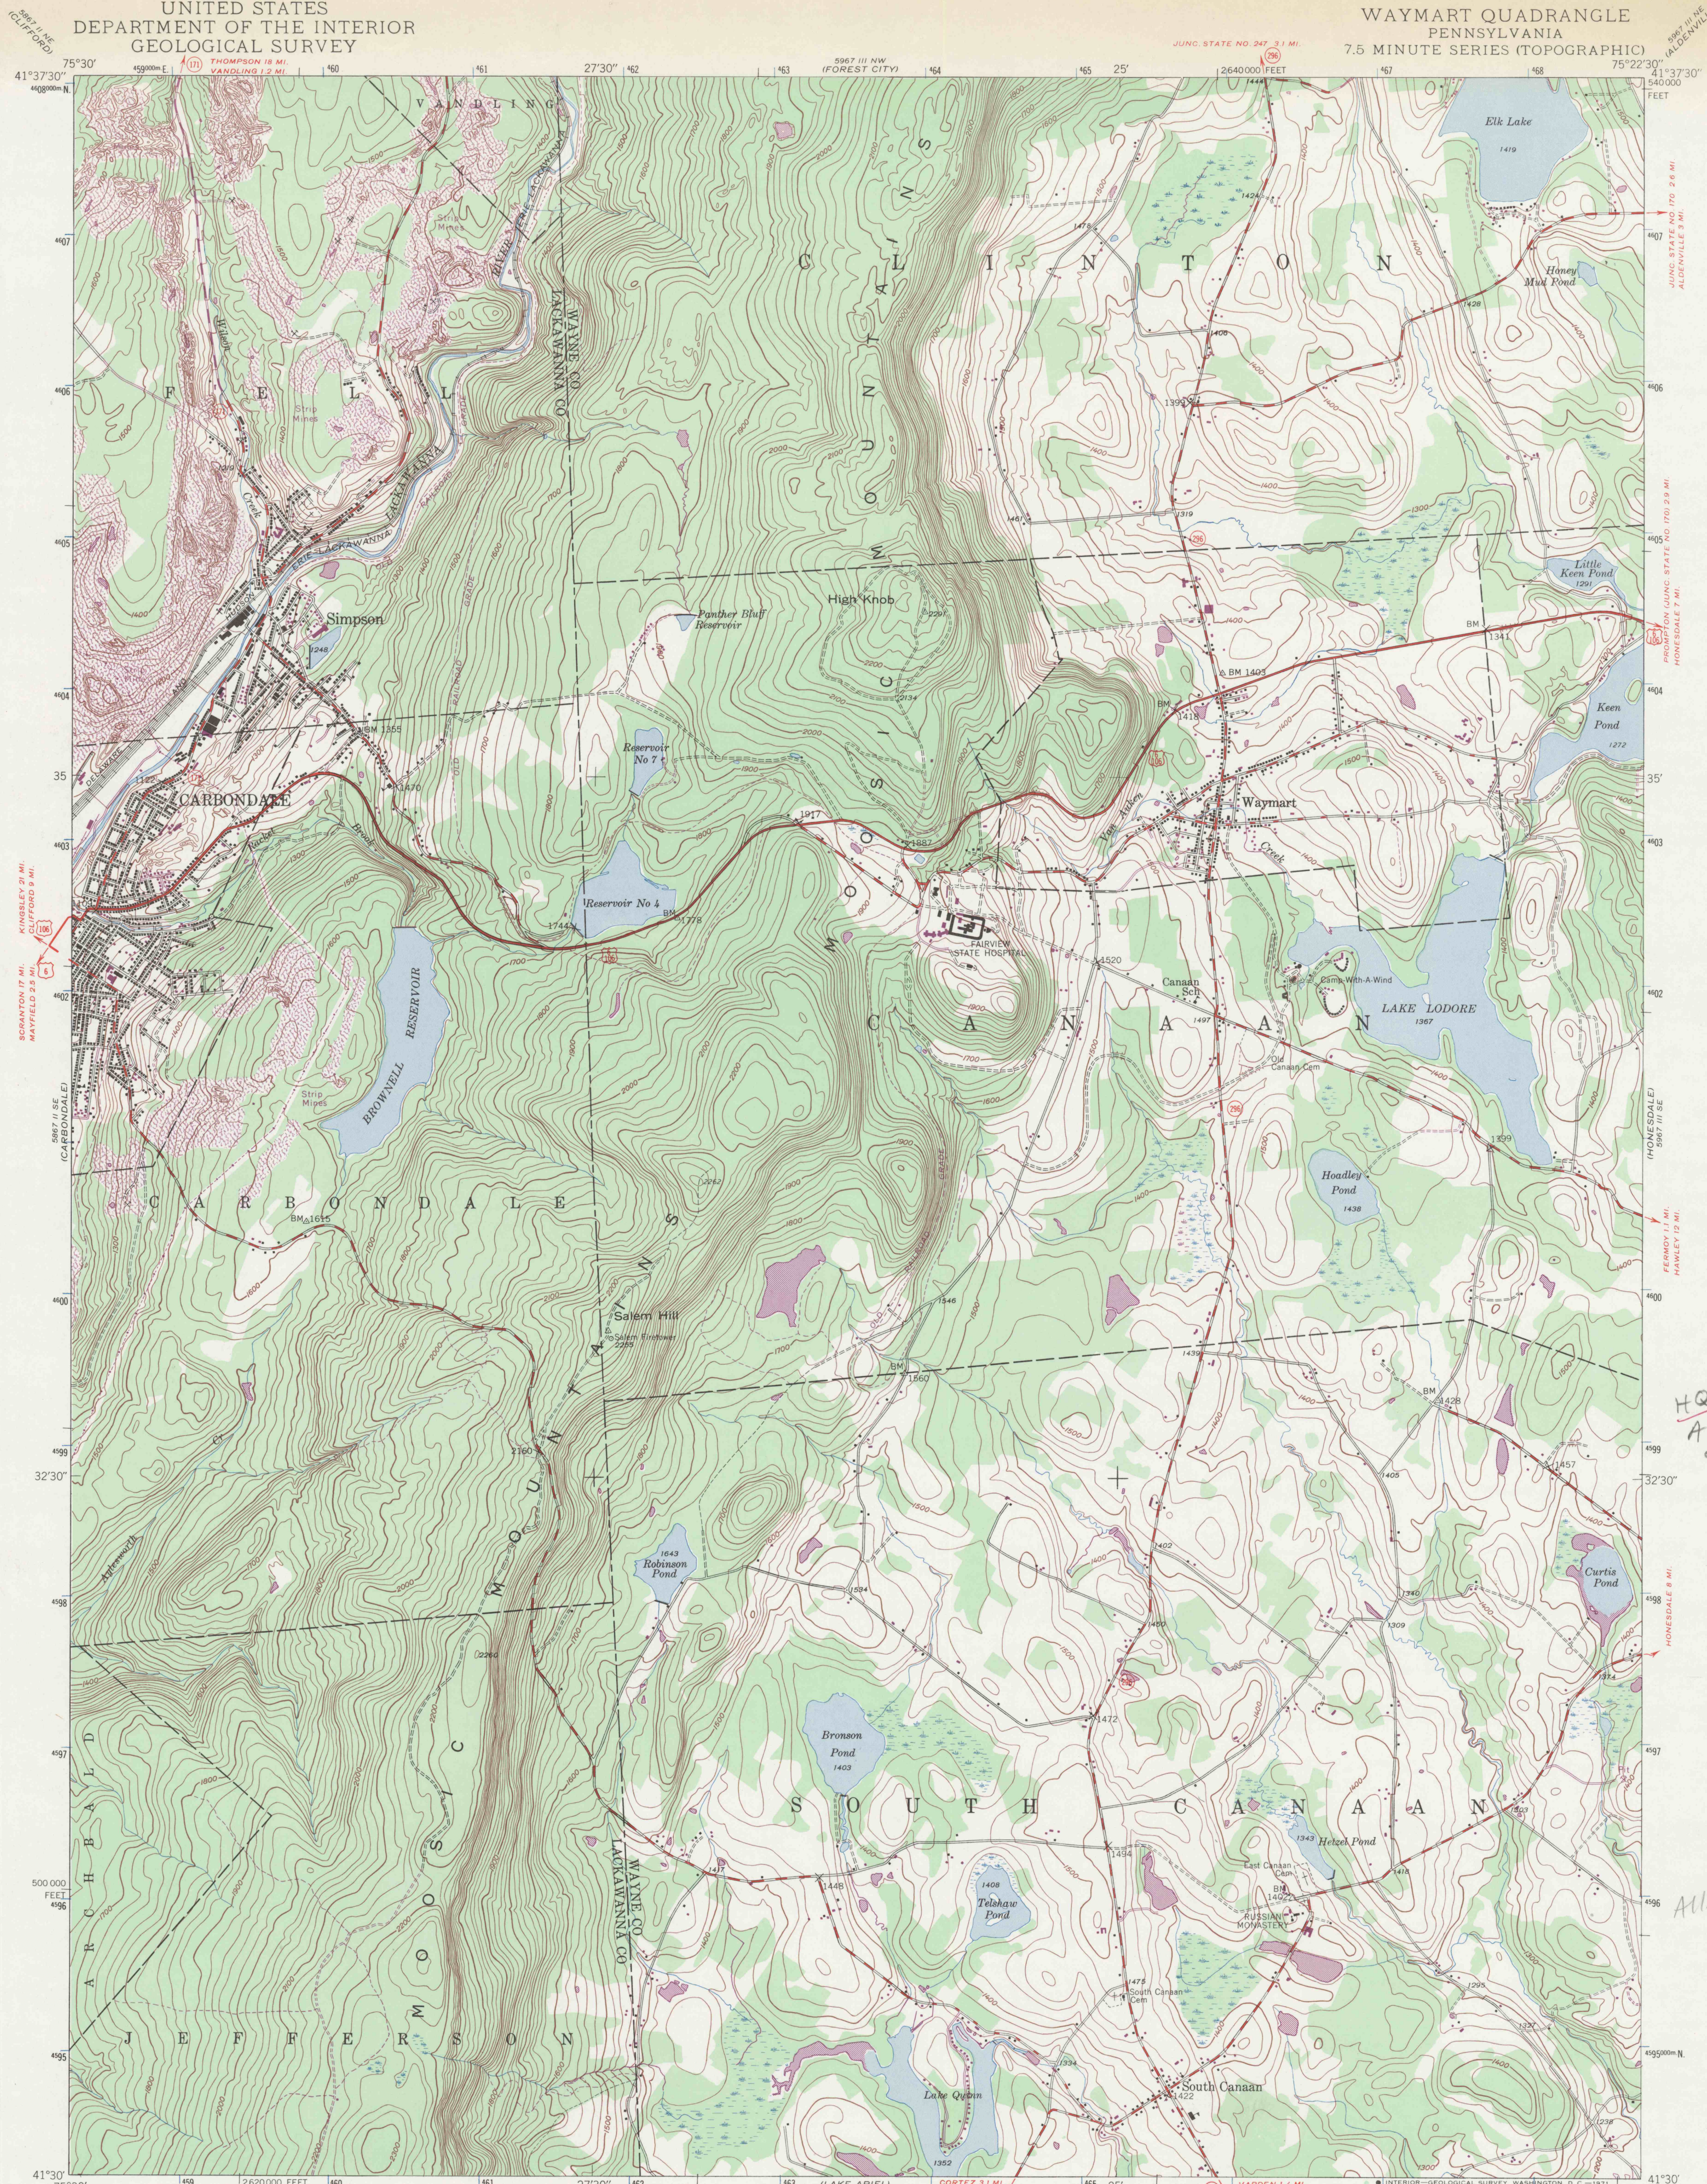

HQ streams
All Del. R. tribs
exc. Del. R.

All water ck
Lake?
Coke area

DRAWING NUMBER

DRAWING NUMBER

DRAWING NUMBER
SAM/2-22.3

PLAN HOLD CORPORATION • RIVINE, CALIFORNIA
REPRODUCTION NUMBER 107295



PLAN HOLD CORPORATION • RIVINE, CALIFORNIA
REPRODUCTION NUMBER 107295

PLAN HOLD CORPORATION • RIVINE, CALIFORNIA
REPRODUCTION NUMBER 107295


0642

2-22.3

Mapped, edited, and published by the Geological Survey
Control by USGS
Topography from aerial photographs by multiplex methods
Aerial photographs taken 1942. Field check 1946
Polyconic projection. 1927 North American datum
100,000-foot grid based on Pennsylvania coordinate system,
North zone
1000-meter Universal Transverse Mercator grid ticks,
zone 18, shown in blue
Revisions shown in purple compiled in cooperation with
State of Pennsylvania agencies from aerial photographs taken 1969
This information not field checked

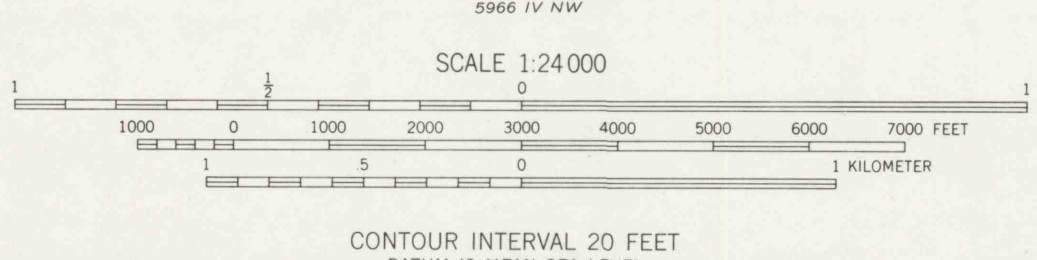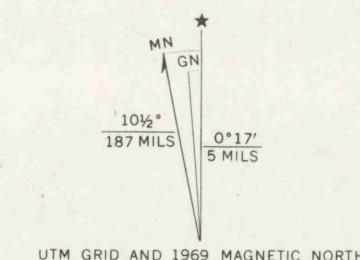

THIS MAP COMPLIES WITH NATIONAL MAP ACCURACY STANDARDS
FOR SALE BY U.S. GEOLOGICAL SURVEY, WASHINGTON, D.C. 20242
A FOLDER DESCRIBING TOPOGRAPHIC MAPS AND SYMBOLS IS AVAILABLE ON REQUEST

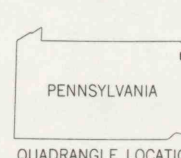

ROAD CLASSIFICATION	
HARD-SURFACE ALL WEATHER ROADS	DRY WEATHER ROADS
Heavy-duty 6 LANE 6 LANE	Improved dirt
Medium-duty 6 LANE 6 LANE	Unimproved dirt
Loose-surface or narrow hard-surface	
U. S. Route	State Route

WAYMART, PA.
N4130-W7522.5/7.5
1946
AMS 5967 III SW-SERIES VBS1
PHOTOREVISED 1969