


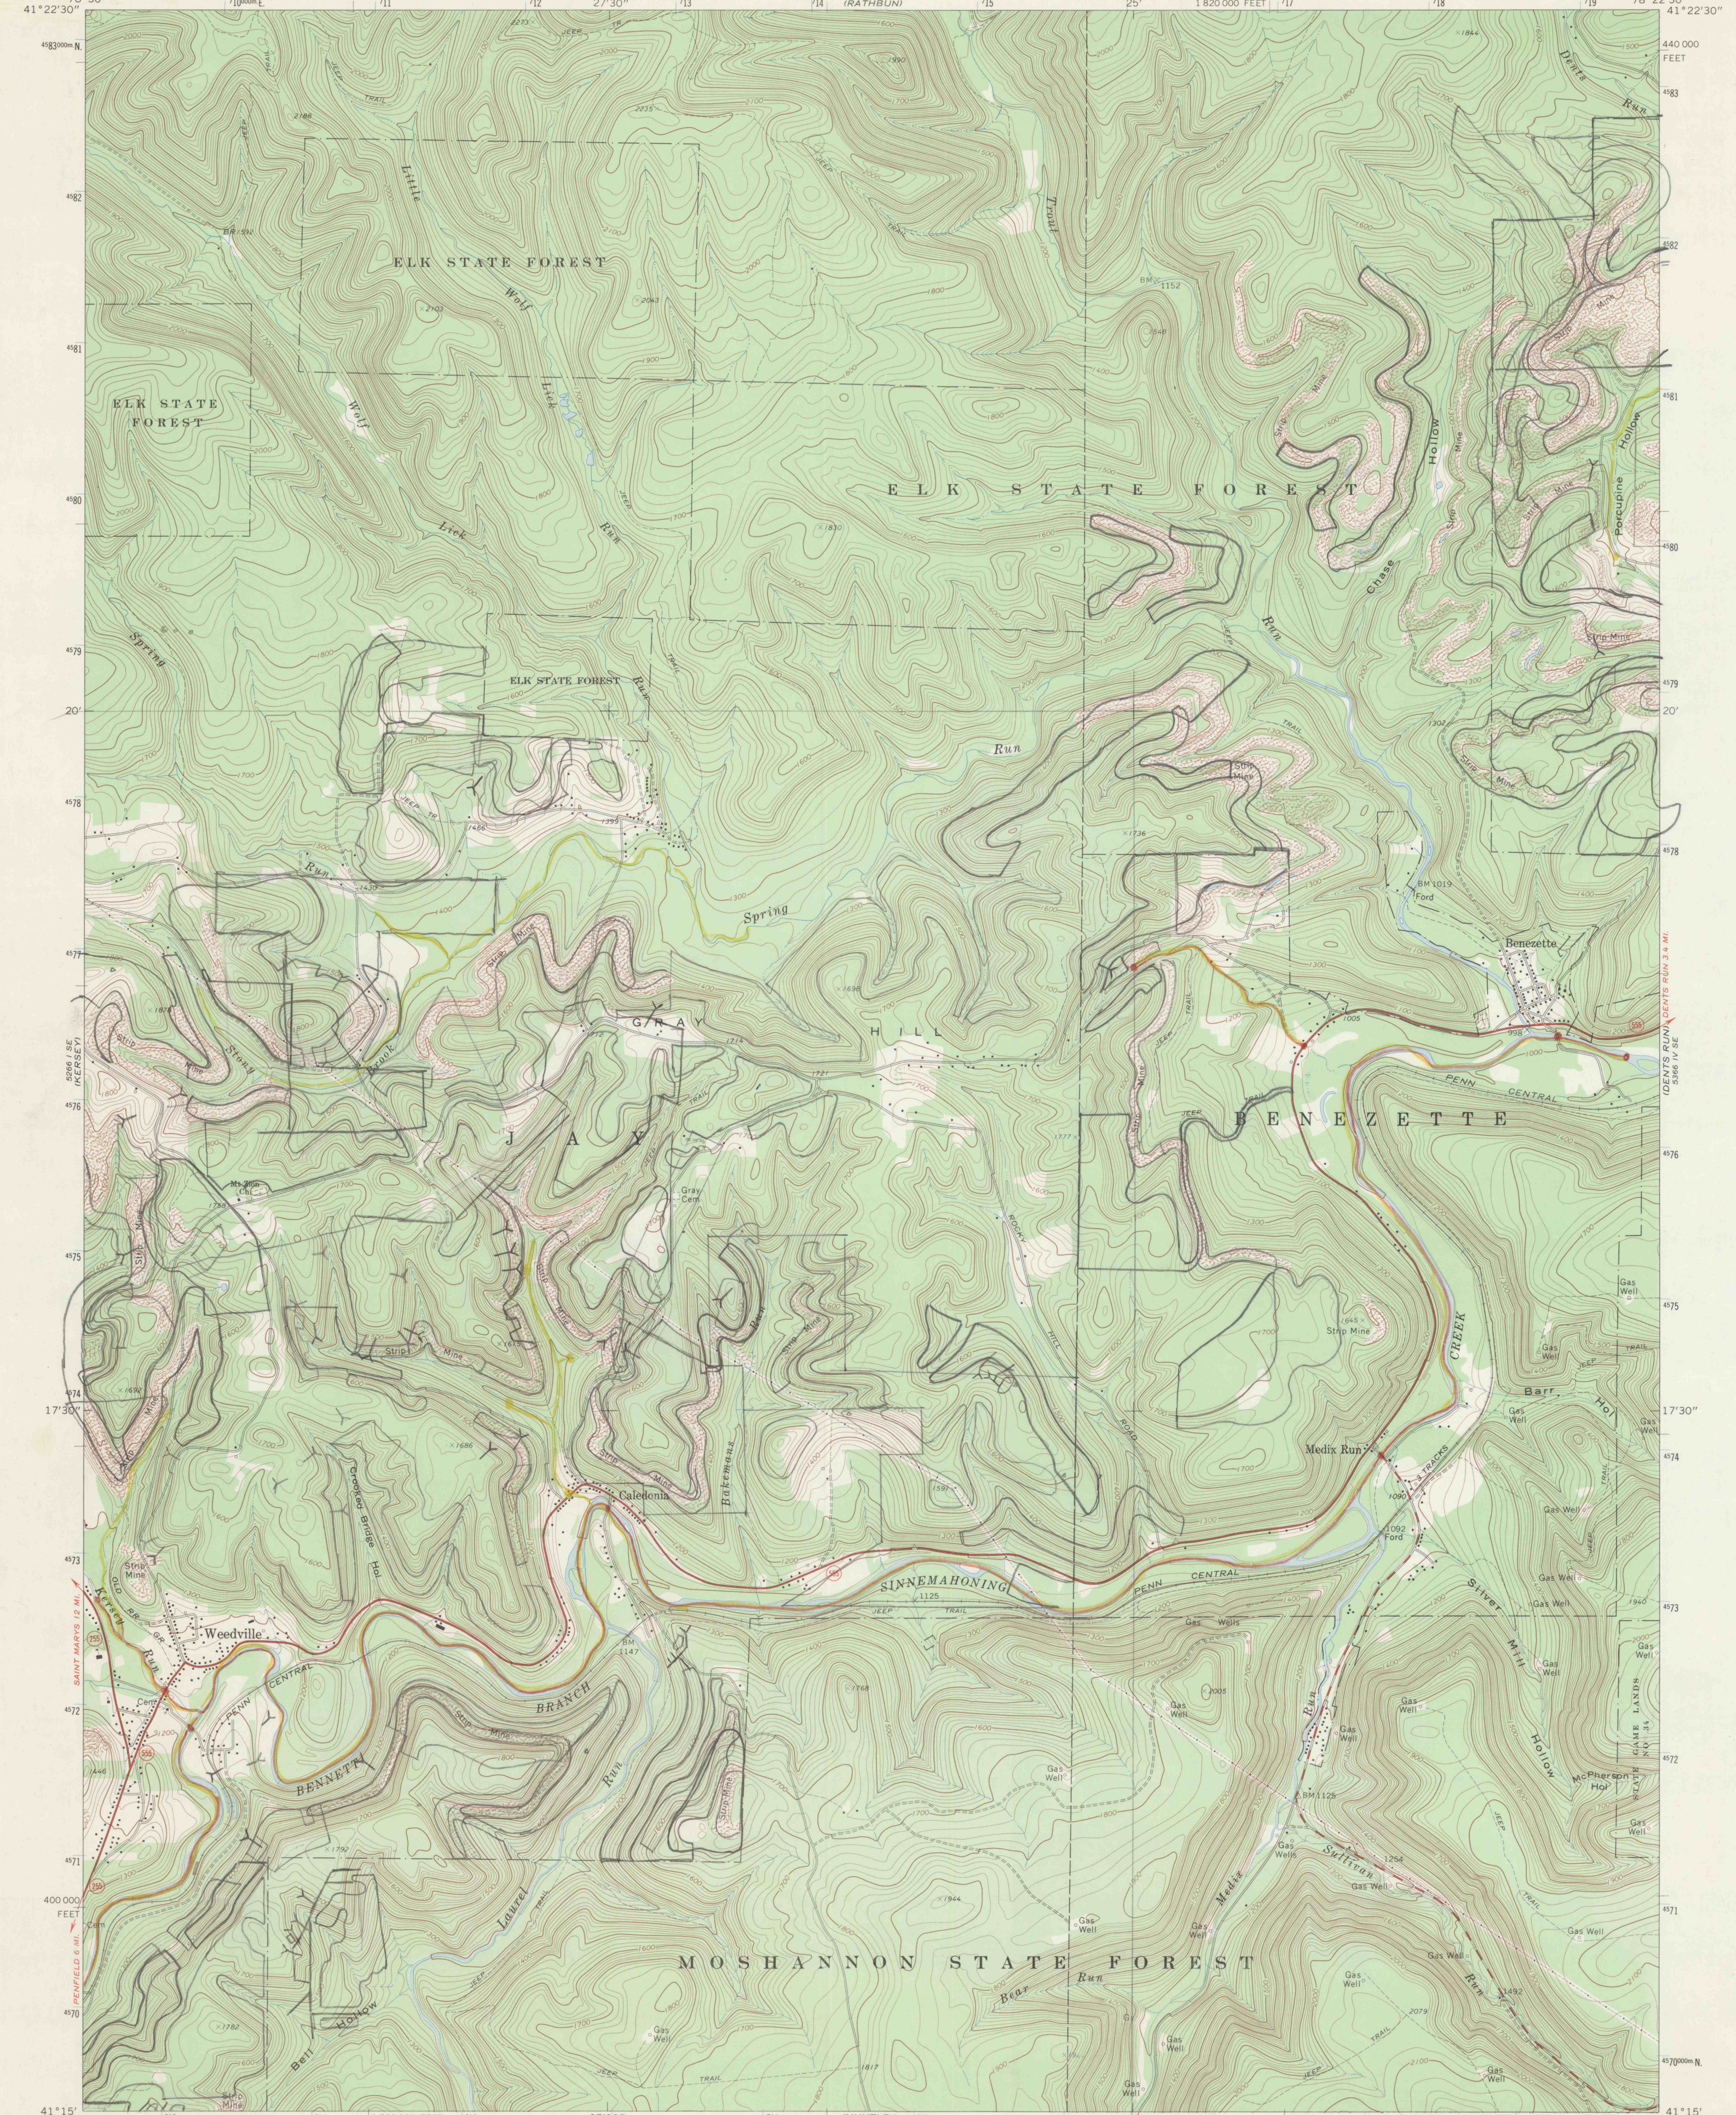

PLAN HOLD

FEEL PROTECTIVE STRIP TO EXPOSE ADHESIVE. POSITION EDGE OF PRINT ON THIS LINE AND RUB TO ADHERE.

DRAWING NUMBER
3-10.3

PLAN HOLD CORPORATION - TORRANCE, CALIFORNIA
REORDER BY NO. 0703A-24

0818

3-10.3