


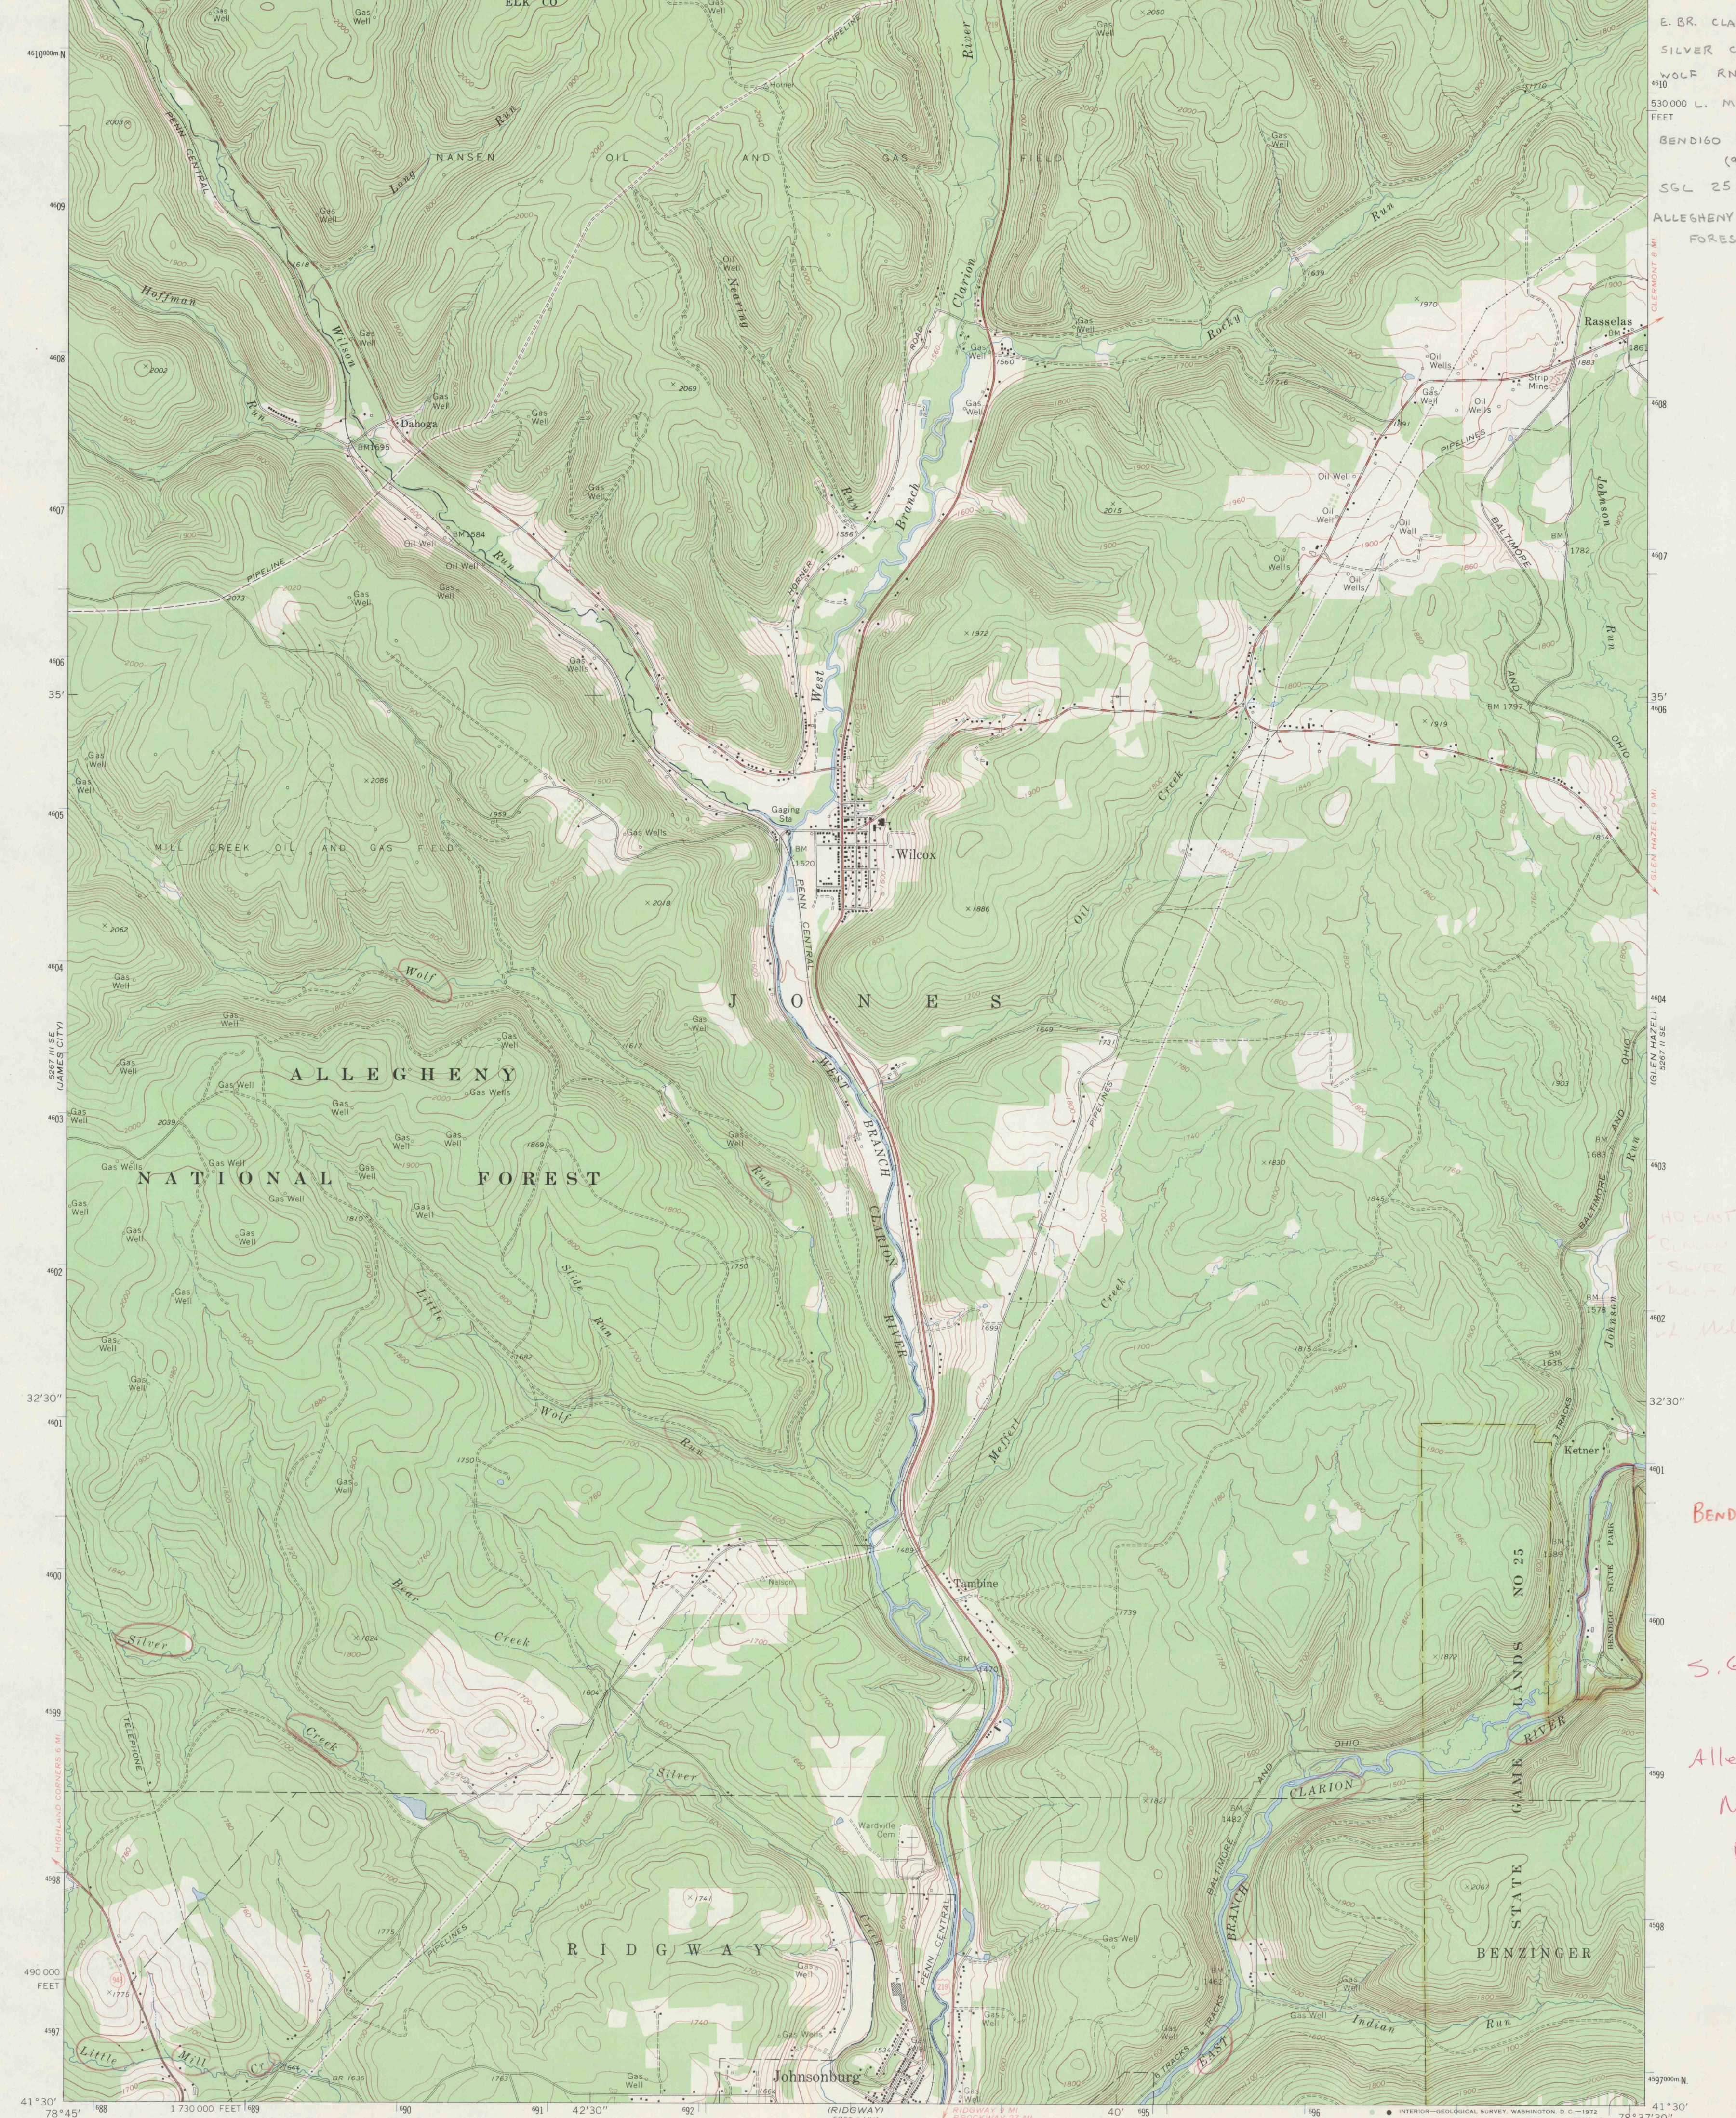

E. BR. CLARION R (9)
SILVER CK (7,8)
WOLF RN (4,5)
530,000 L. MILL CK (7)
BENDIGO STATE PARK (9)
SGL 25 (9)
ALLEGHENY NATIONAL FOREST

HO EAST BENDIGO
CLARION RIVER BASIN
SILVER CK (7,8)
WOLF RN (4,5)
WOLF CK
BENDIGO S.P. OK
S.G.L. #25
Allegheny National Forest