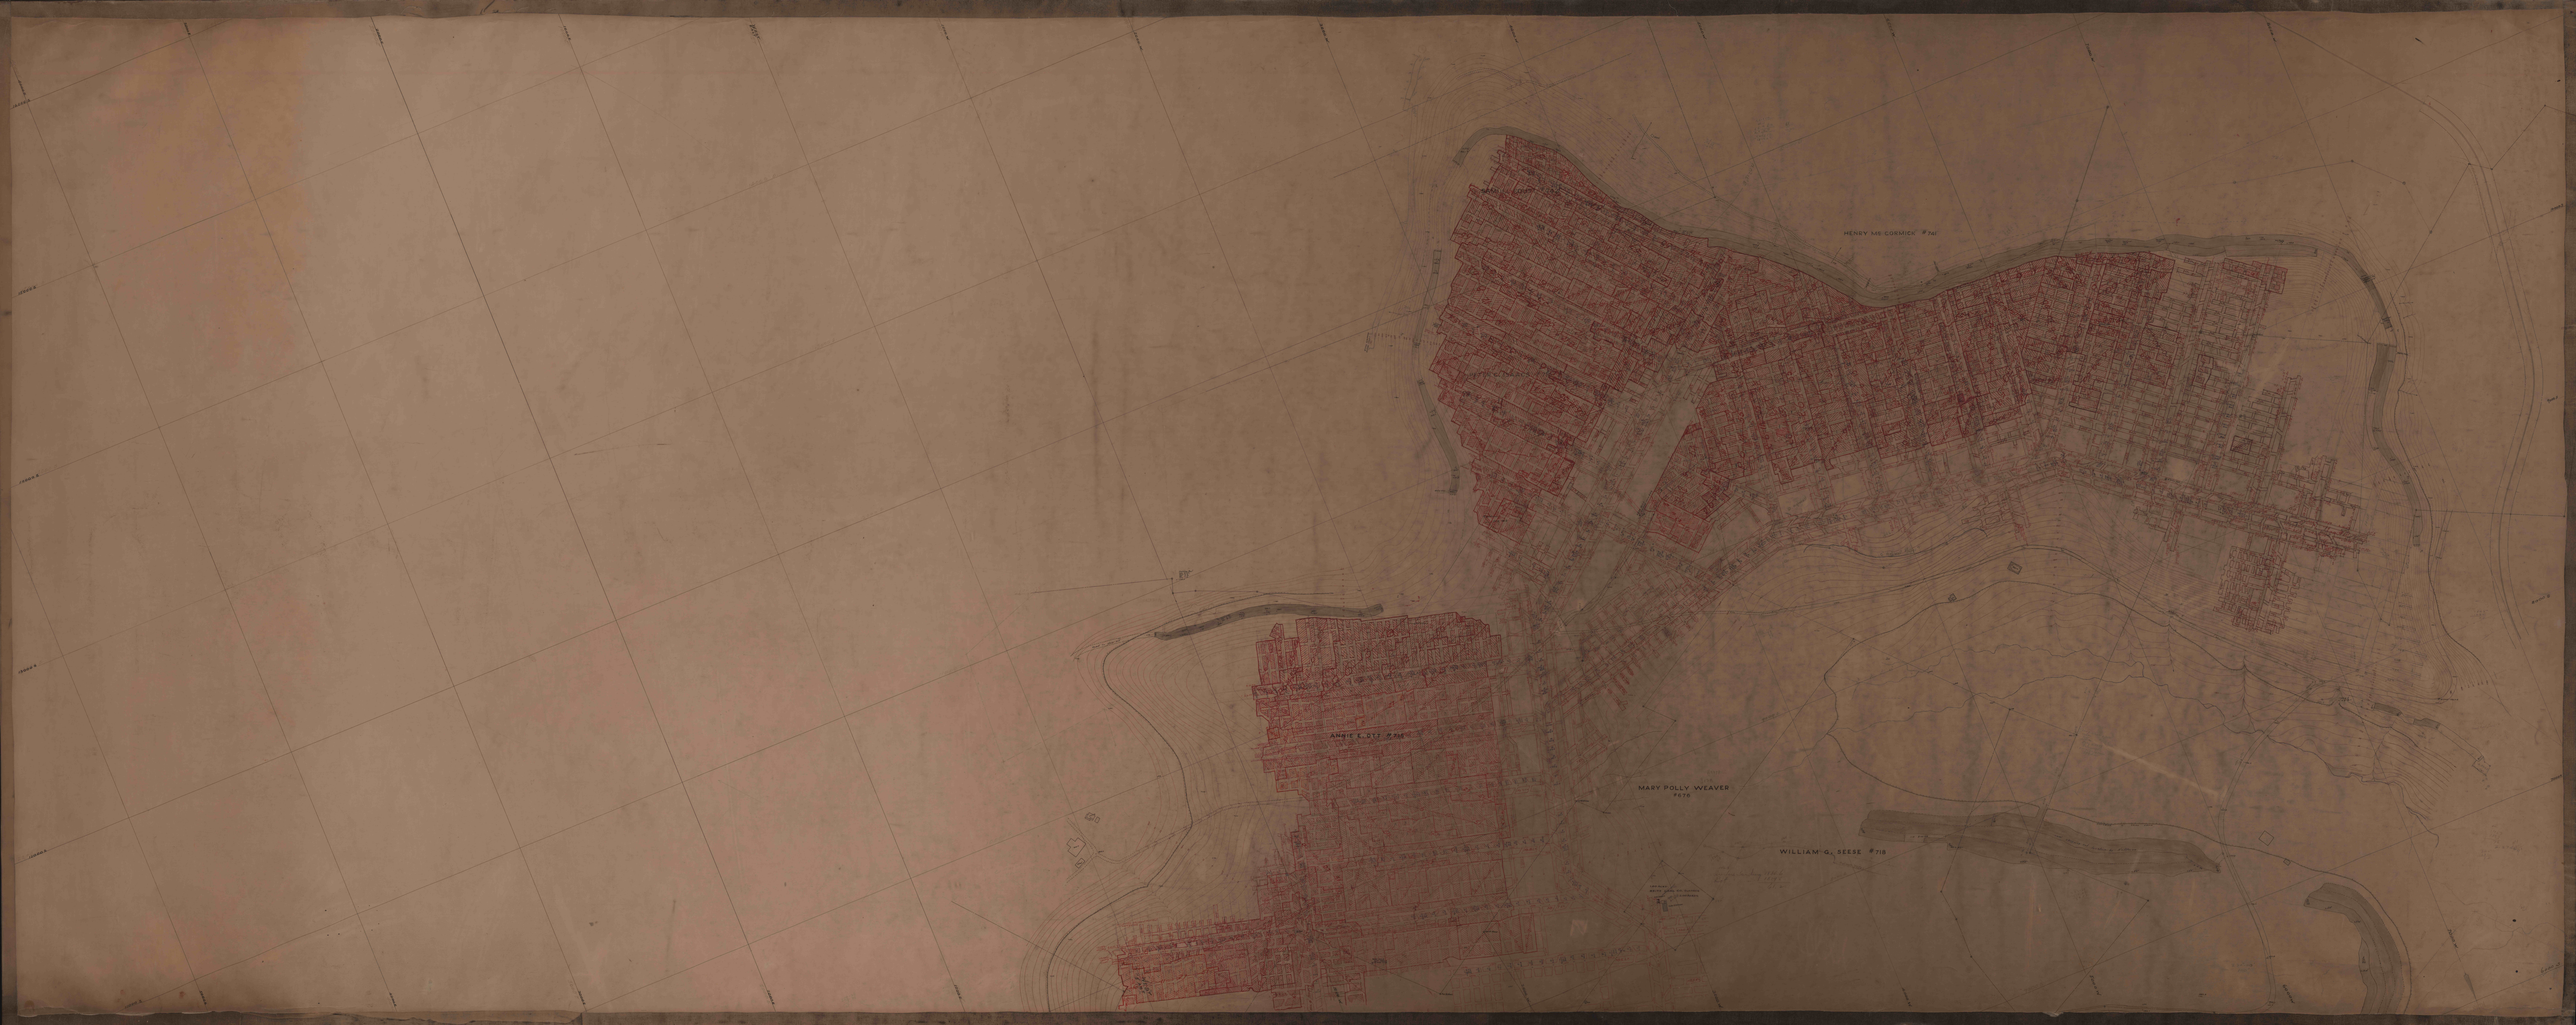
HENRY McCORMICK #741
ANNIE K. OTT #716
MARY POLLY WEAVER
#678
WILLIAM G. SEESE #718