


R. H. P.

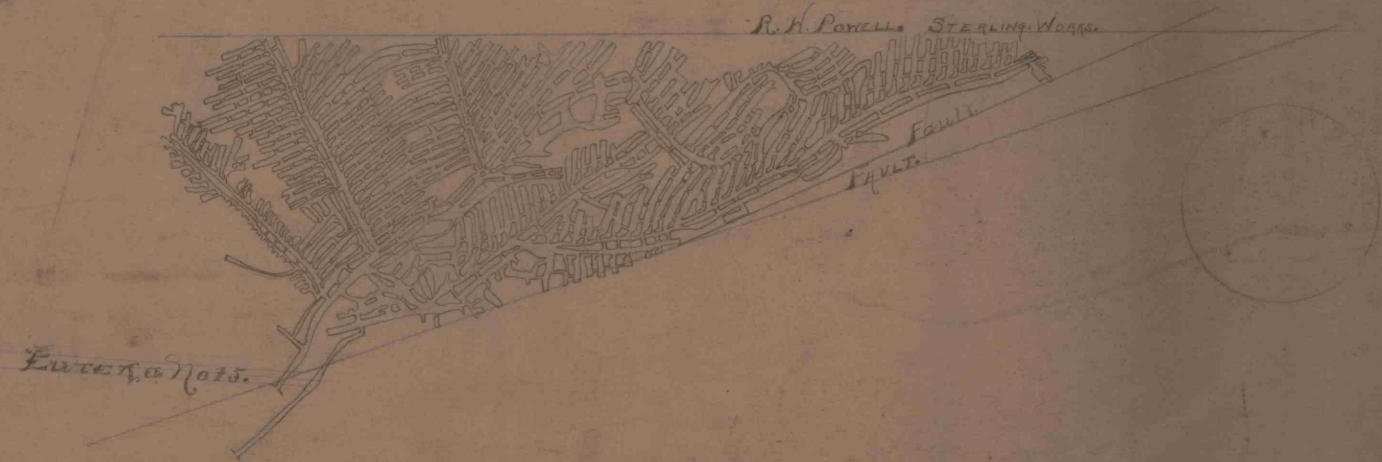

MAP
OF
EUREKA No. 15.
OPERATED BY
Berwind-White Coal Mining Co.
OF
PHILADELPHIA PA.