


MAP
OF
EUREKA COLLIERY
OPERATED BY
BERWIND WHITE & CO

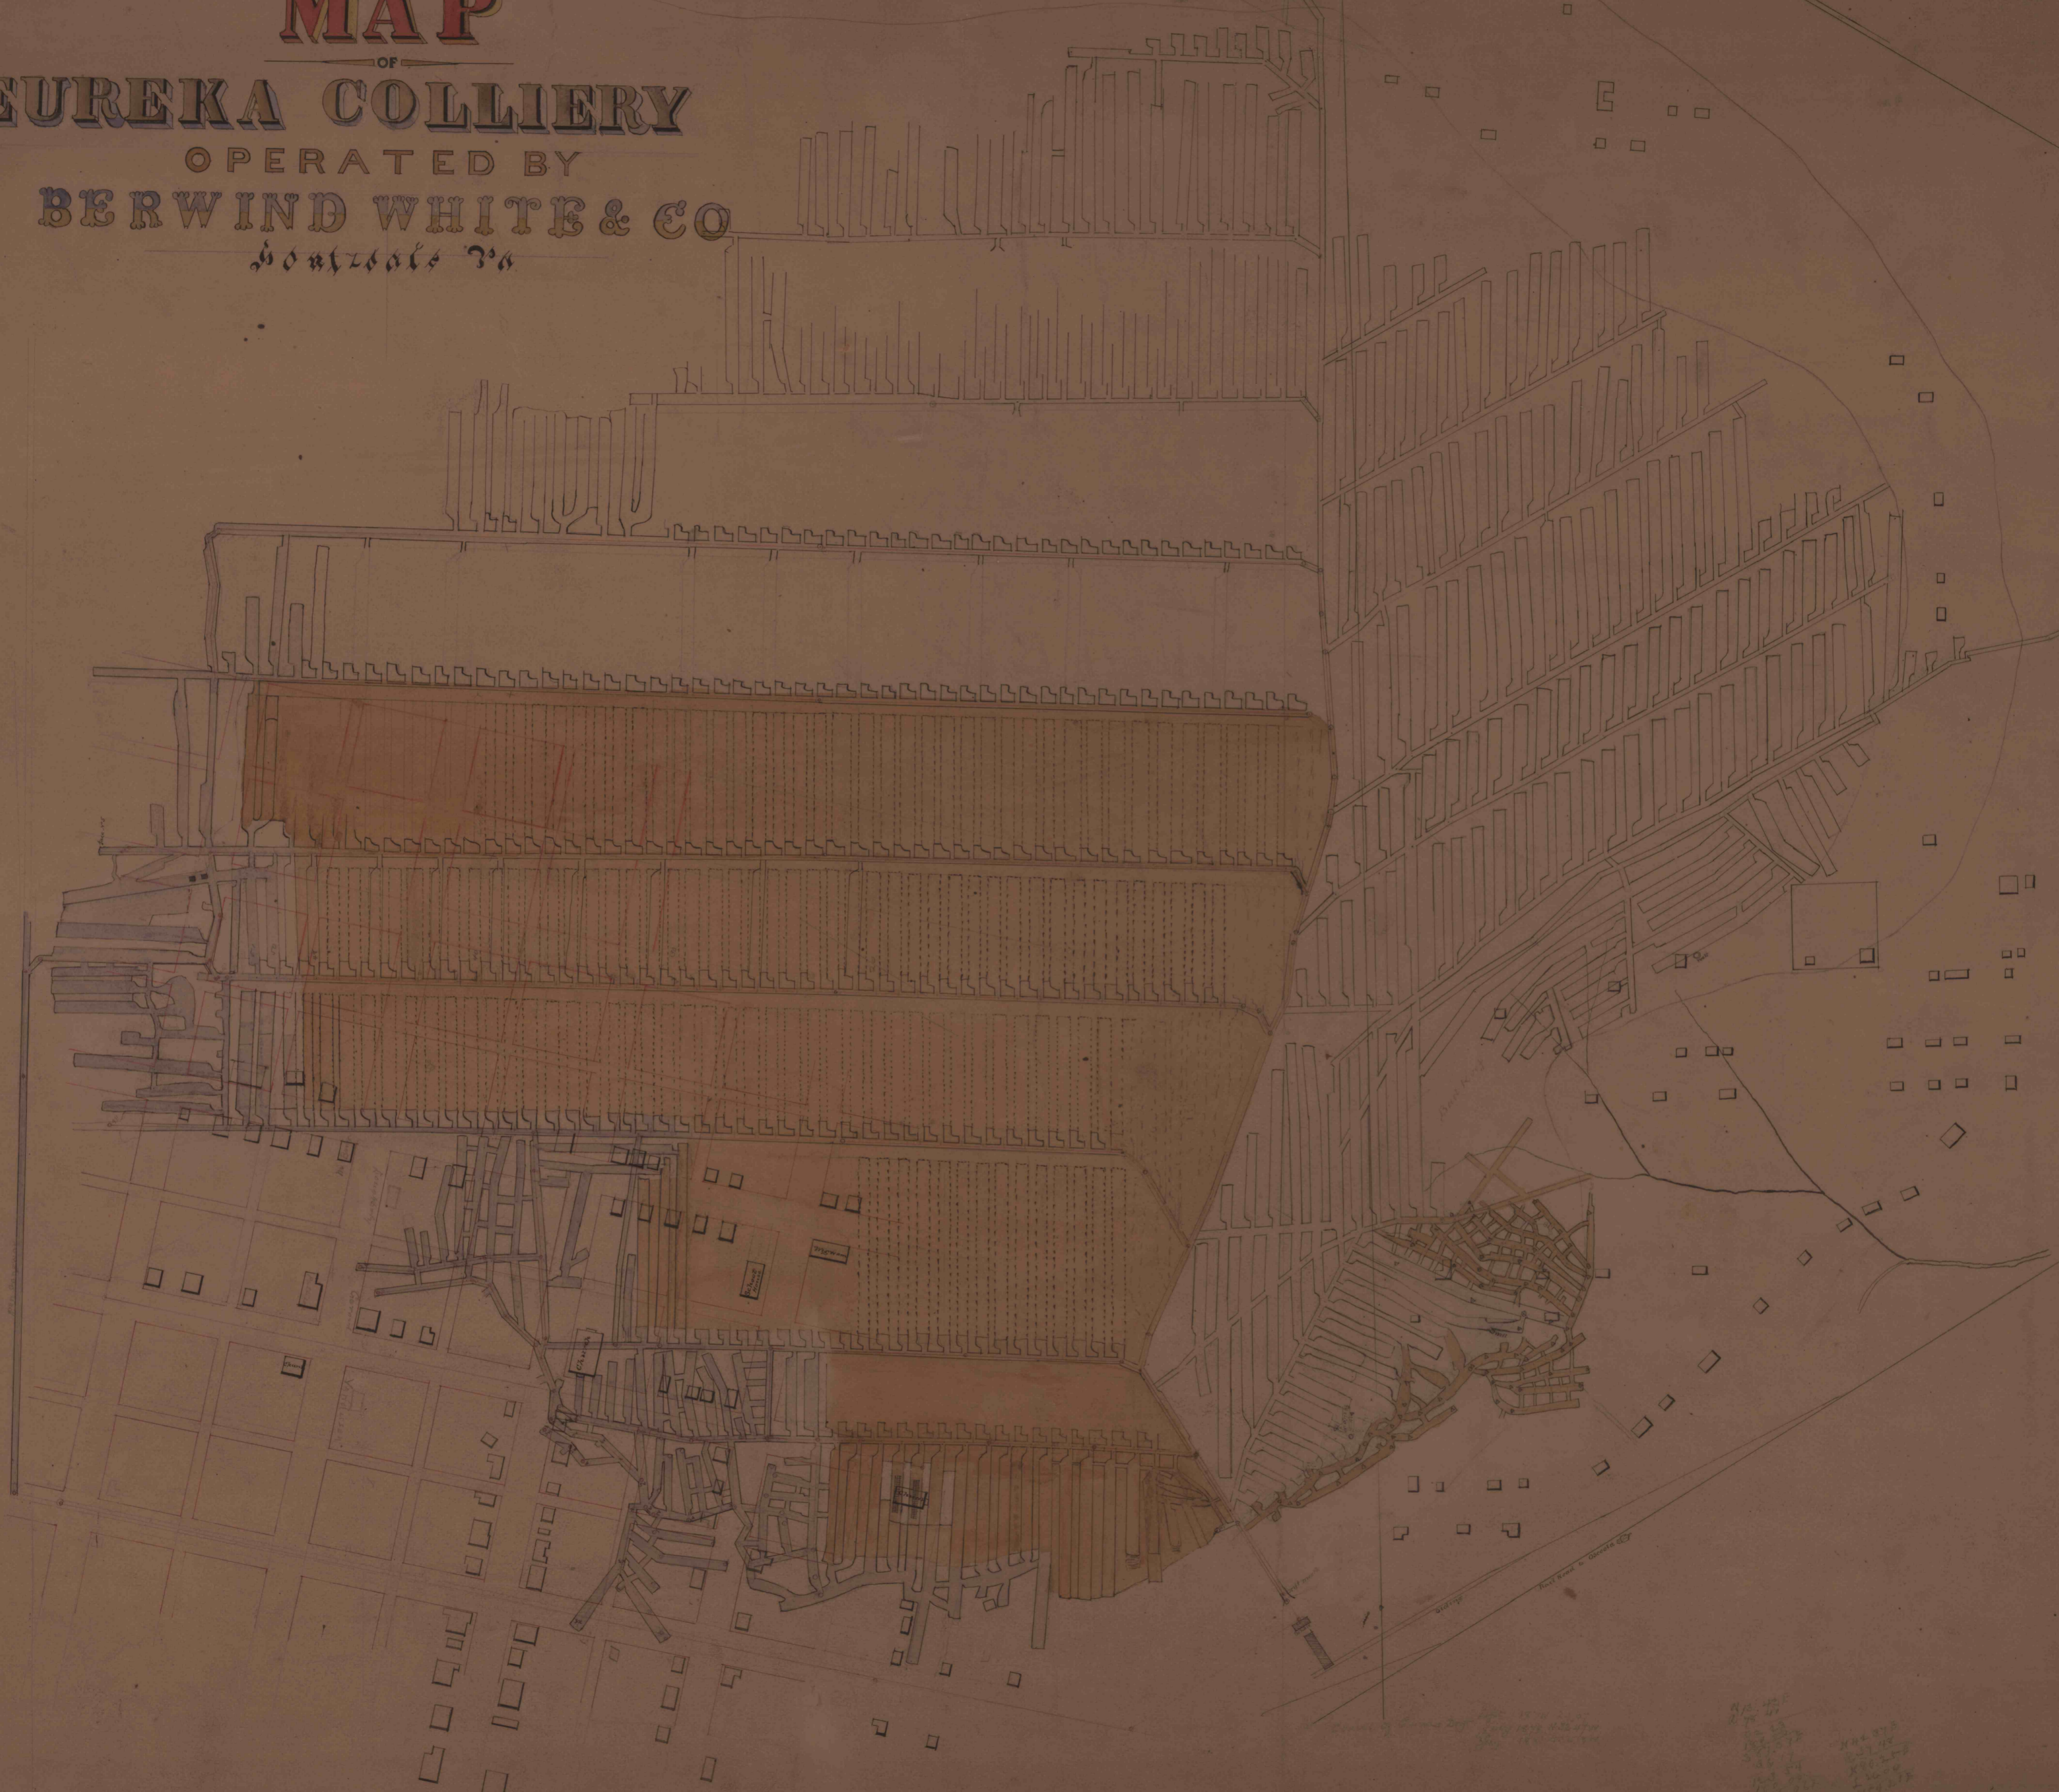

Faint, illegible text or notes at the bottom right of the map, possibly a scale or legend.