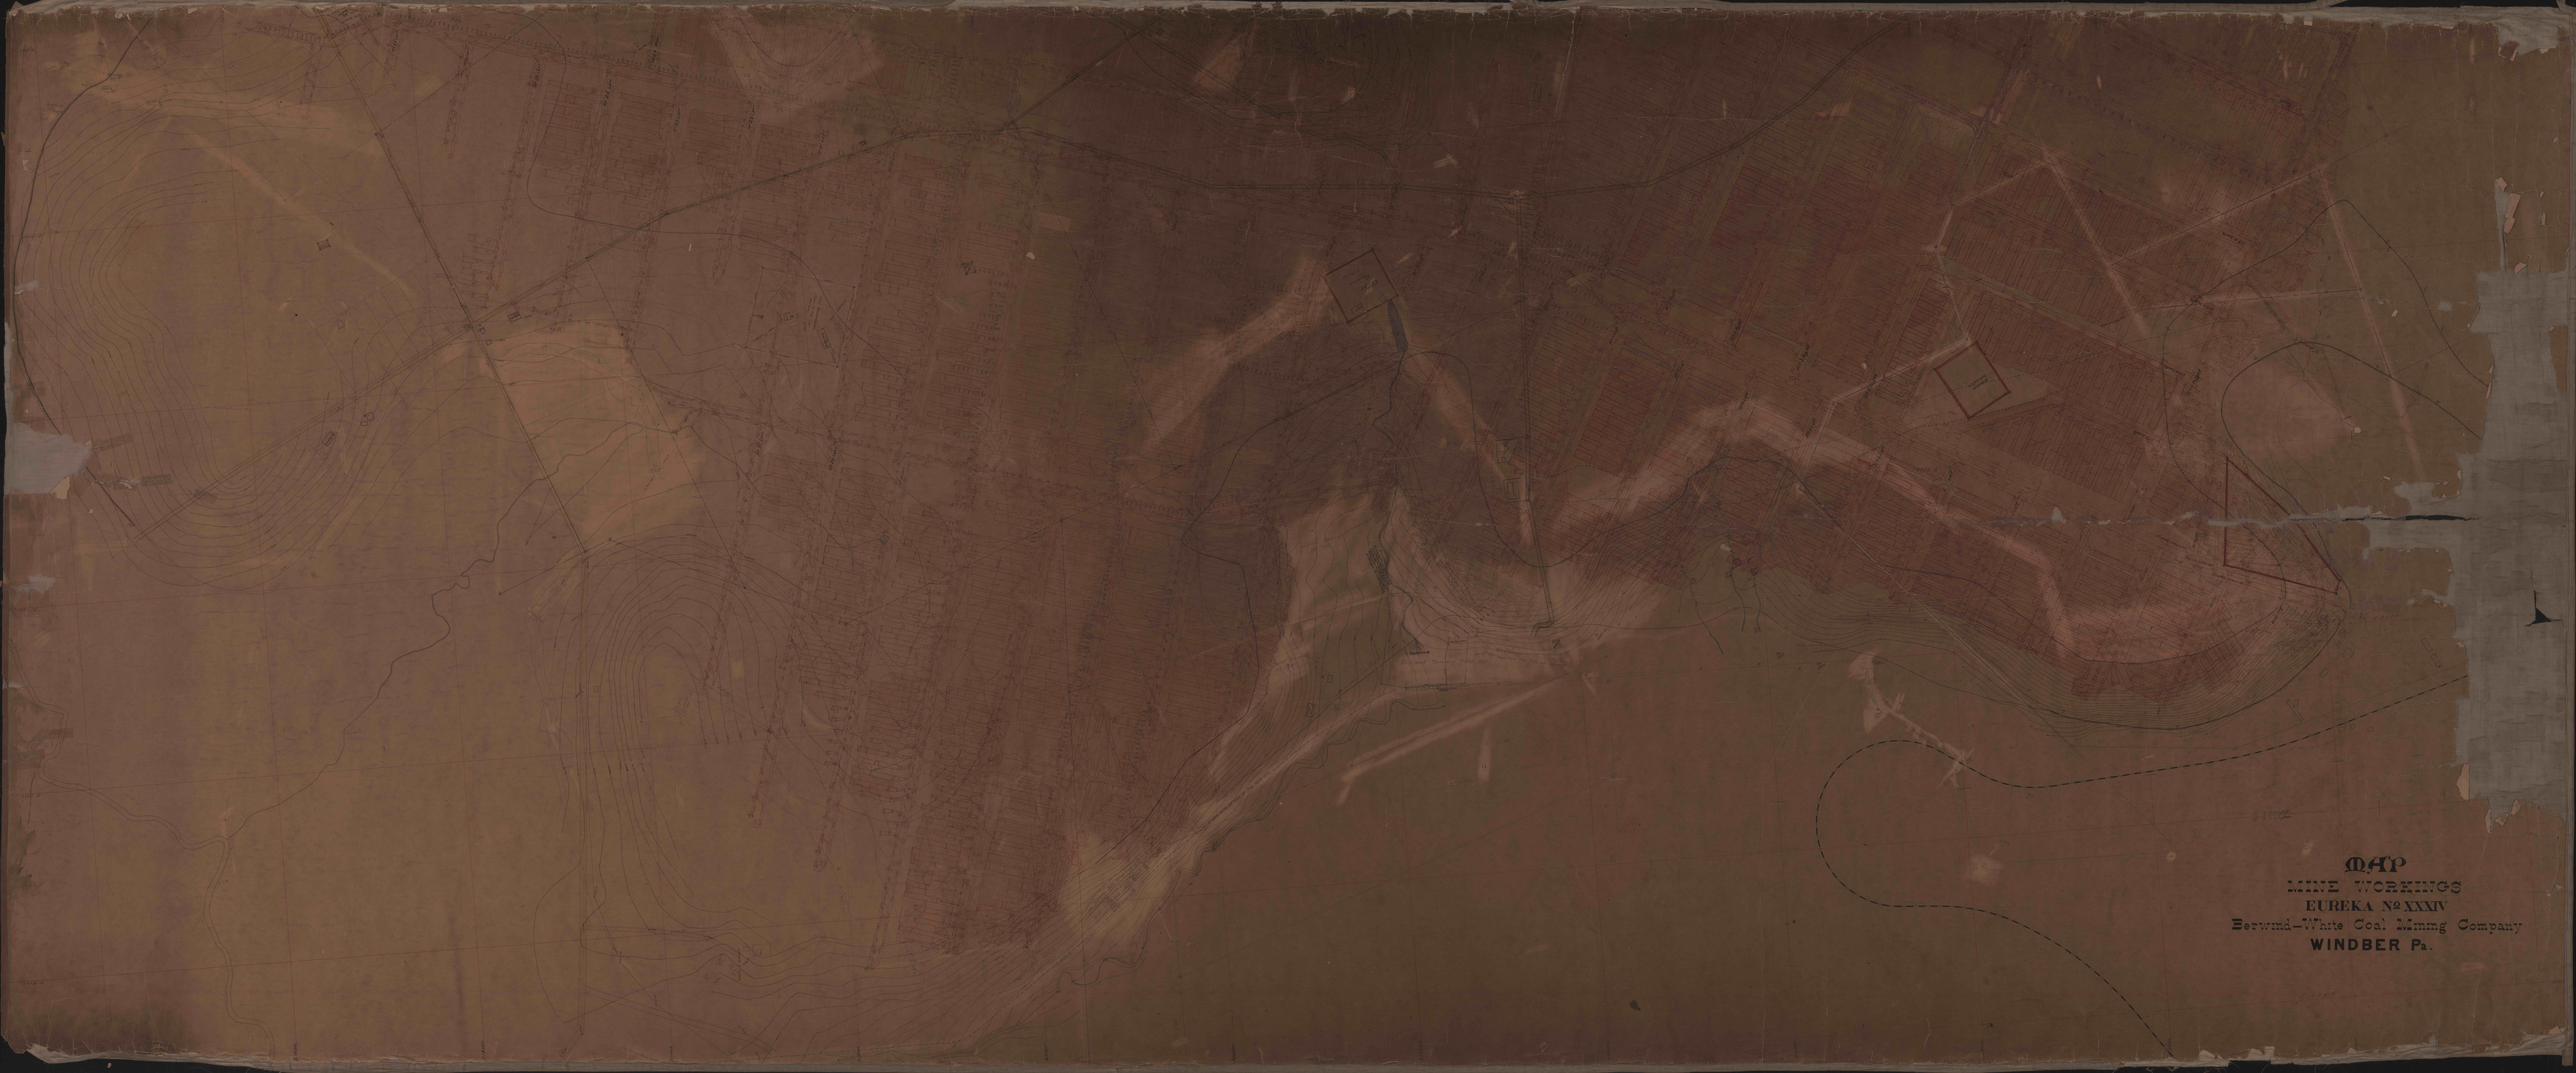
MAP
MINE WORKINGS
EUREKA No XXXIV
Berwind-White Coal Mining Company
WINDBER Pa.