


BAKER-WHITELEY COAL COMPANY

WILBUR COAL MINING COMPANY No. 4 MINE

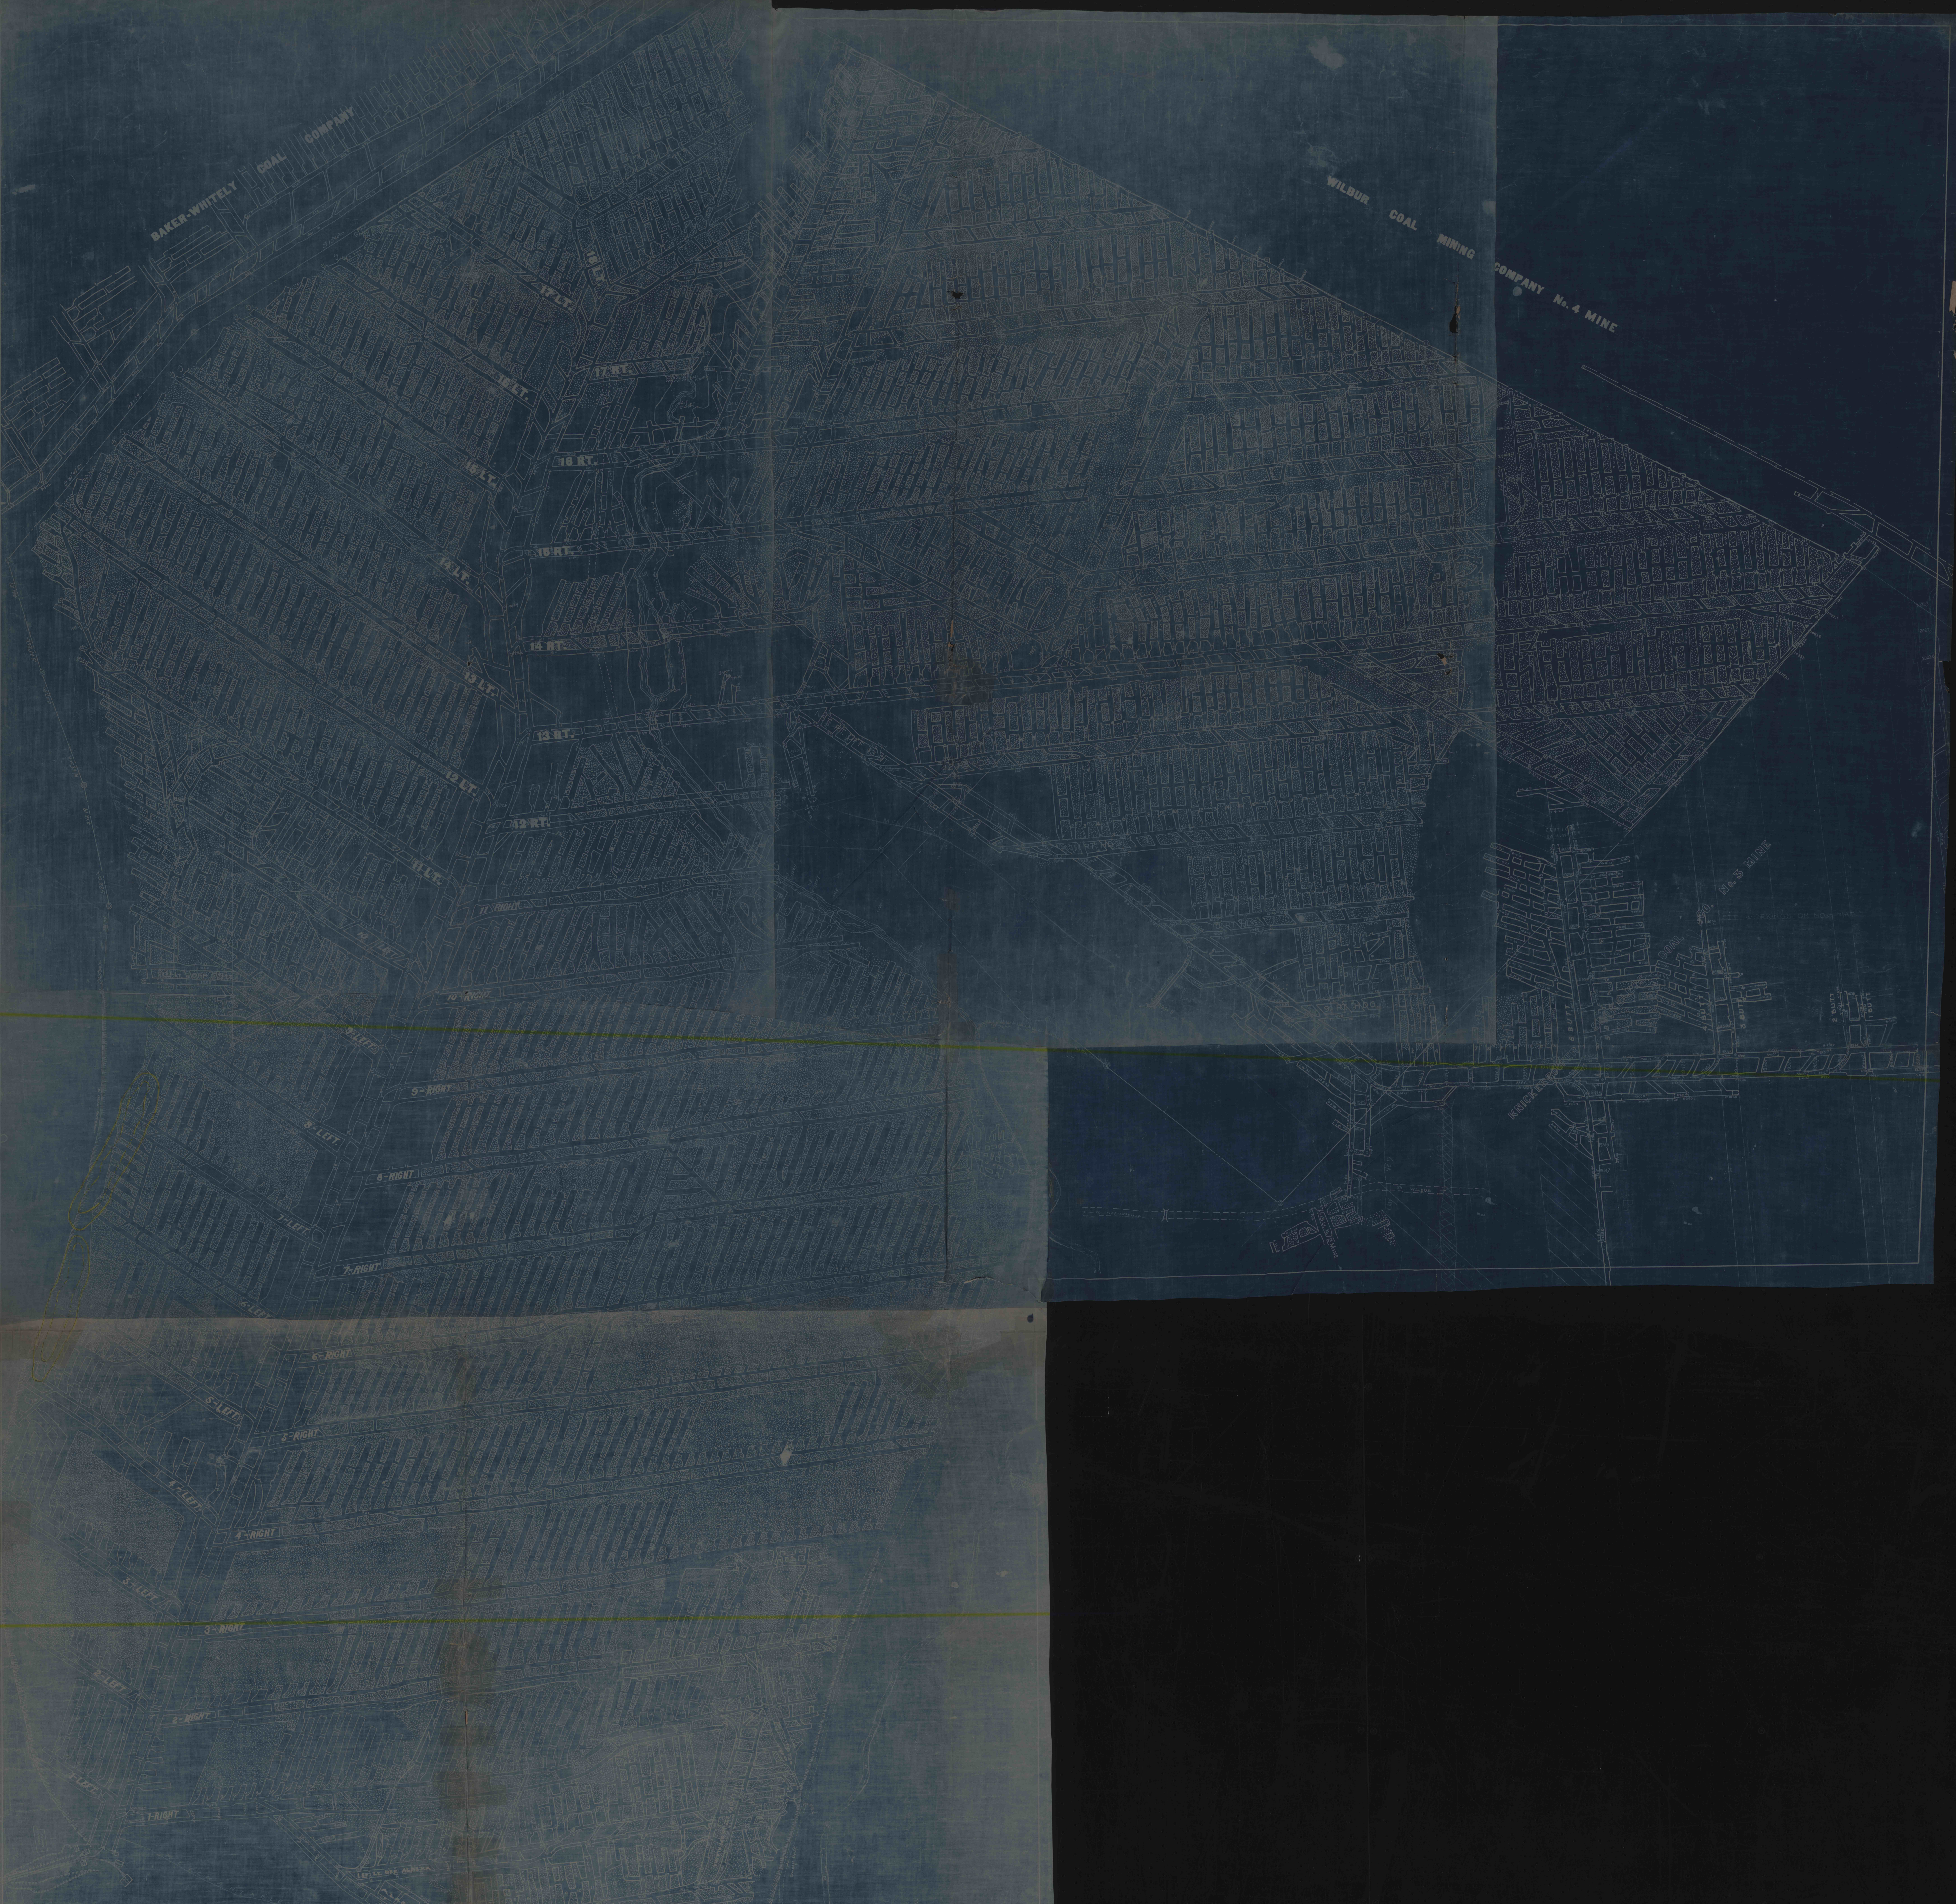

SOMERSET MINING COMPANY
MAP OF
KNICKERBOCKER No. 1
HOVERVILLE PA. SCALE 1"=100 FT.