


Burke  
No. 26

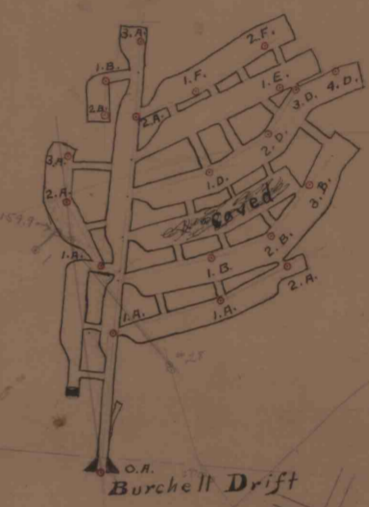

Burchell Drift

