


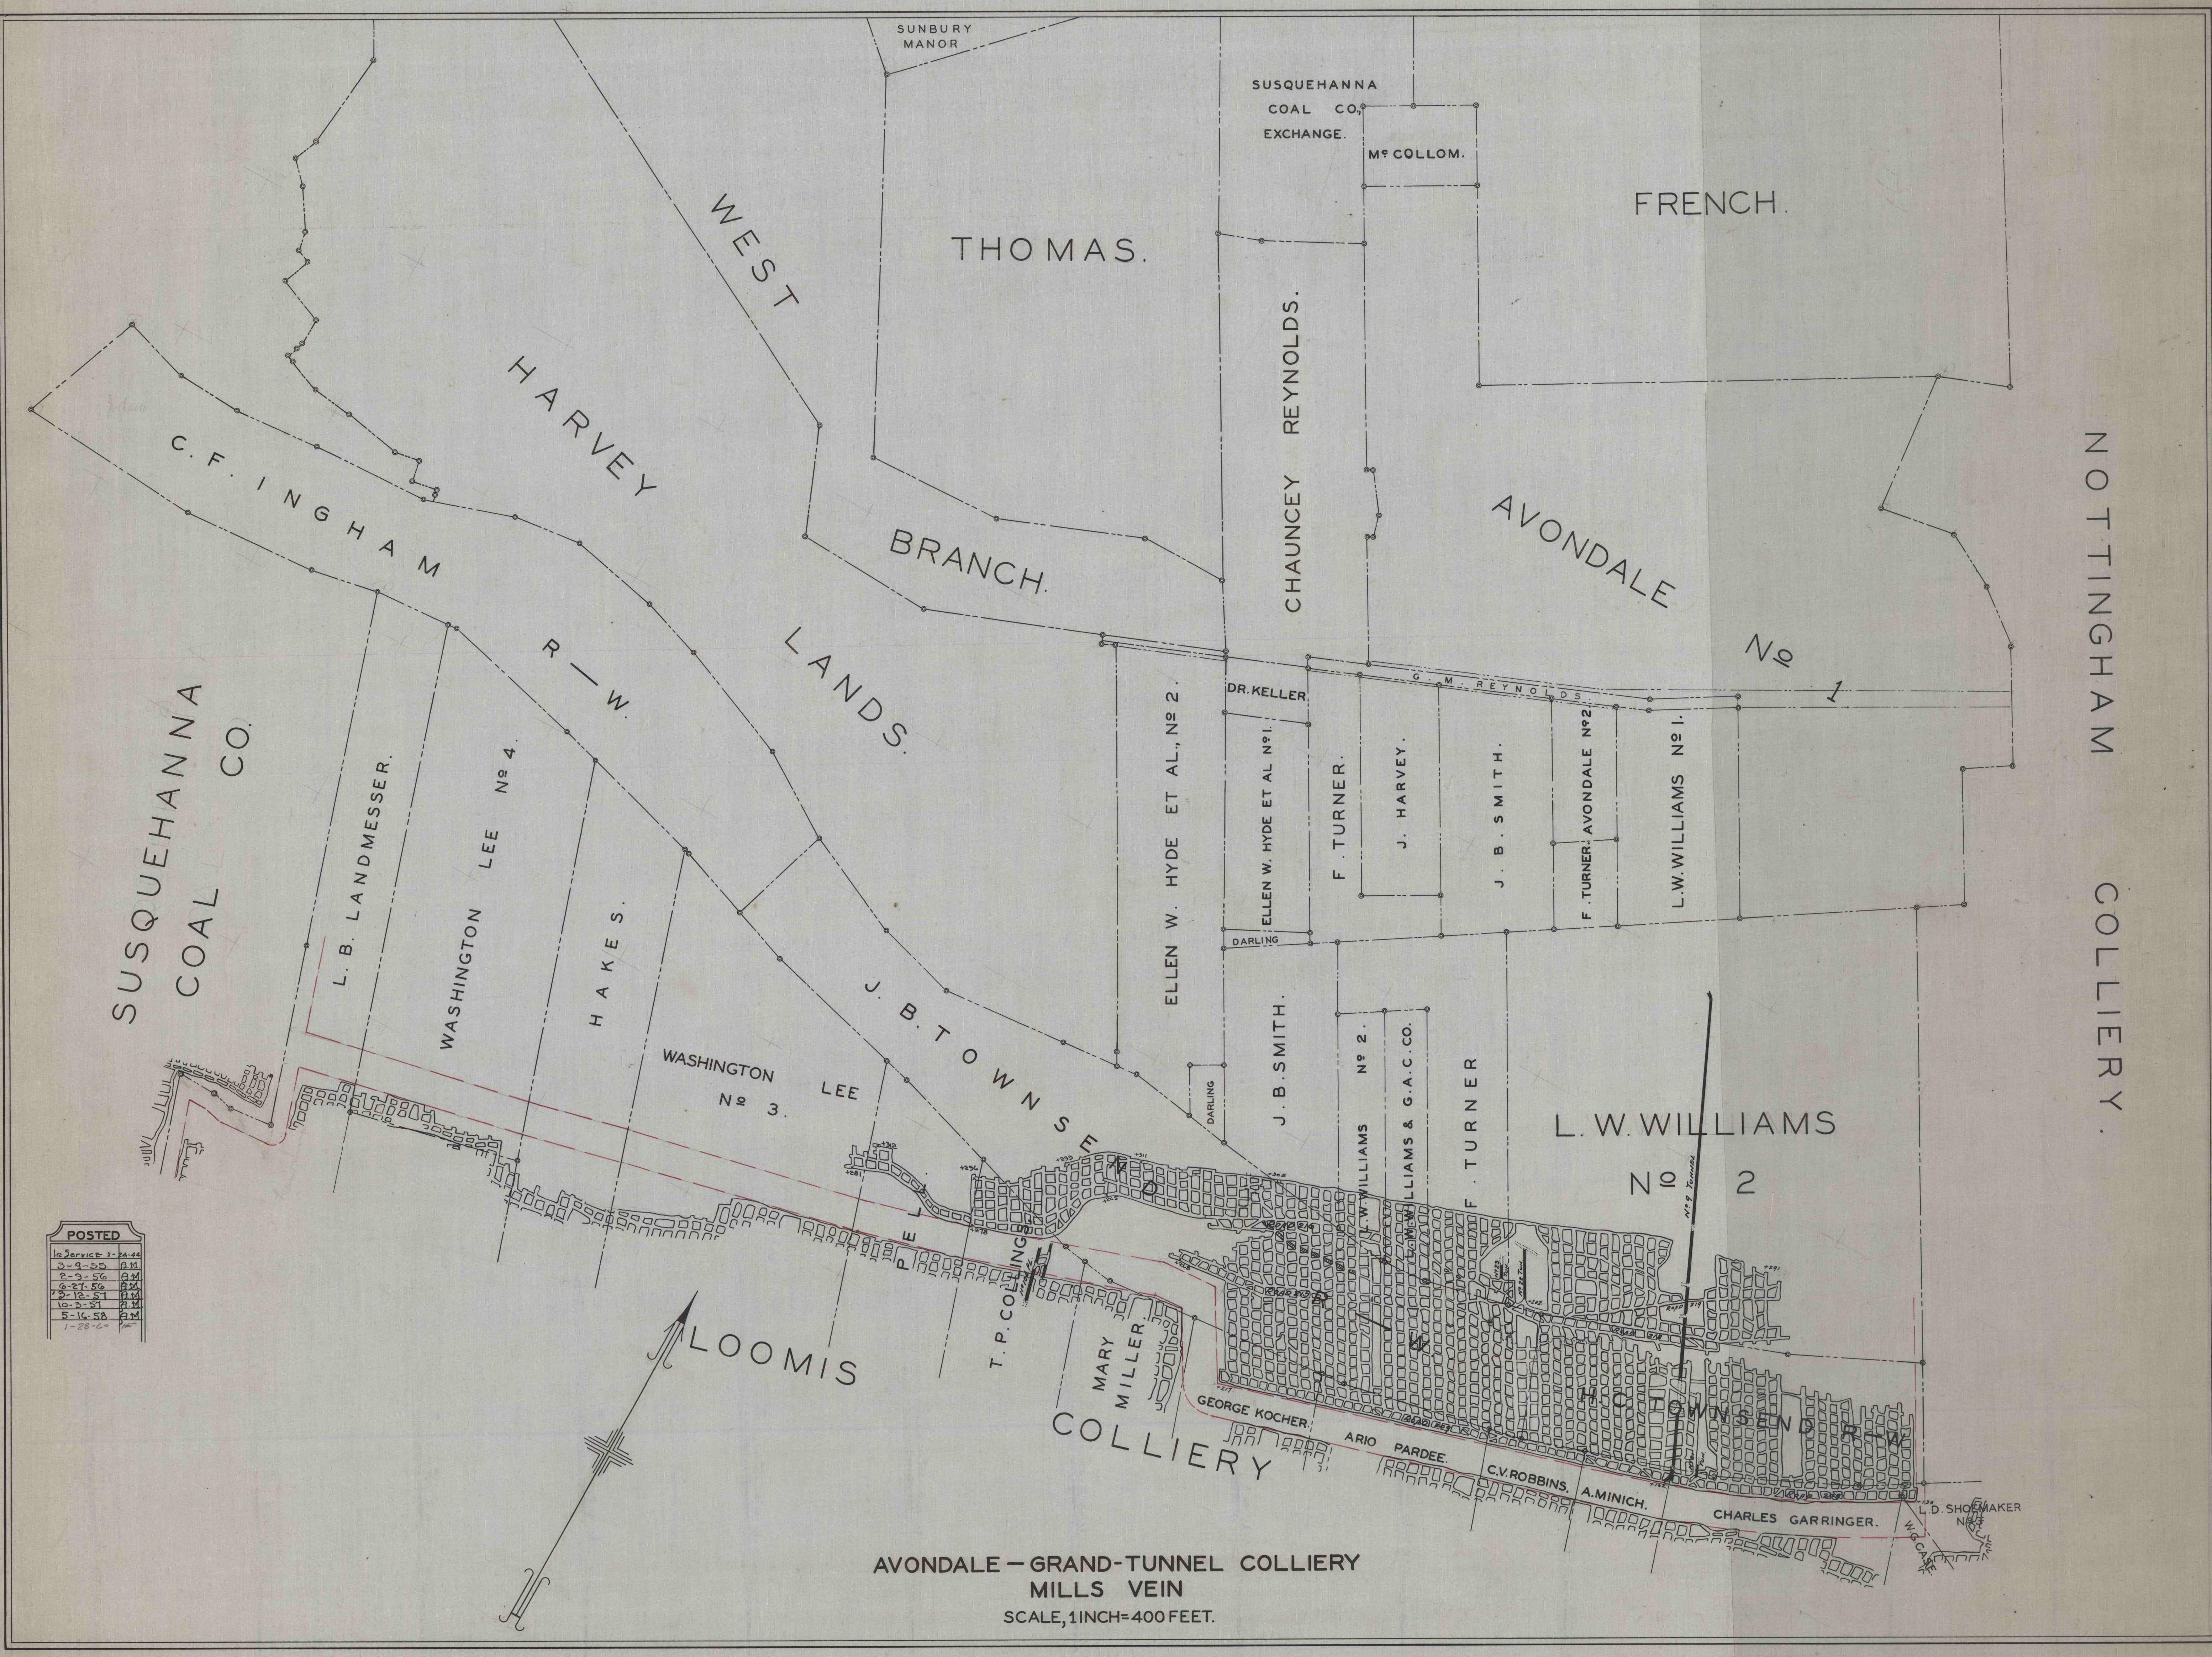

POSTED	
In Service 1-24-44	
2-9-55	AM
2-9-56	AM
6-21-56	AM
7-12-57	AM
10-2-57	AM
5-16-58	AM
1-28-60	AM

AVONDALE - GRAND-TUNNEL COLLIERY
MILLS VEIN
SCALE, 1 INCH = 400 FEET.