


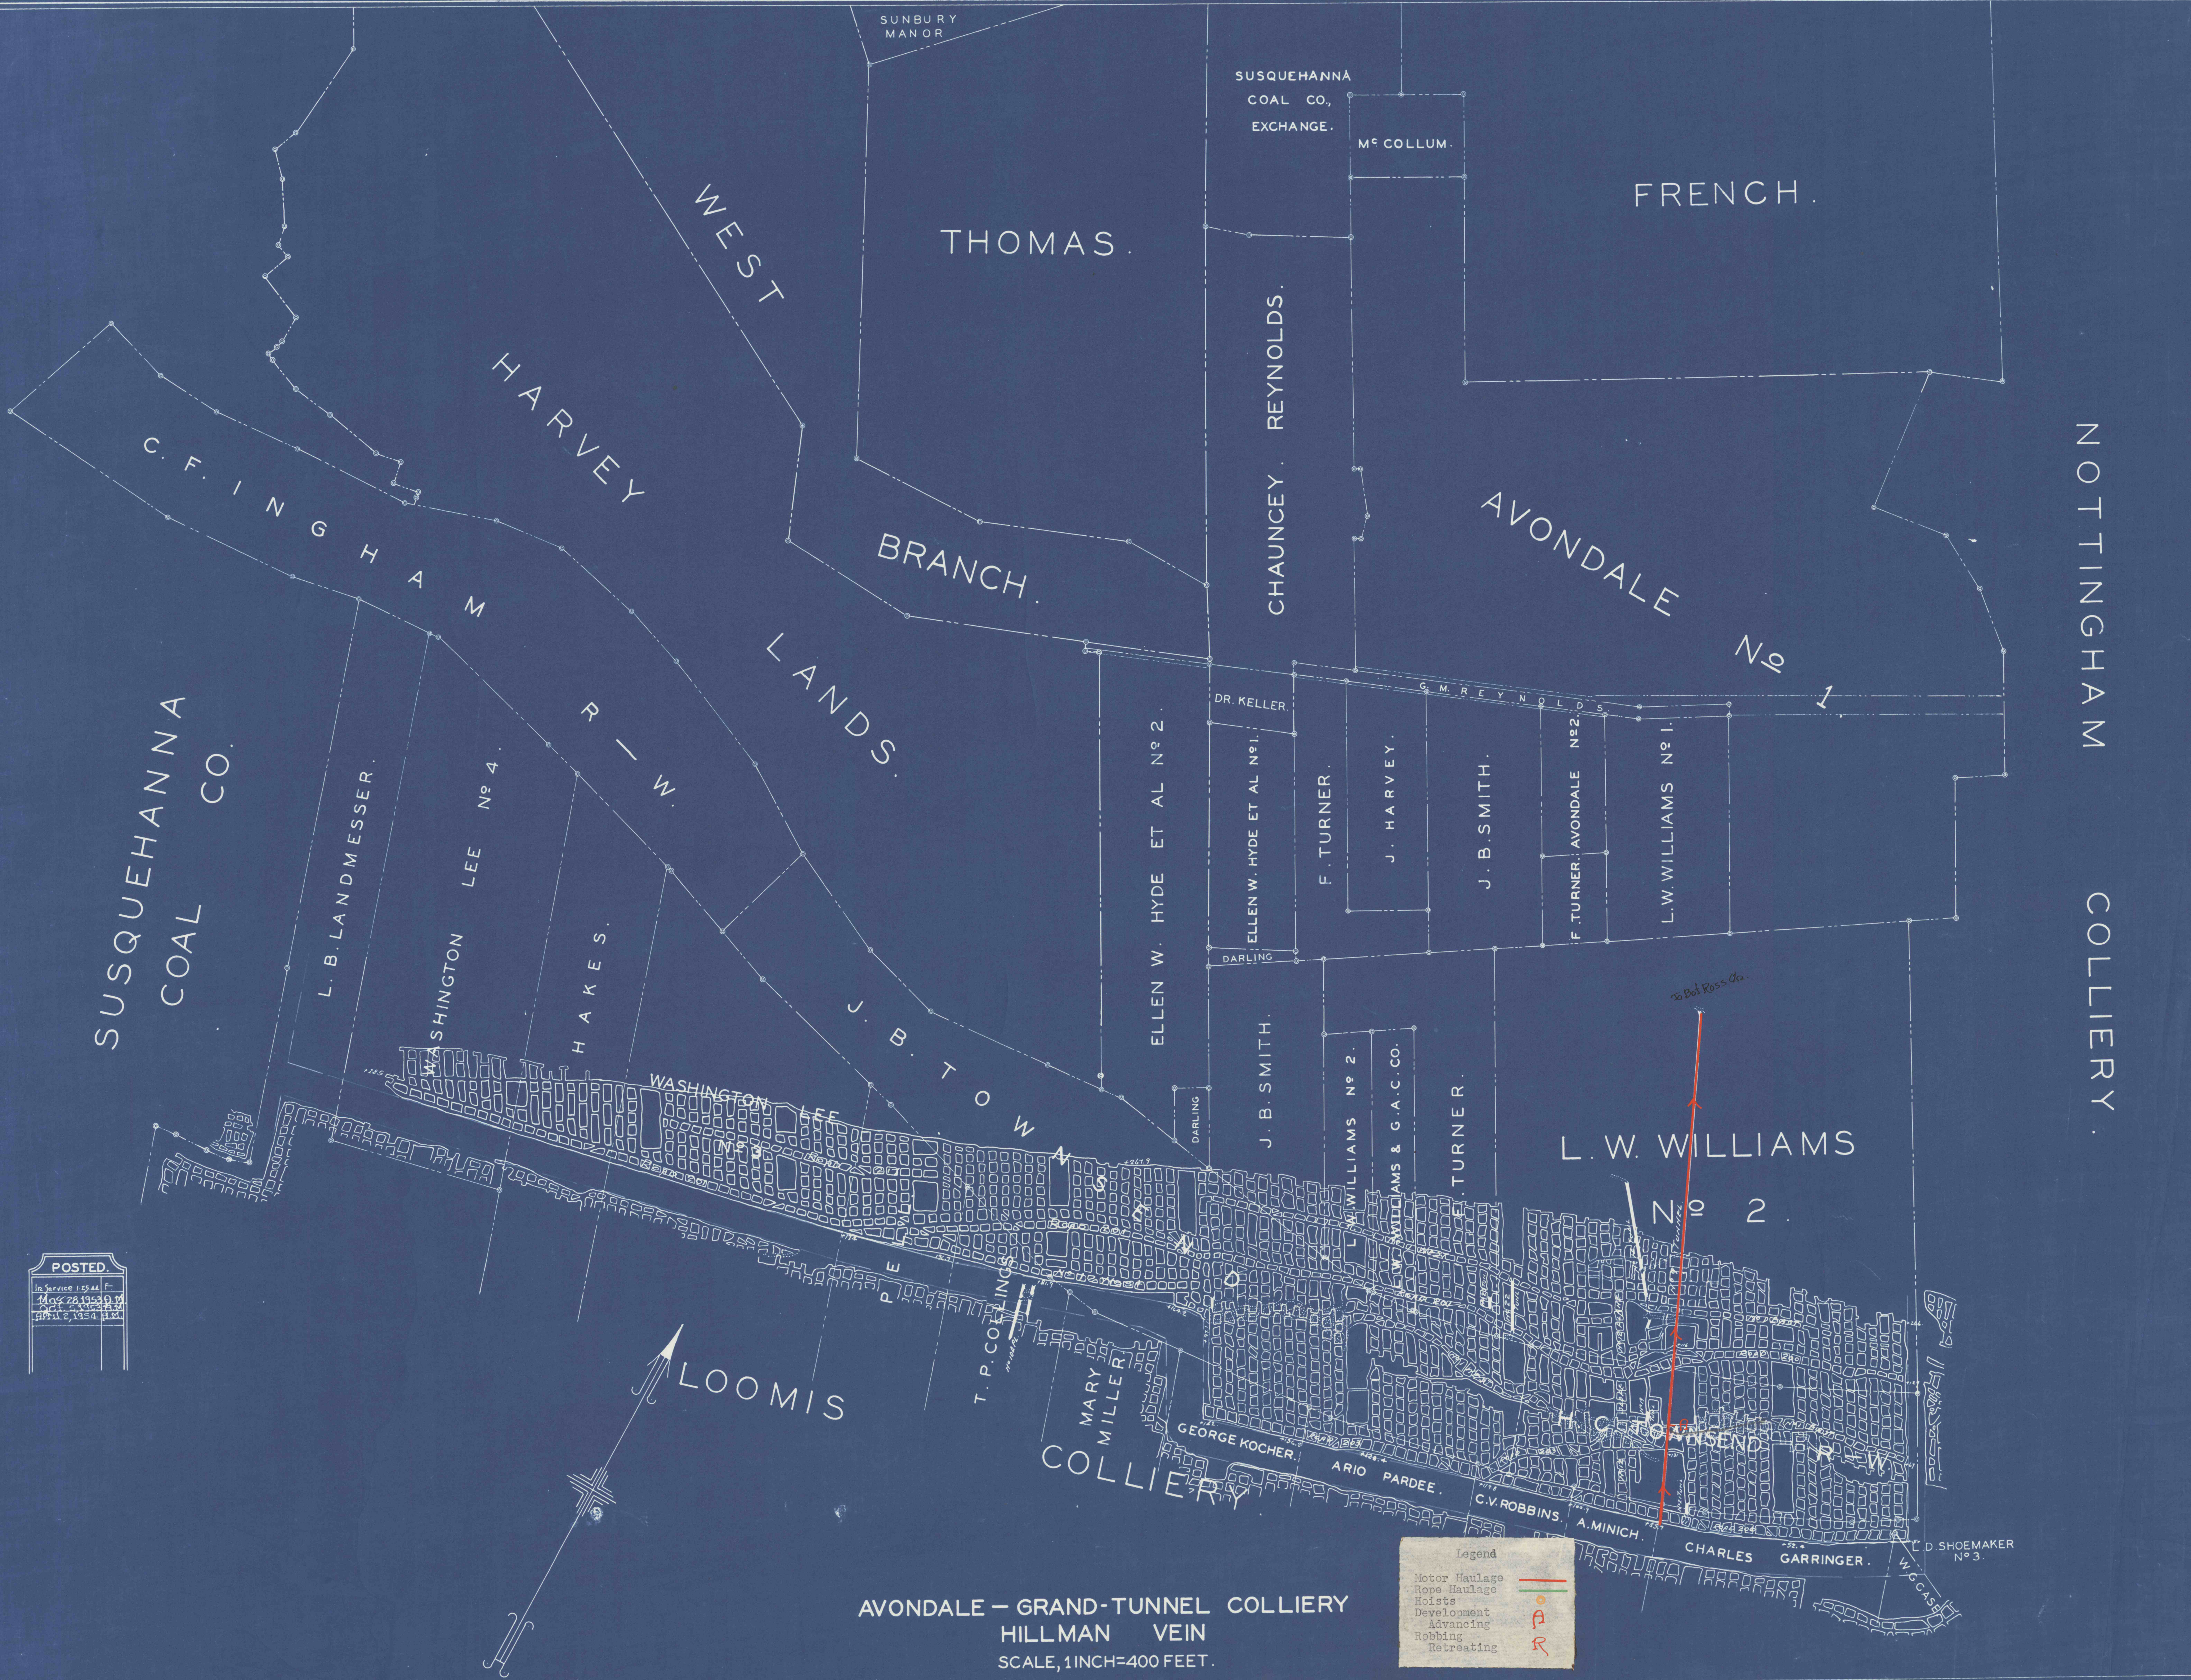

AVONDALE - GRAND-TUNNEL COLLIERY
HILLMAN VEIN
SCALE, 1 INCH=400 FEET.

Legend

- Motor Haulage
- Rope Haulage
- Hoists
- Development
- Advancing
- Robbing
- Retreating

POSTED
In Service 15544 E-
MAY 28 1954
MAY 2 1954