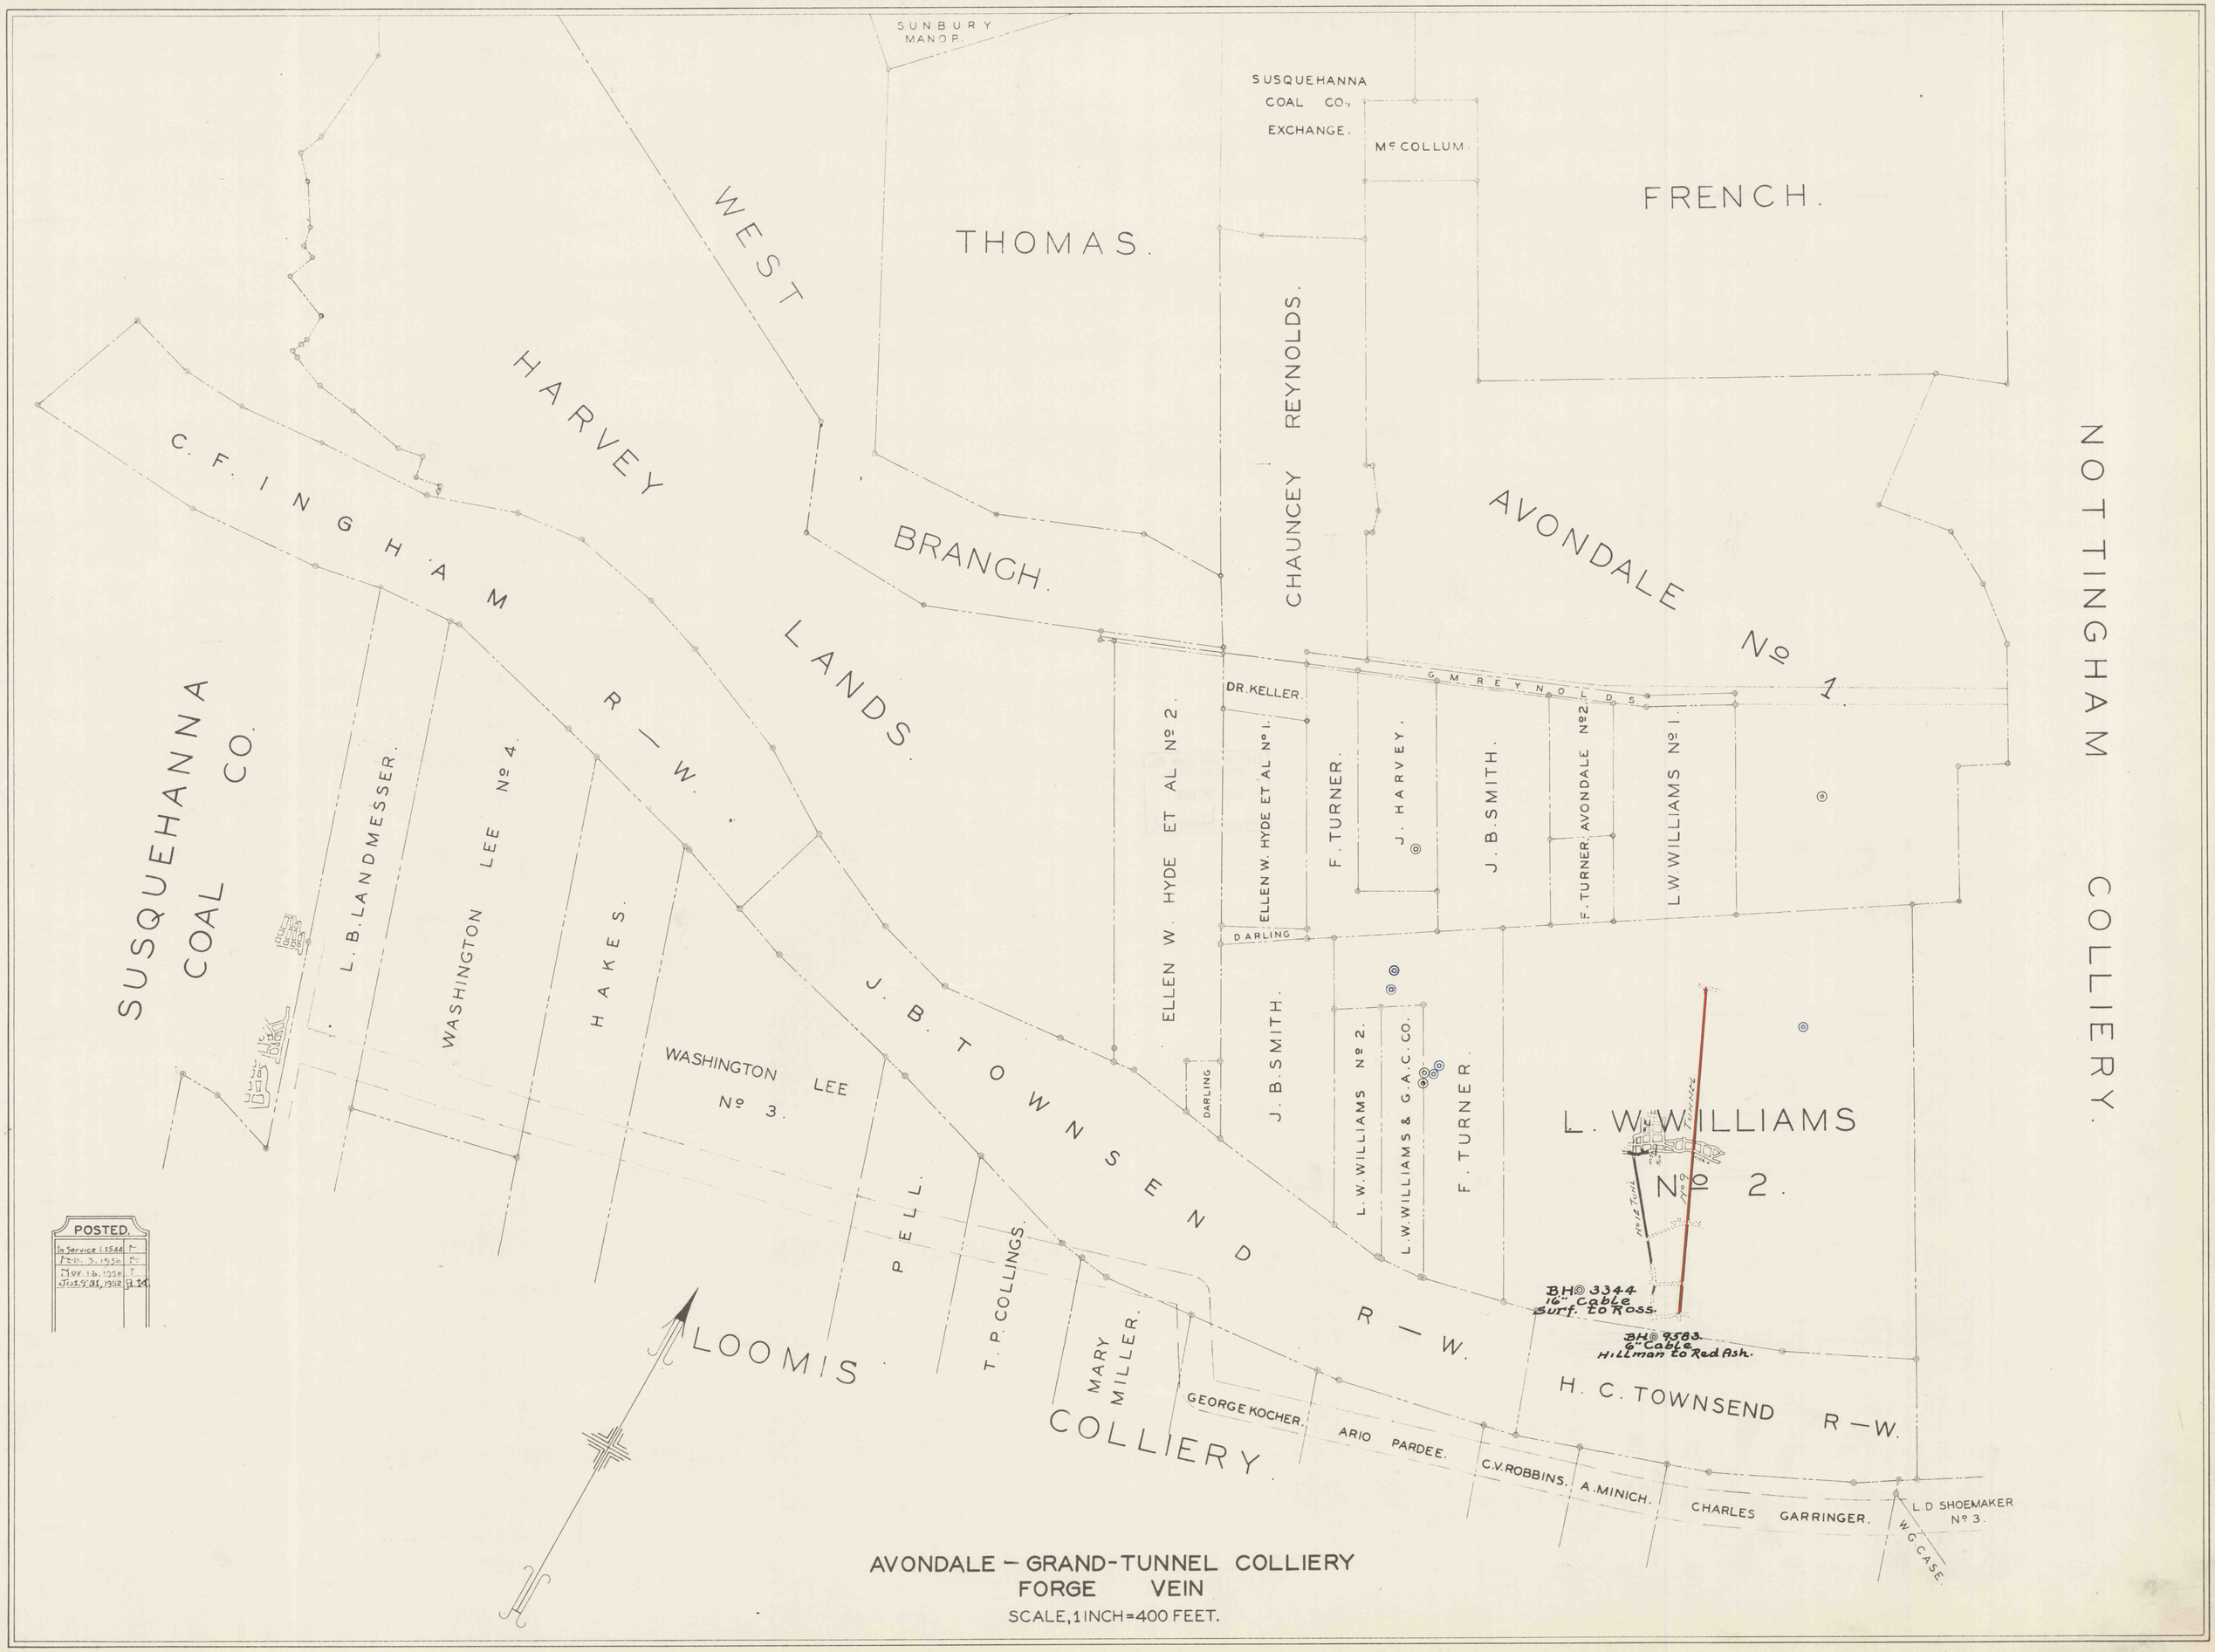


AVONDALE — GRAND-TUNNEL COLLIERY
FORGE VEIN
SCALE, 1 INCH = 400 FEET.