


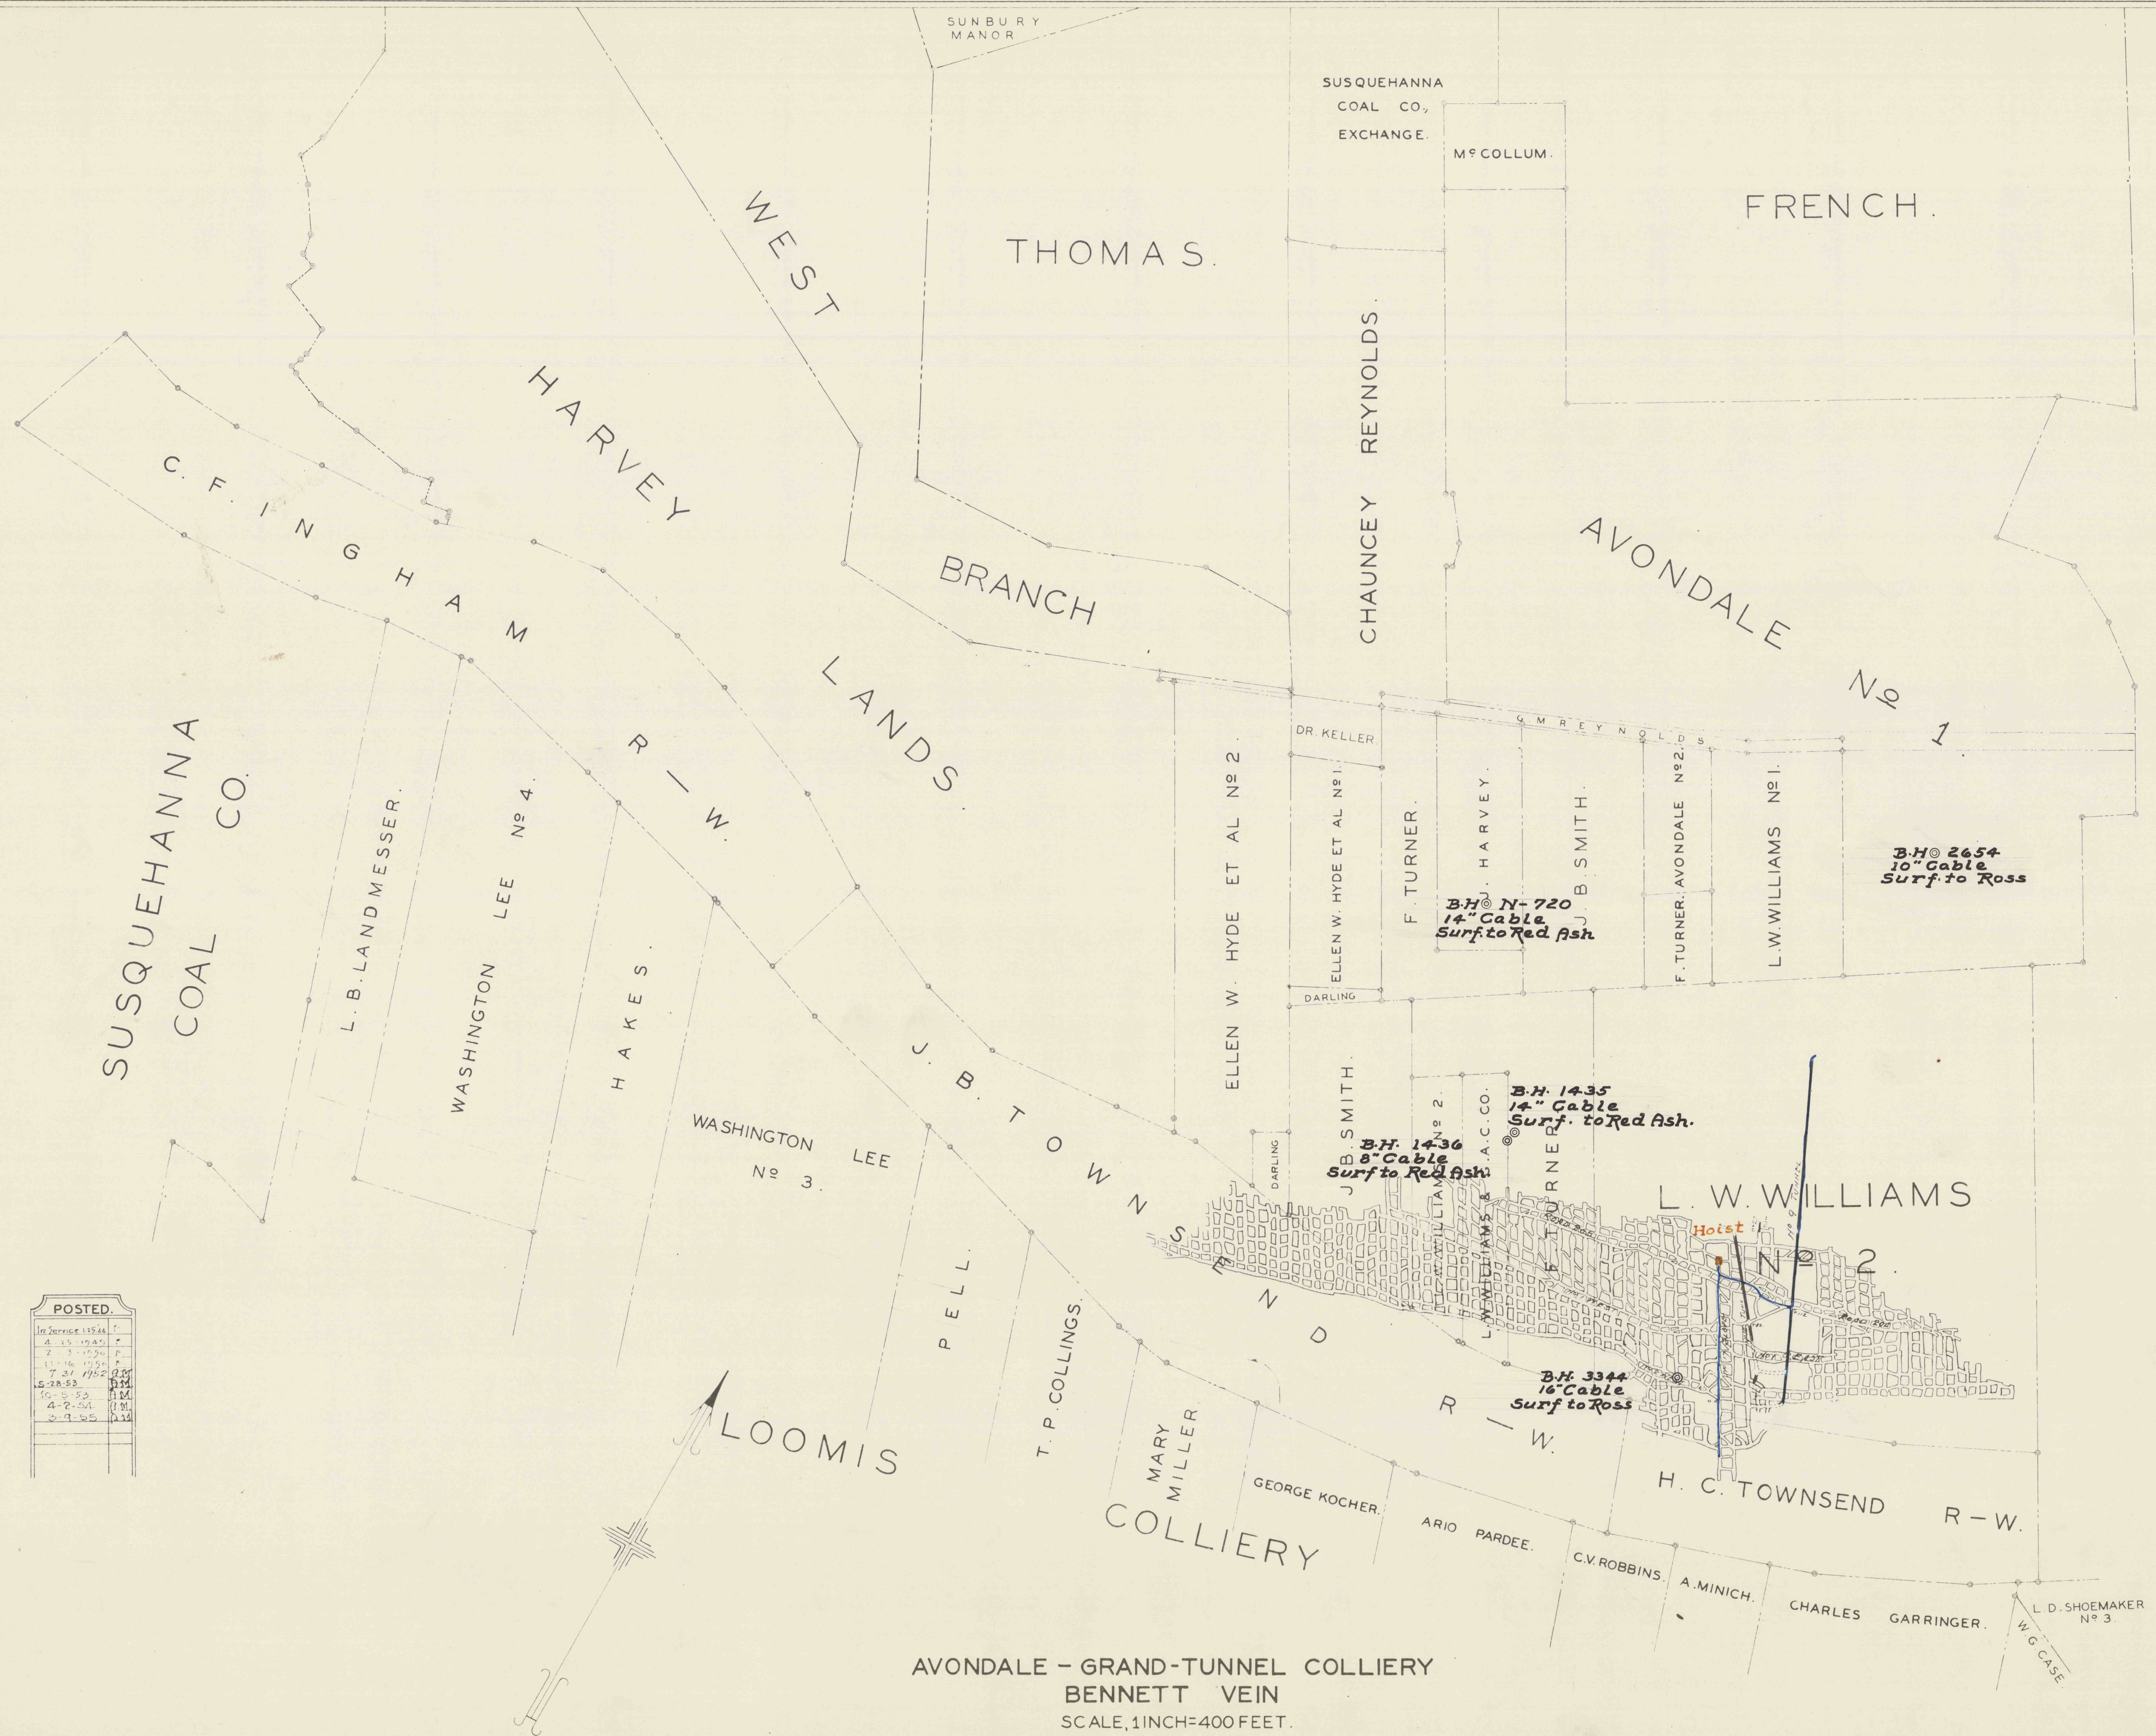

POSTED.	
1st Service 1924	
4-25-1925	
2-3-1926	
11-16-1926	
7-31-1927	
5-28-28	
10-5-28	
4-2-29	
2-9-29	

AVONDALE - GRAND-TUNNEL COLLIERY
BENNETT VEIN
SCALE, 1 INCH = 400 FEET.