


NOTTINGHAM COLLIERY

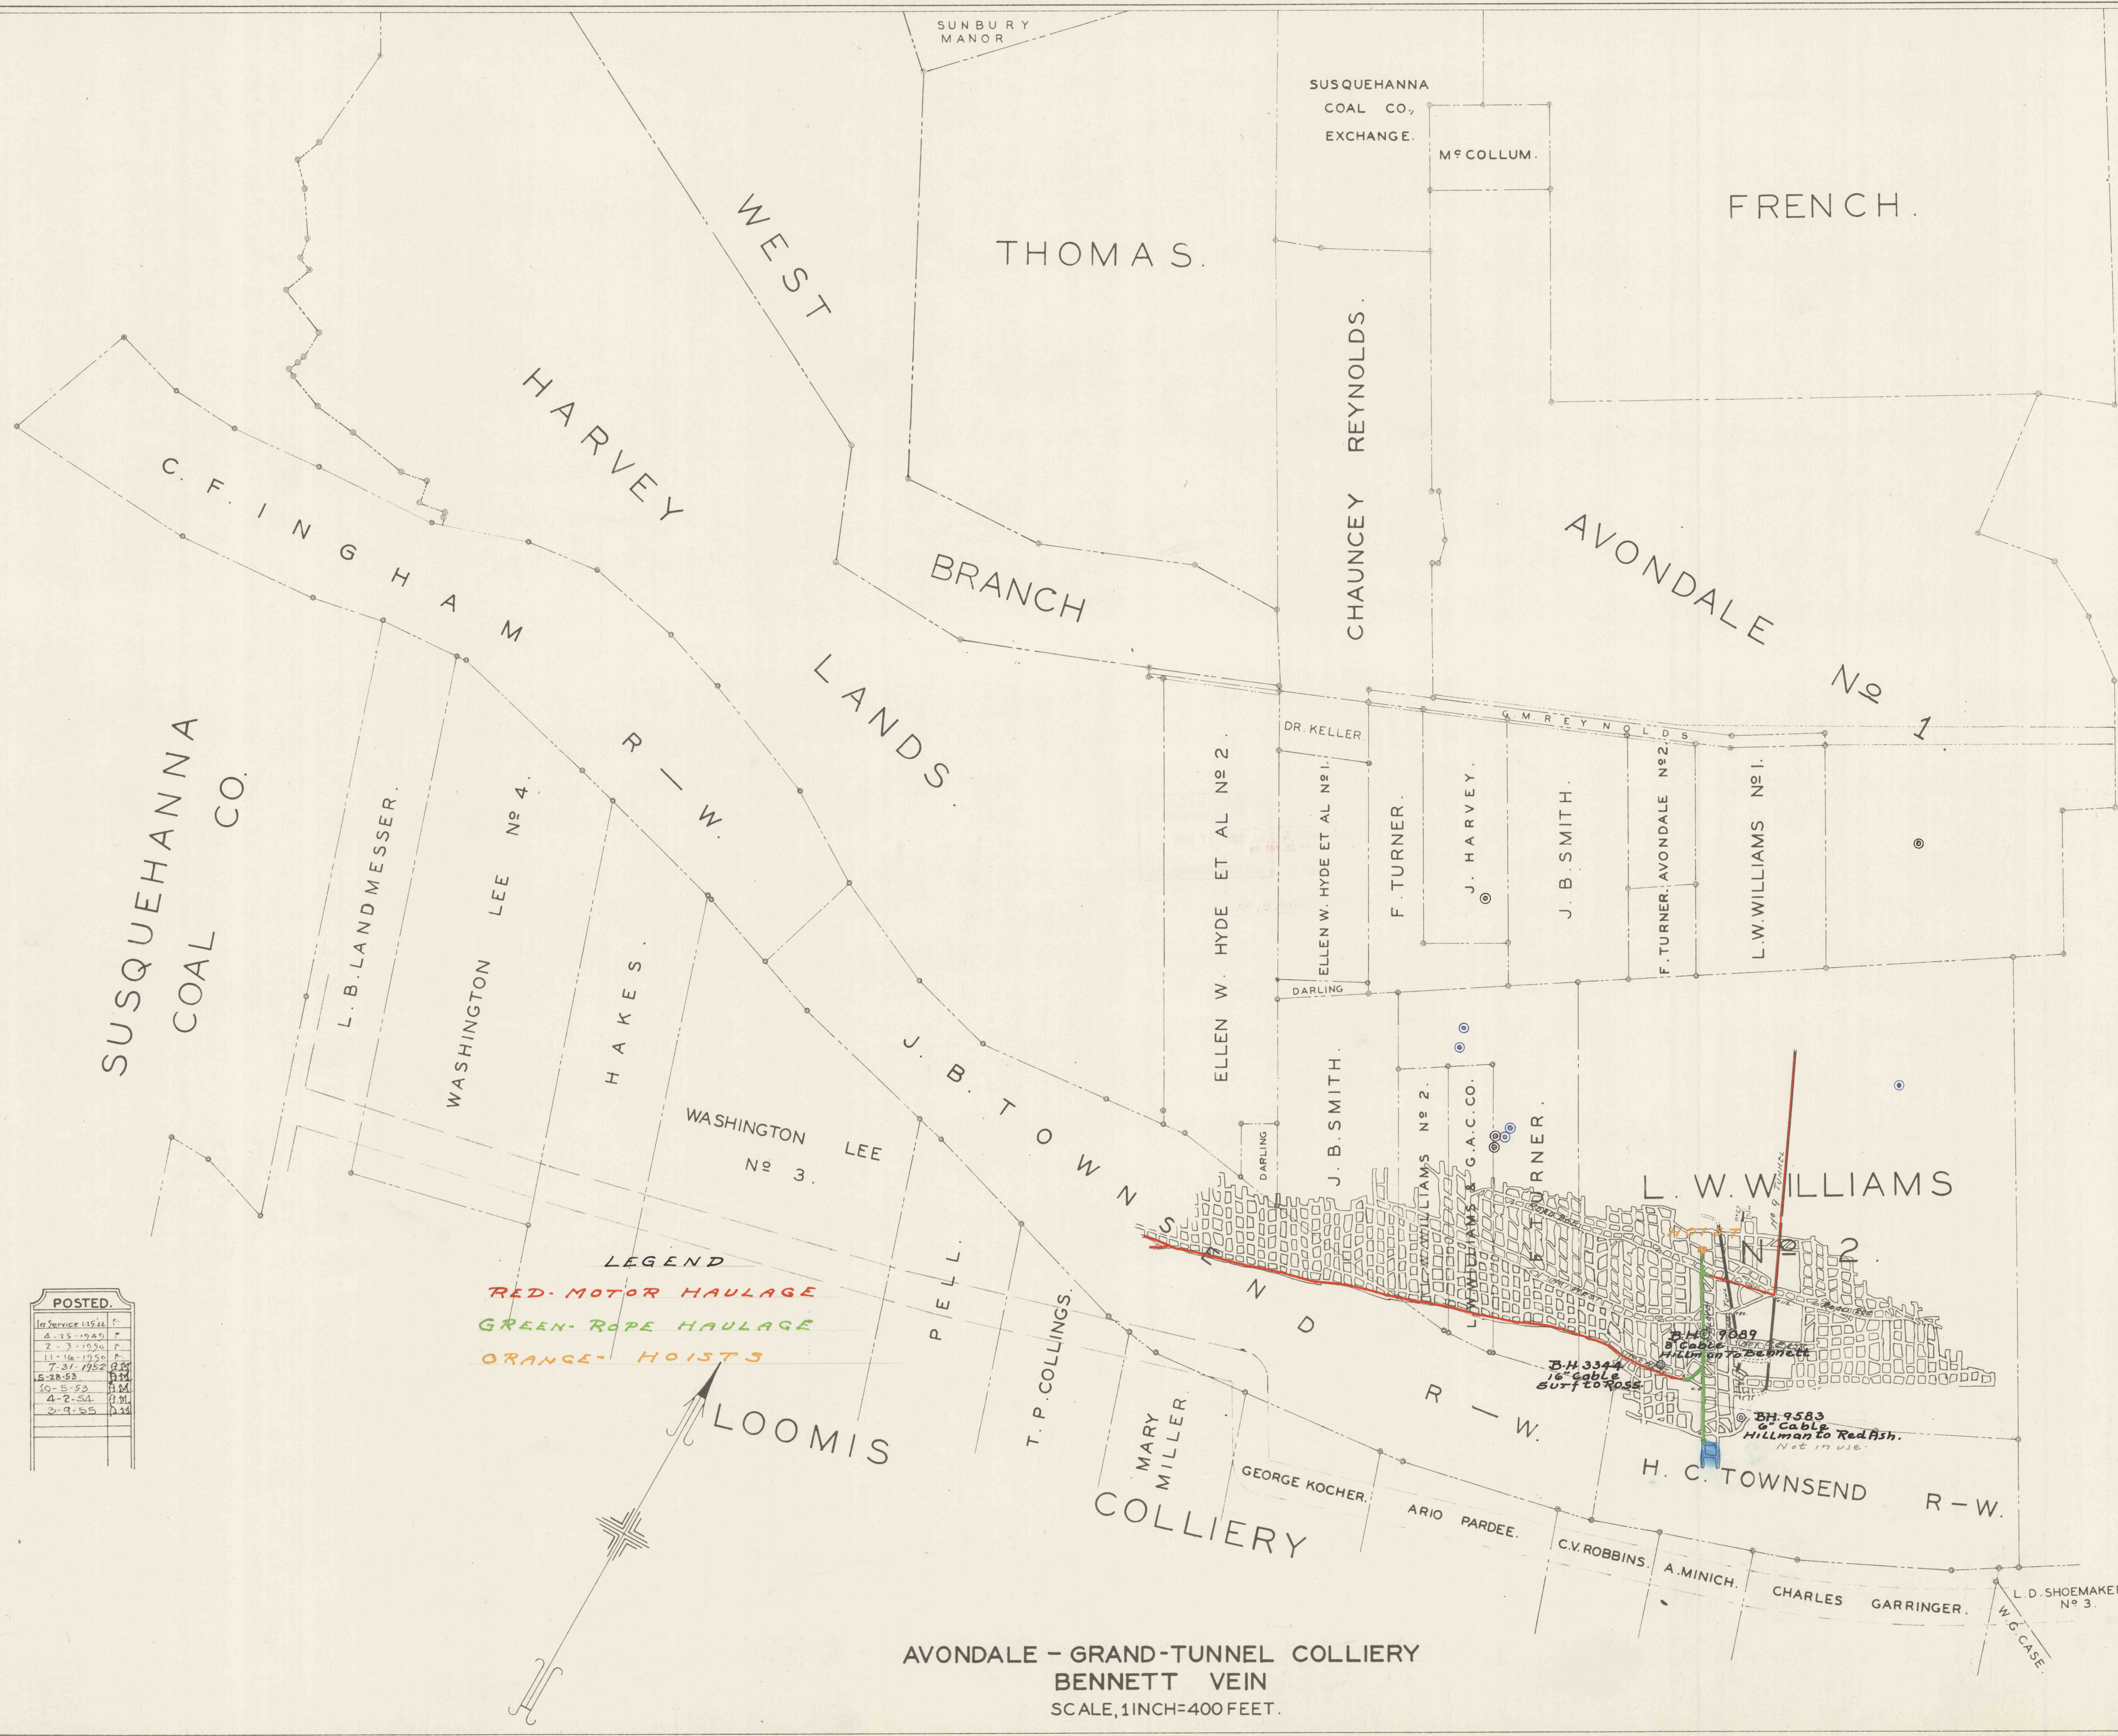

POSTED.	
In Service 11544	F
4-15-1949	F
2-3-1950	F
11-16-1950	F
7-31-1952	F
5-28-53	F
50-5-53	F
4-2-54	F
2-9-55	F