


| POSTED.               |  |
|-----------------------|--|
| IN SERVICE 4, 1944 F. |  |
| MAY 1, 45 F.          |  |
| MAY 9, 46 F.          |  |
| JAN. 6, 47 F.         |  |
| NOV. 22, 47 F.        |  |
| JULY 27, 48 F.        |  |
| APR. 15, 1949 F.      |  |

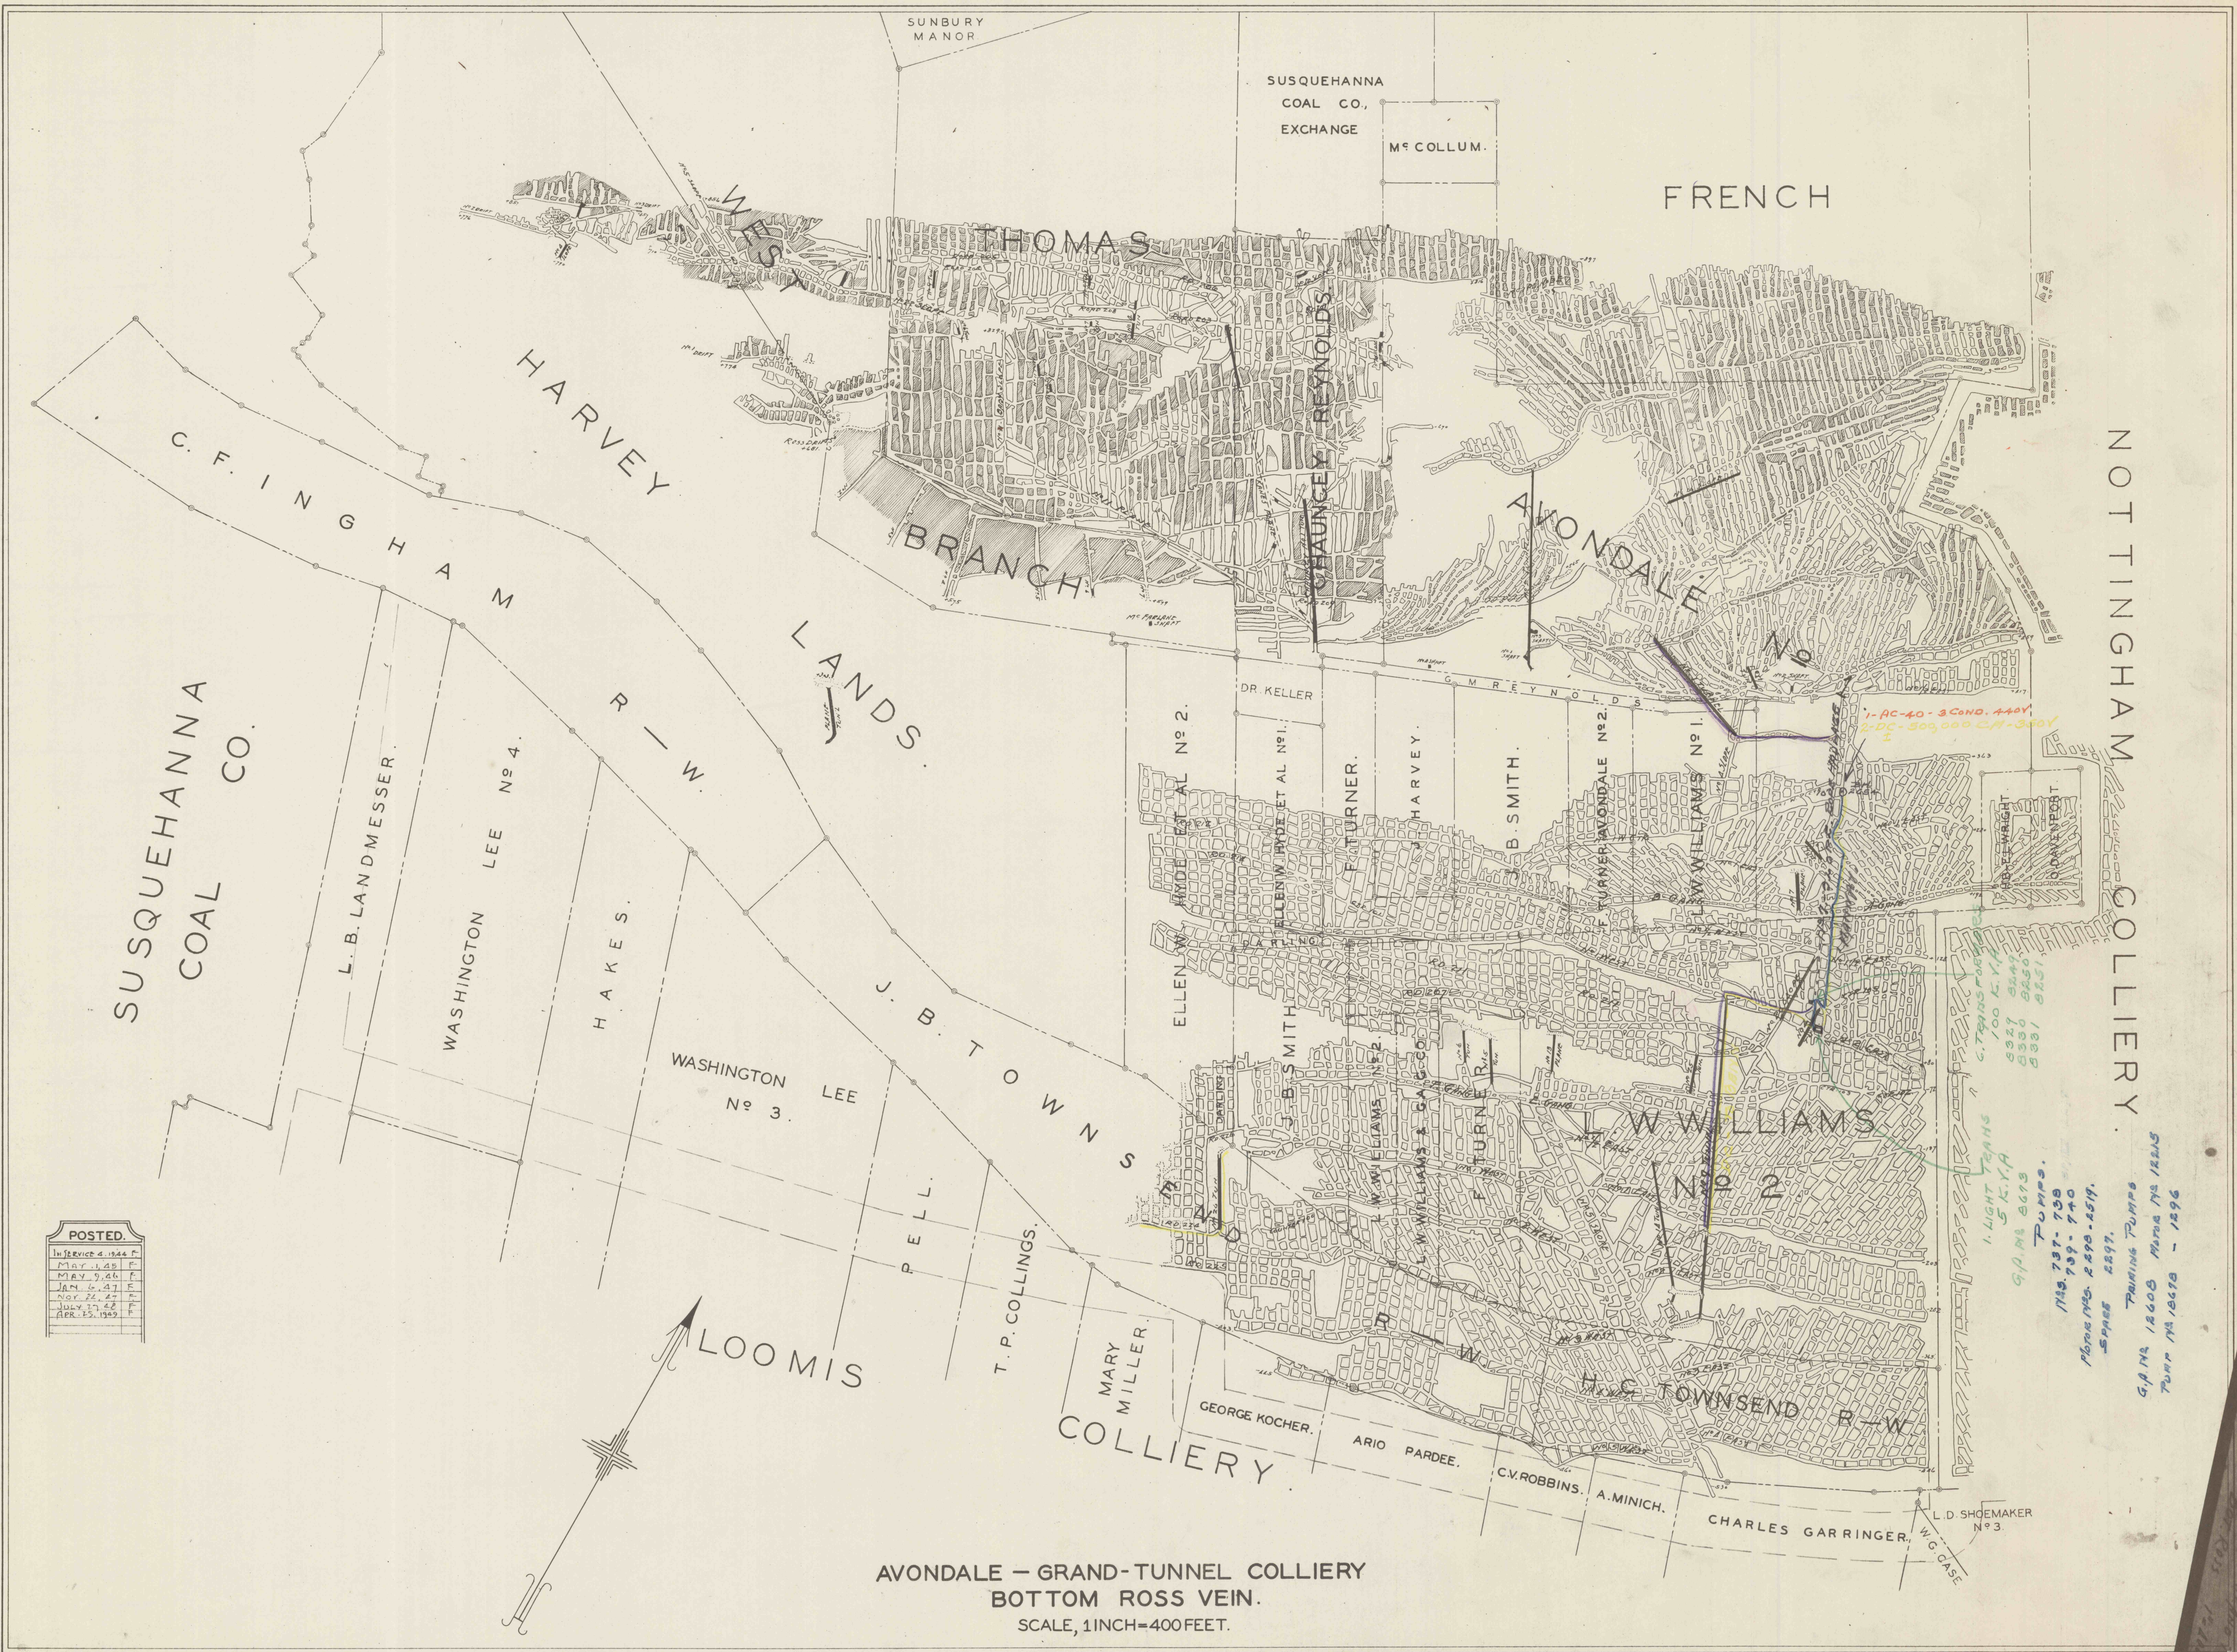

NOTTINGHAM COLLIERY

1-AC-40-3 COND. 440V  
 2-DC-500,000 2M-350V

100 K.Y.A.  
 8327 8247  
 8350 8250  
 8381 8251

1. LIGHT TRAMS  
 5 K.Y.A.  
 G.A. No. 8613

PUMPS.  
 Nos. 737-738  
 Phone Nos. 2295-2519.  
 SPARE 2897.

TRAINING PUMPS.  
 G.A. No. 12608 Motor No. 12613  
 Pump No. 12619 - 1296