


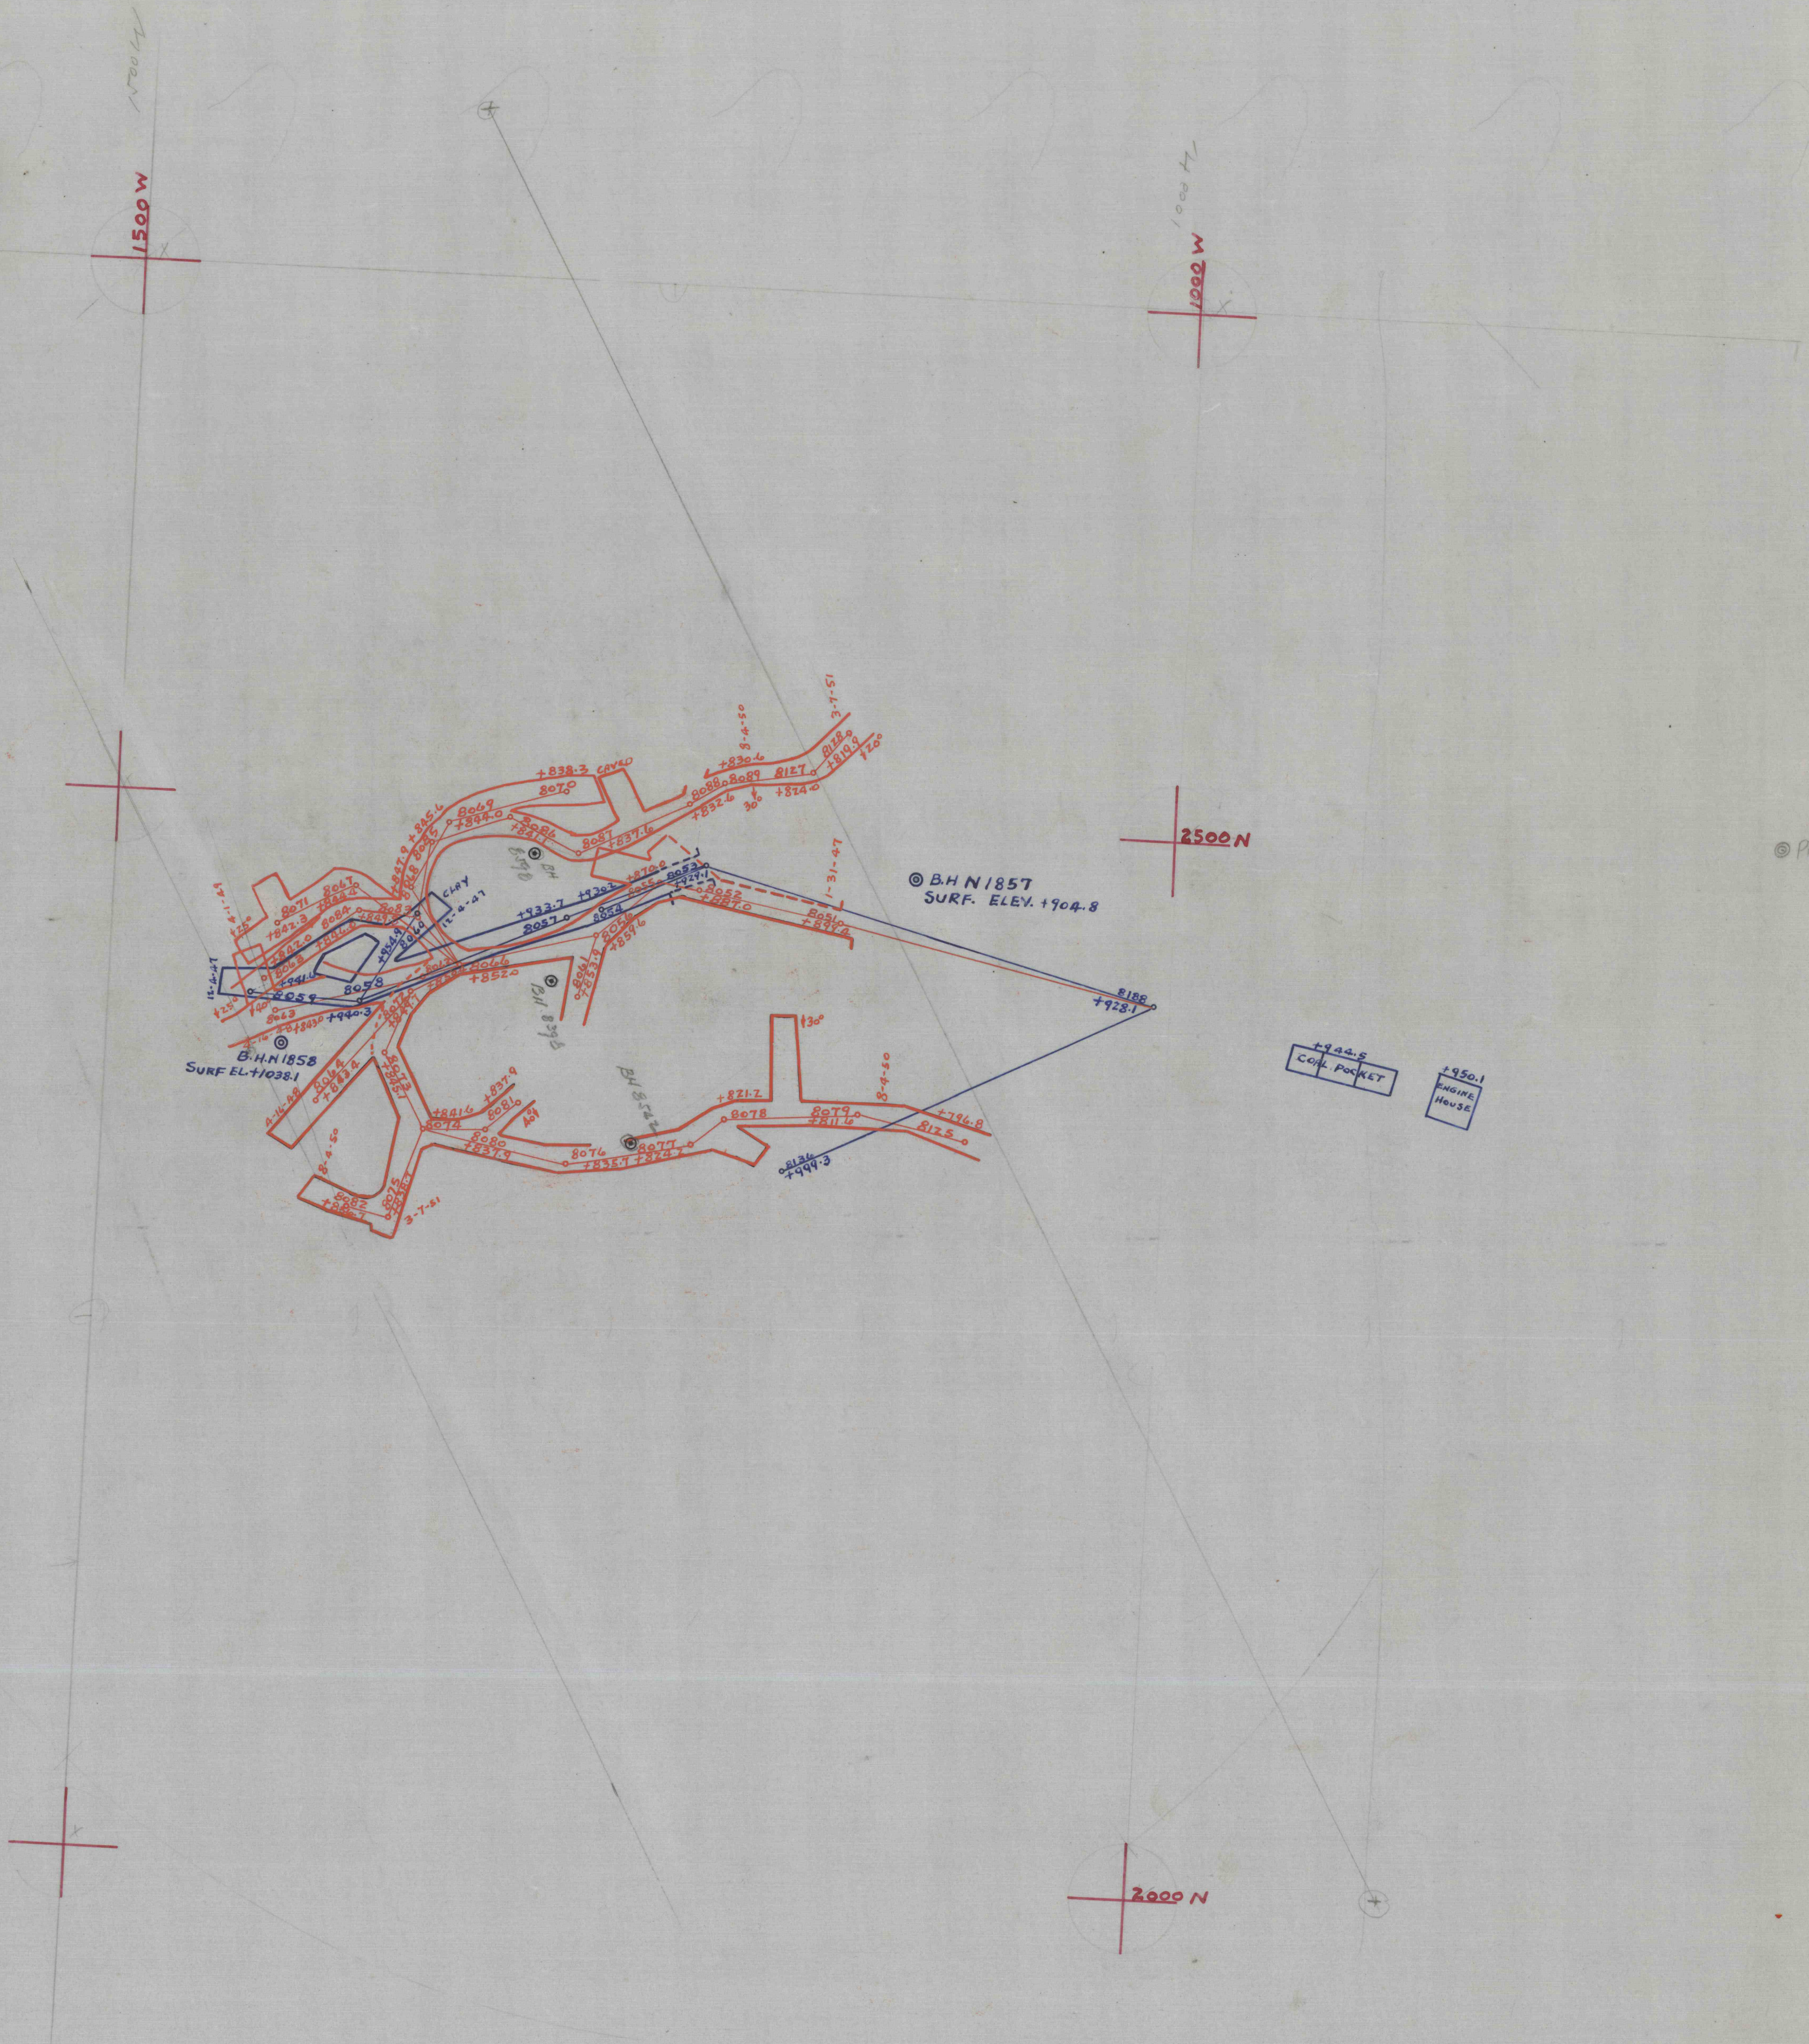

© Prop. B.H. #3

OSCAR YOUNG'S WORKINGS
FILE WITH JERSEY RED ASH
1" = 50'