


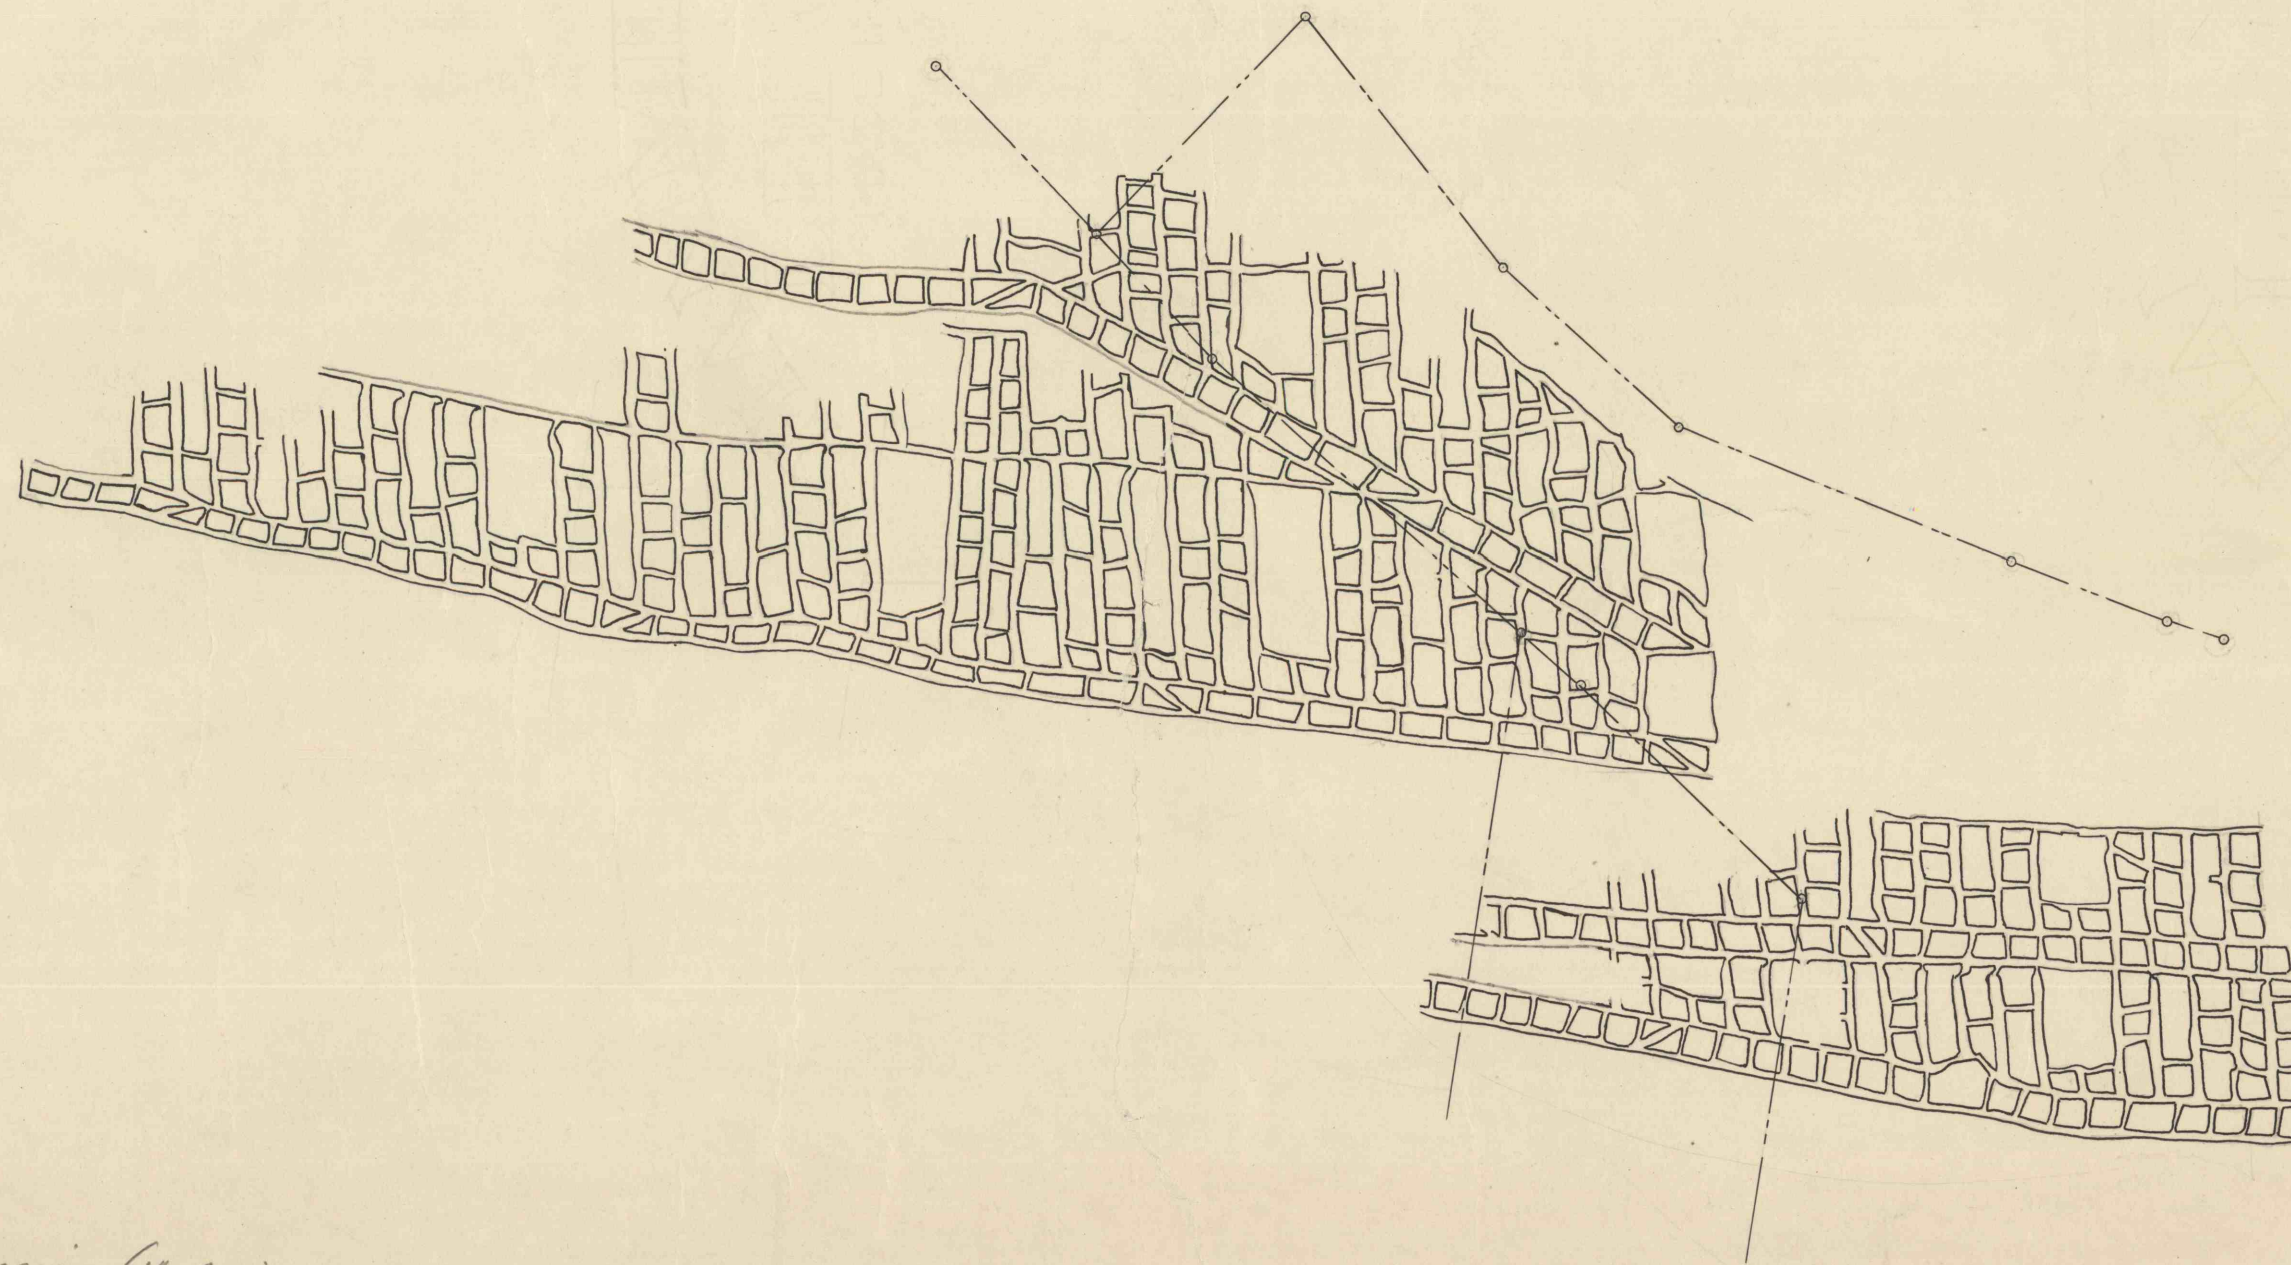

Arondale - Grand Tunnel.

Red Ash Vein

1" = 400'

Keep with Grand Tunnel Red Ash Tracing (1" = 400')

Posted Nov. 2, 1943.

1/2 future
postings
add 2 more
rows of pillars