


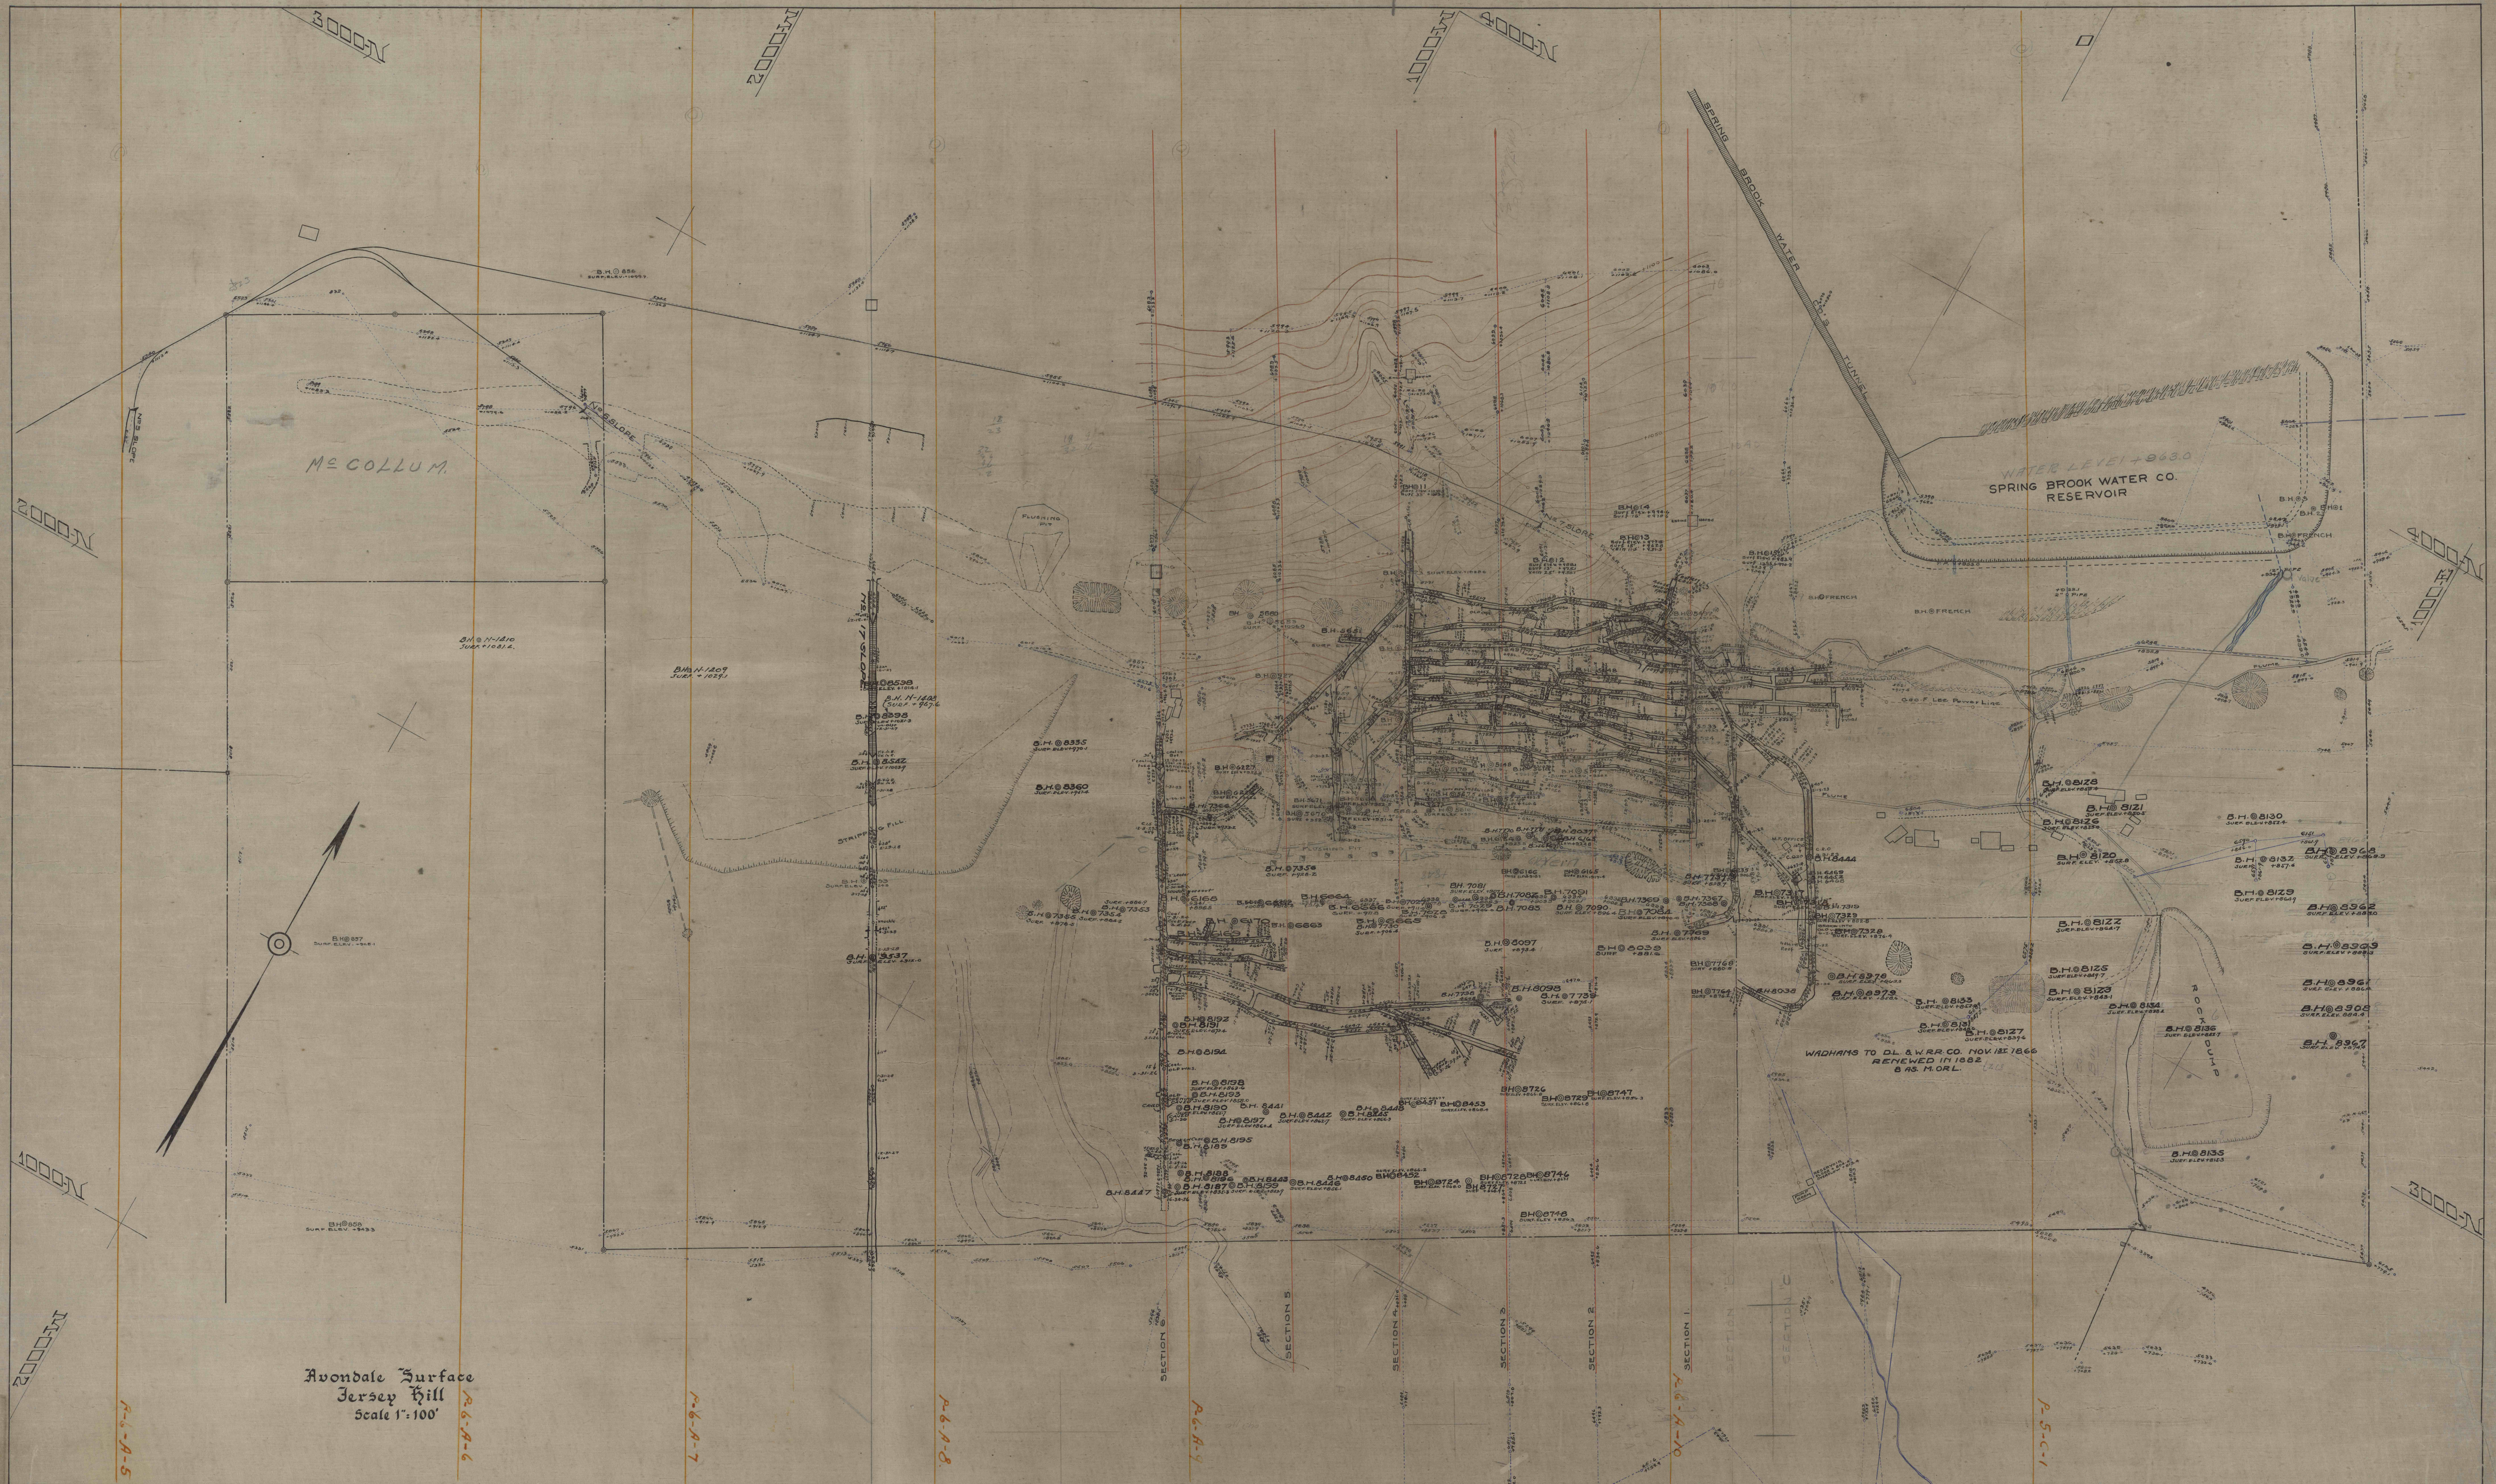

Avondale Surface
Jersey Hill
Scale 1"=100'