


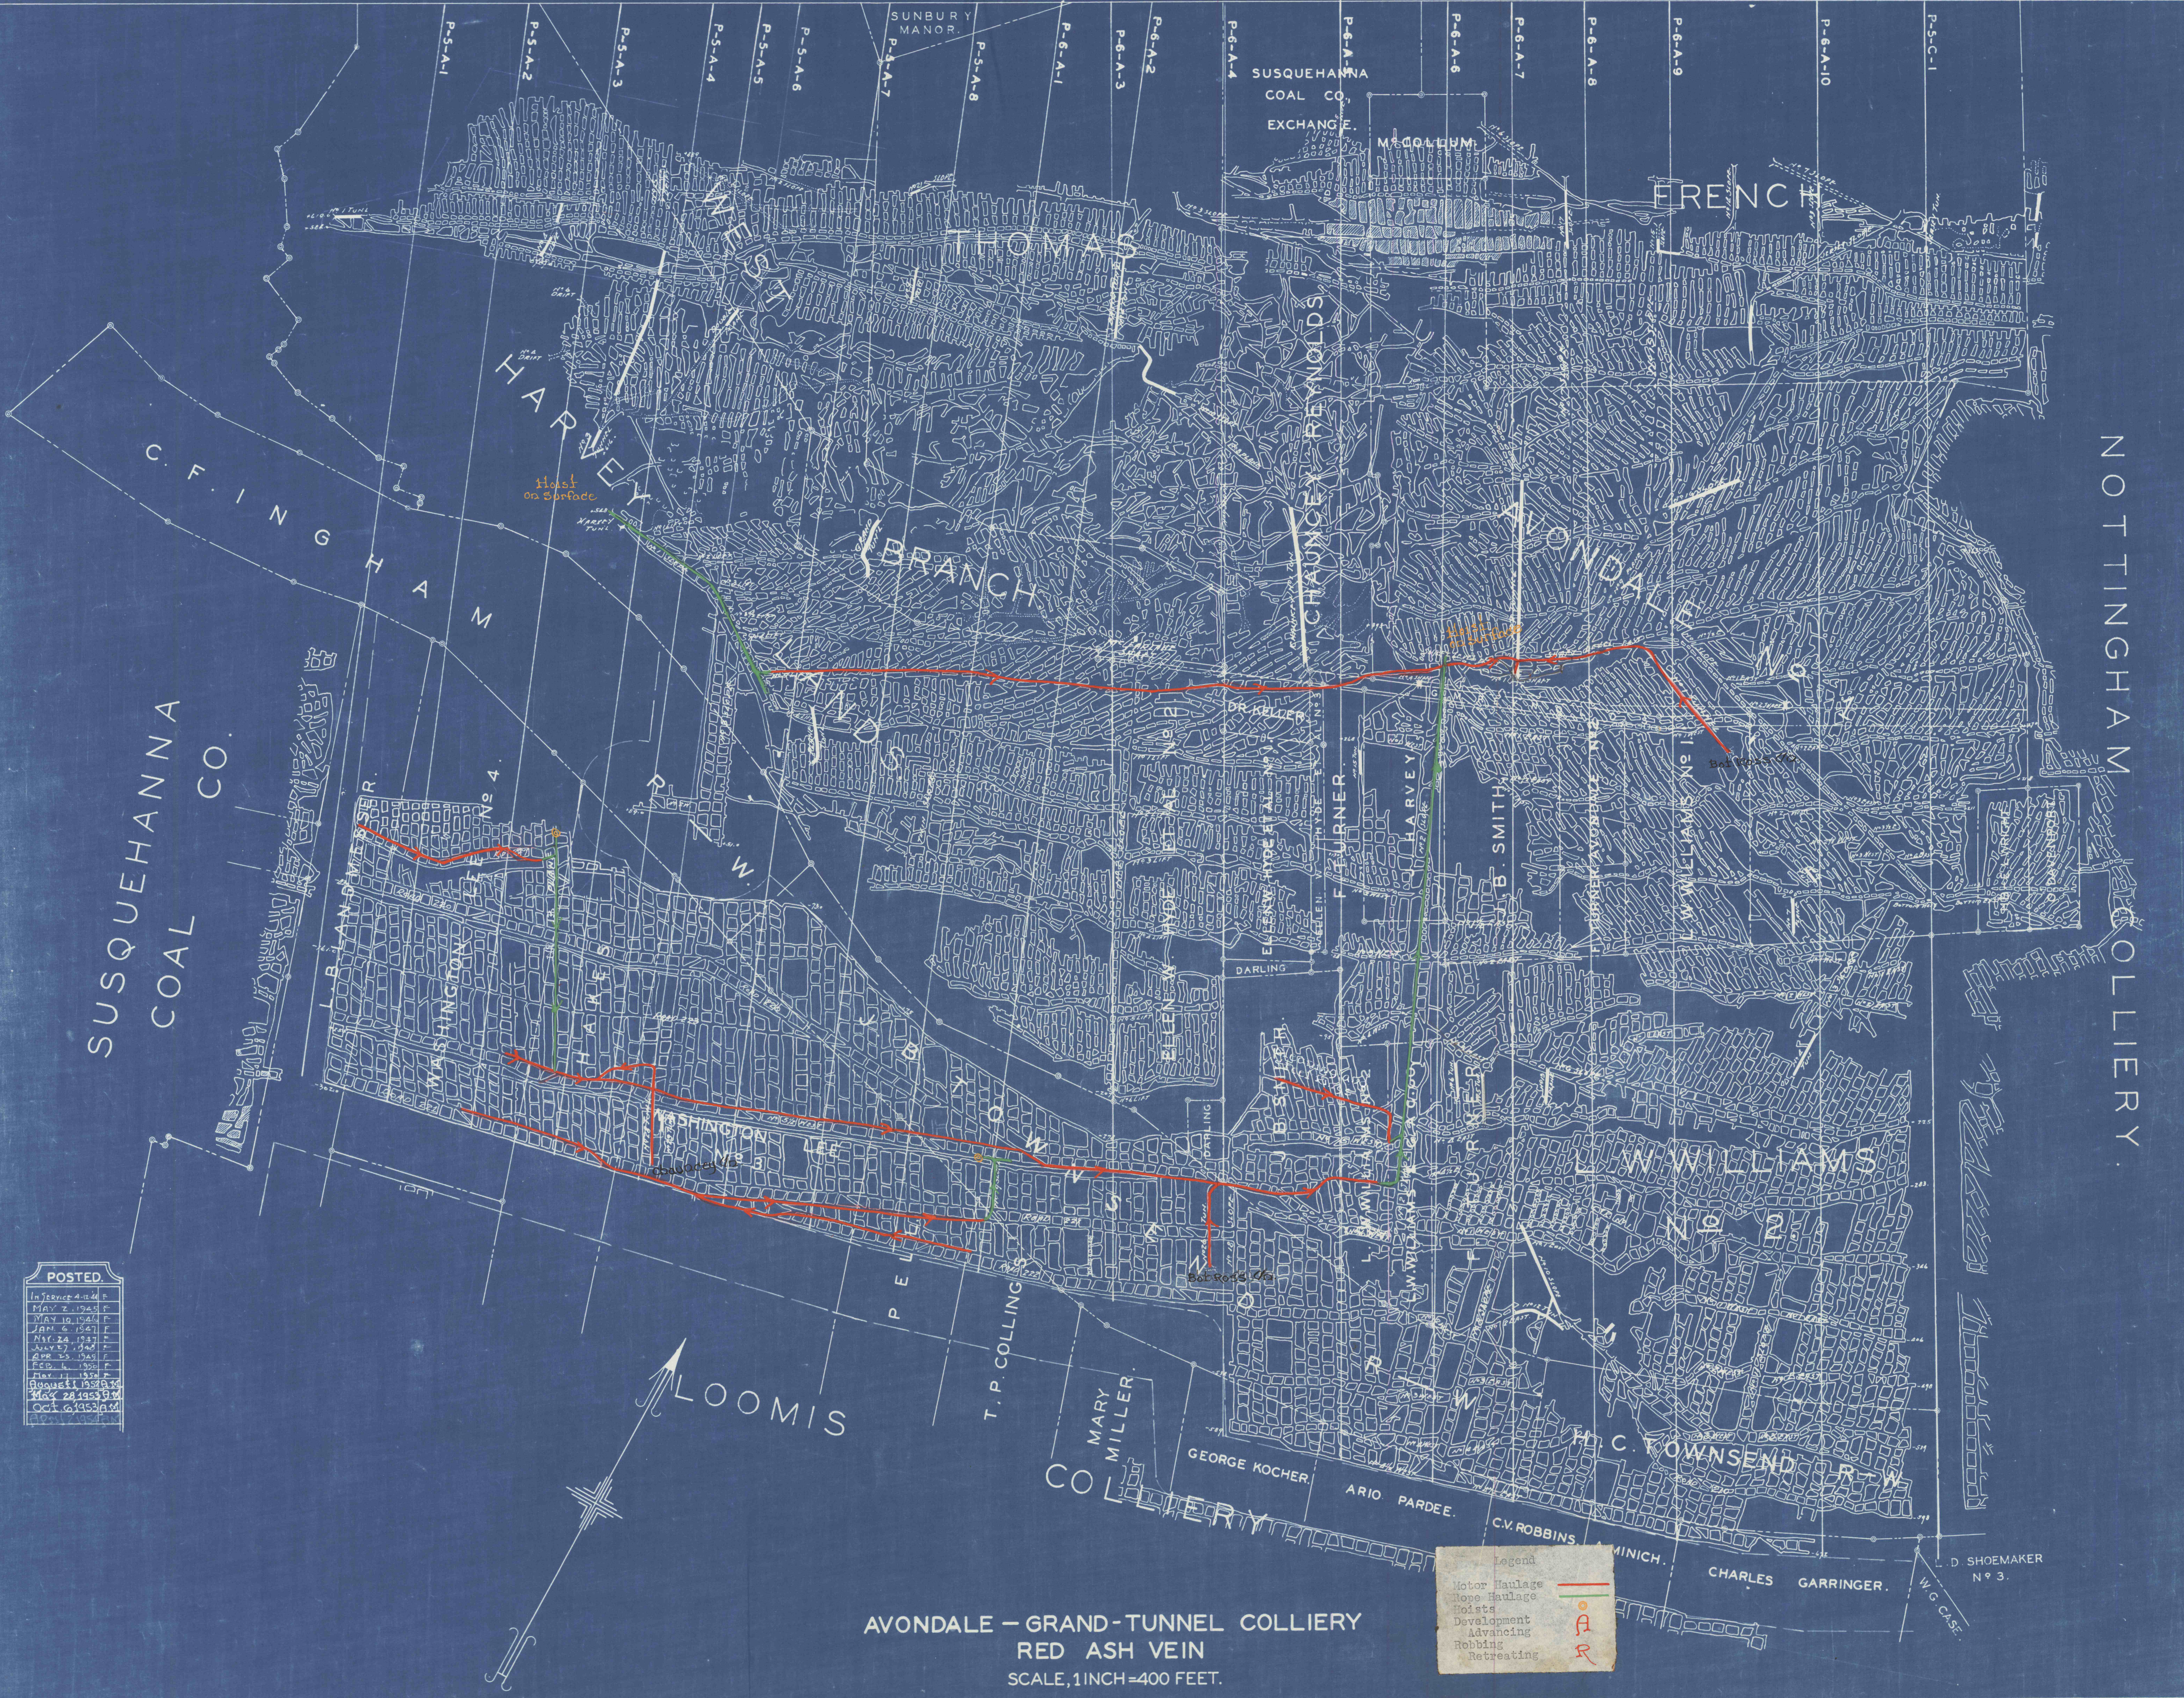

POSTED	
Instruct	4-12-46 P.
MAY 2	1946 F.
MAY 10	1946 F.
JAN 6	1947 F.
MAY 22	1947 F.
JULY 27	1948 F.
SEP 25	1948 F.
DEC 11	1948 F.
Revised	1949 M.
MAY 28	1953 M.
OCT 6	1953 M.

Legend

Motor Haulage	—
Rope Haulage	—
Points	•
Development	—
Advancing	—
Robbing	—
Retreating	—

A
R

AVONDALE - GRAND-TUNNEL COLLIERY
RED ASH VEIN
SCALE, 1 INCH = 400 FEET.