


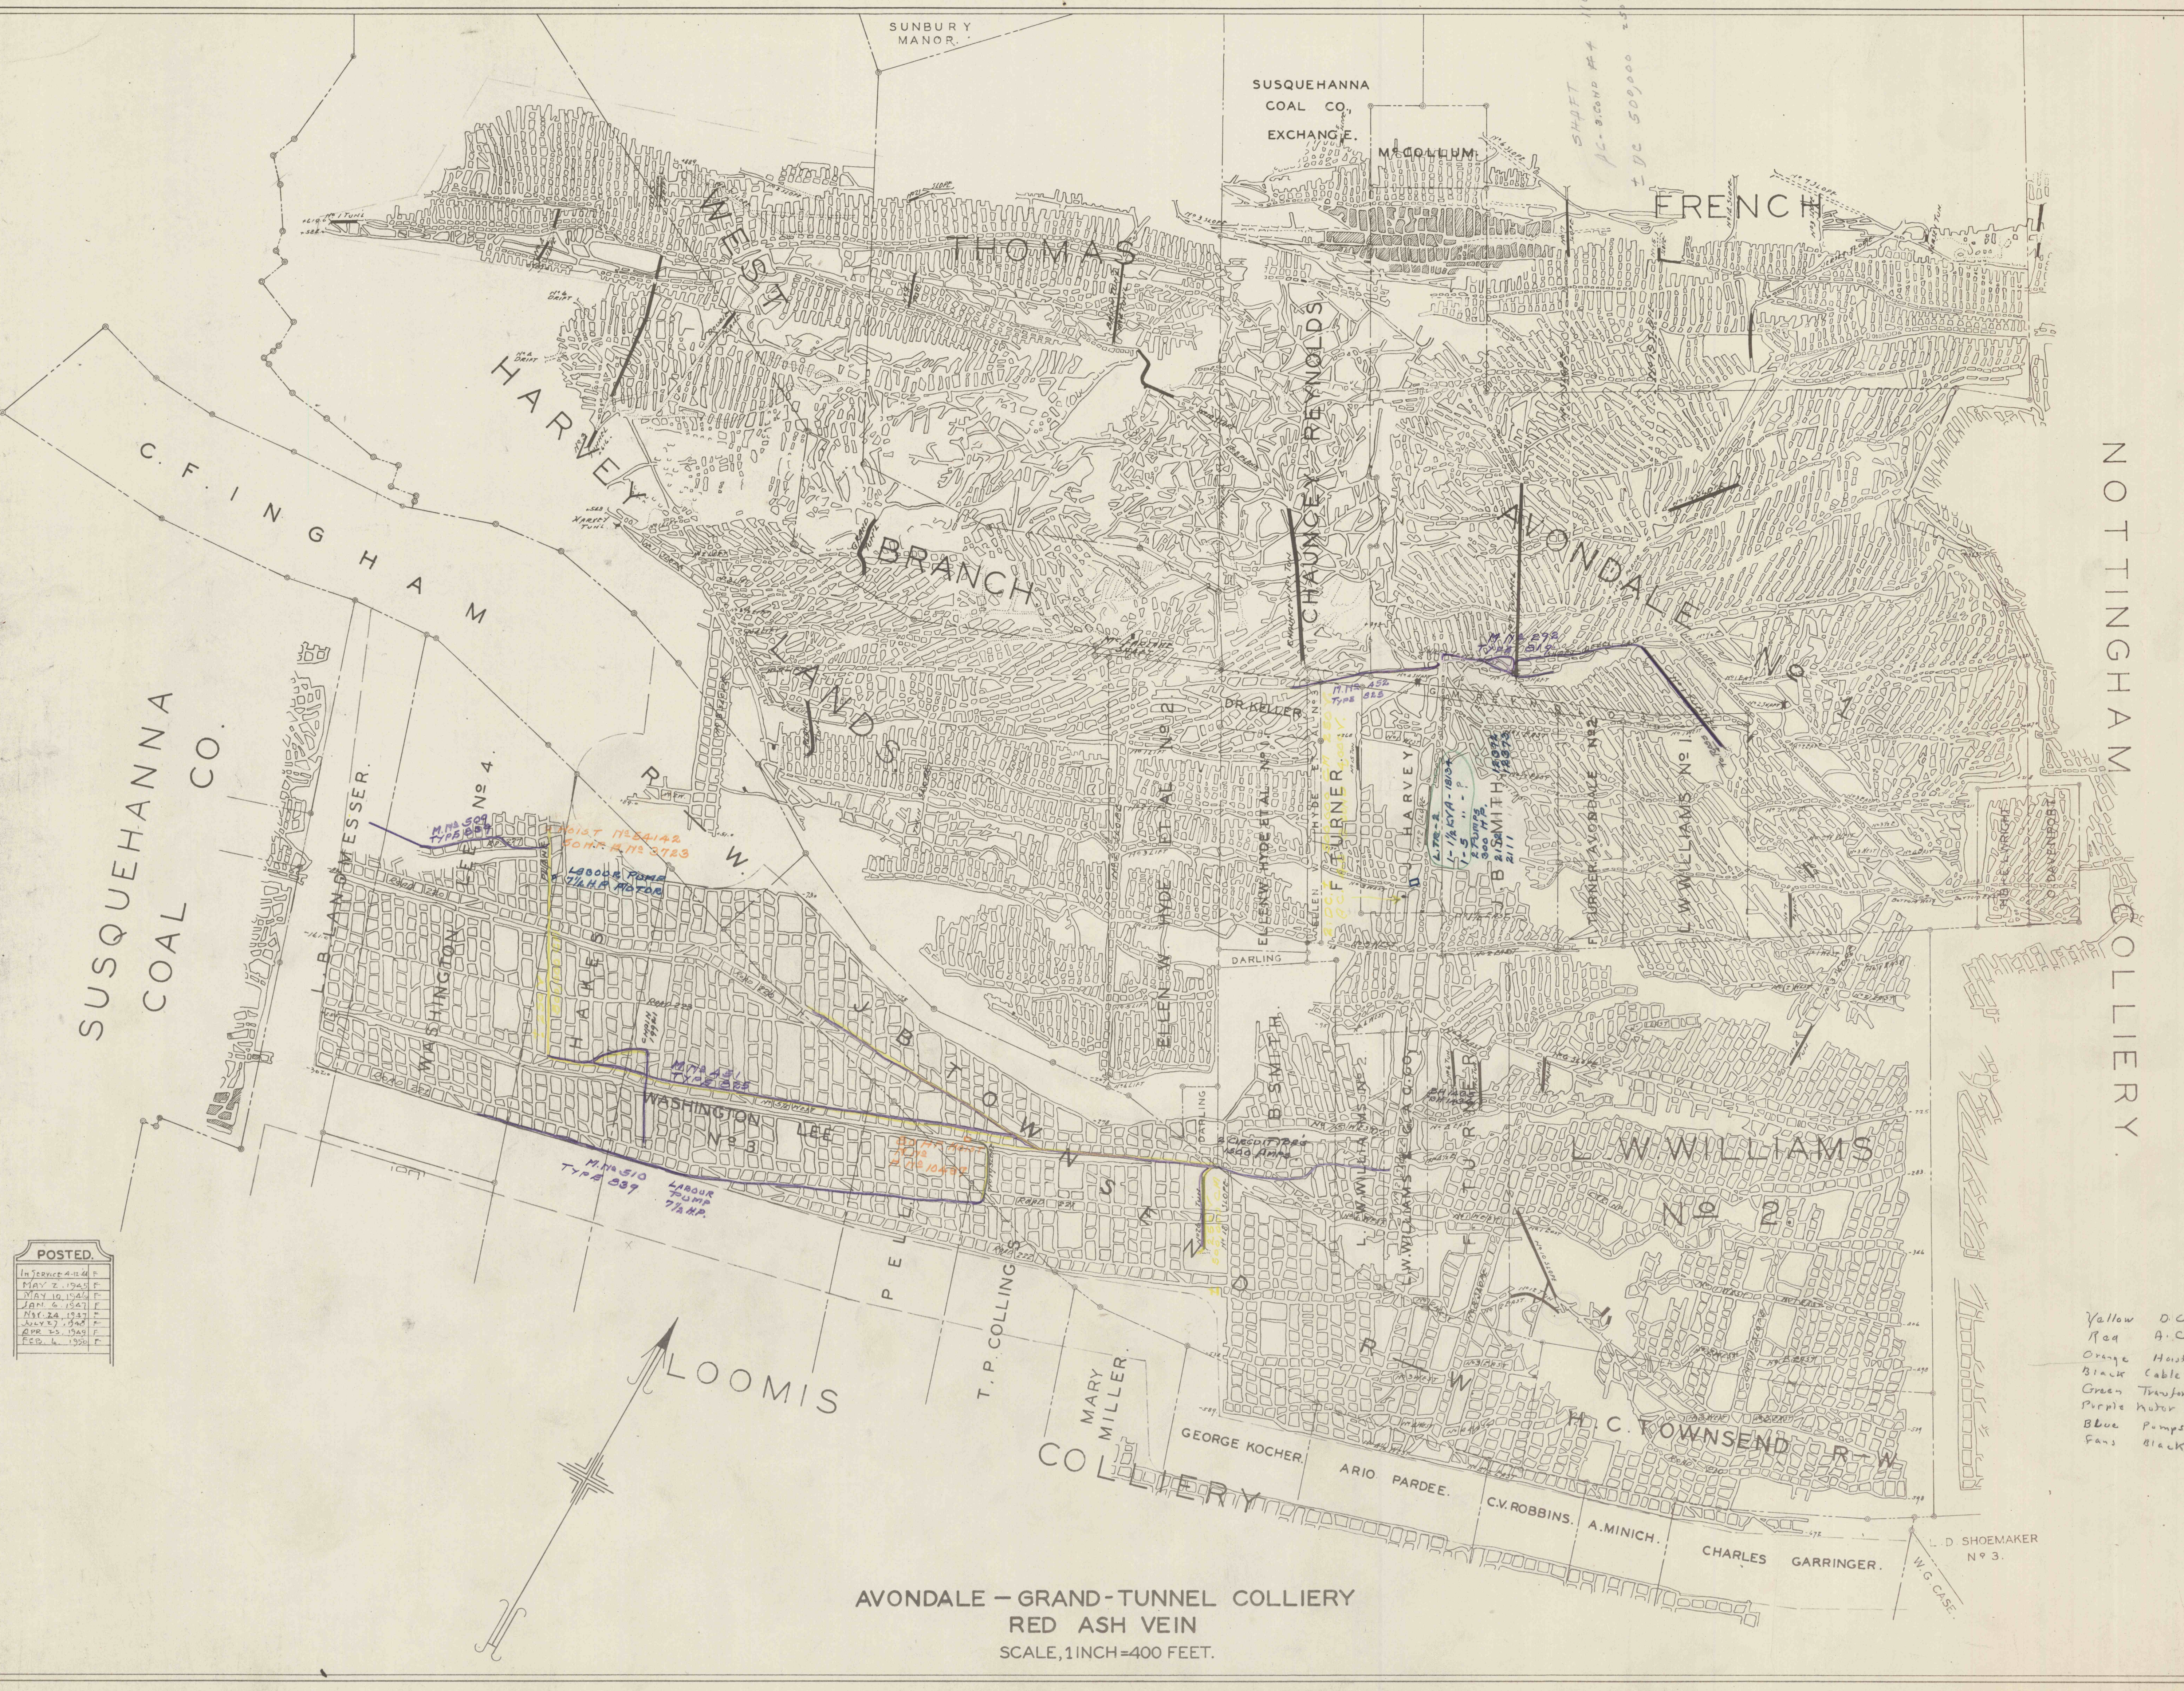

AVONDALE - GRAND-TUNNEL COLLIERY
RED ASH VEIN
SCALE, 1 INCH = 400 FEET.

- Yellow D.C.
- Red A.C.
- Orange Hoists
- Black Cable B.H.s
- Green Transformer
- Blue Pumps
- Black Fans