


13

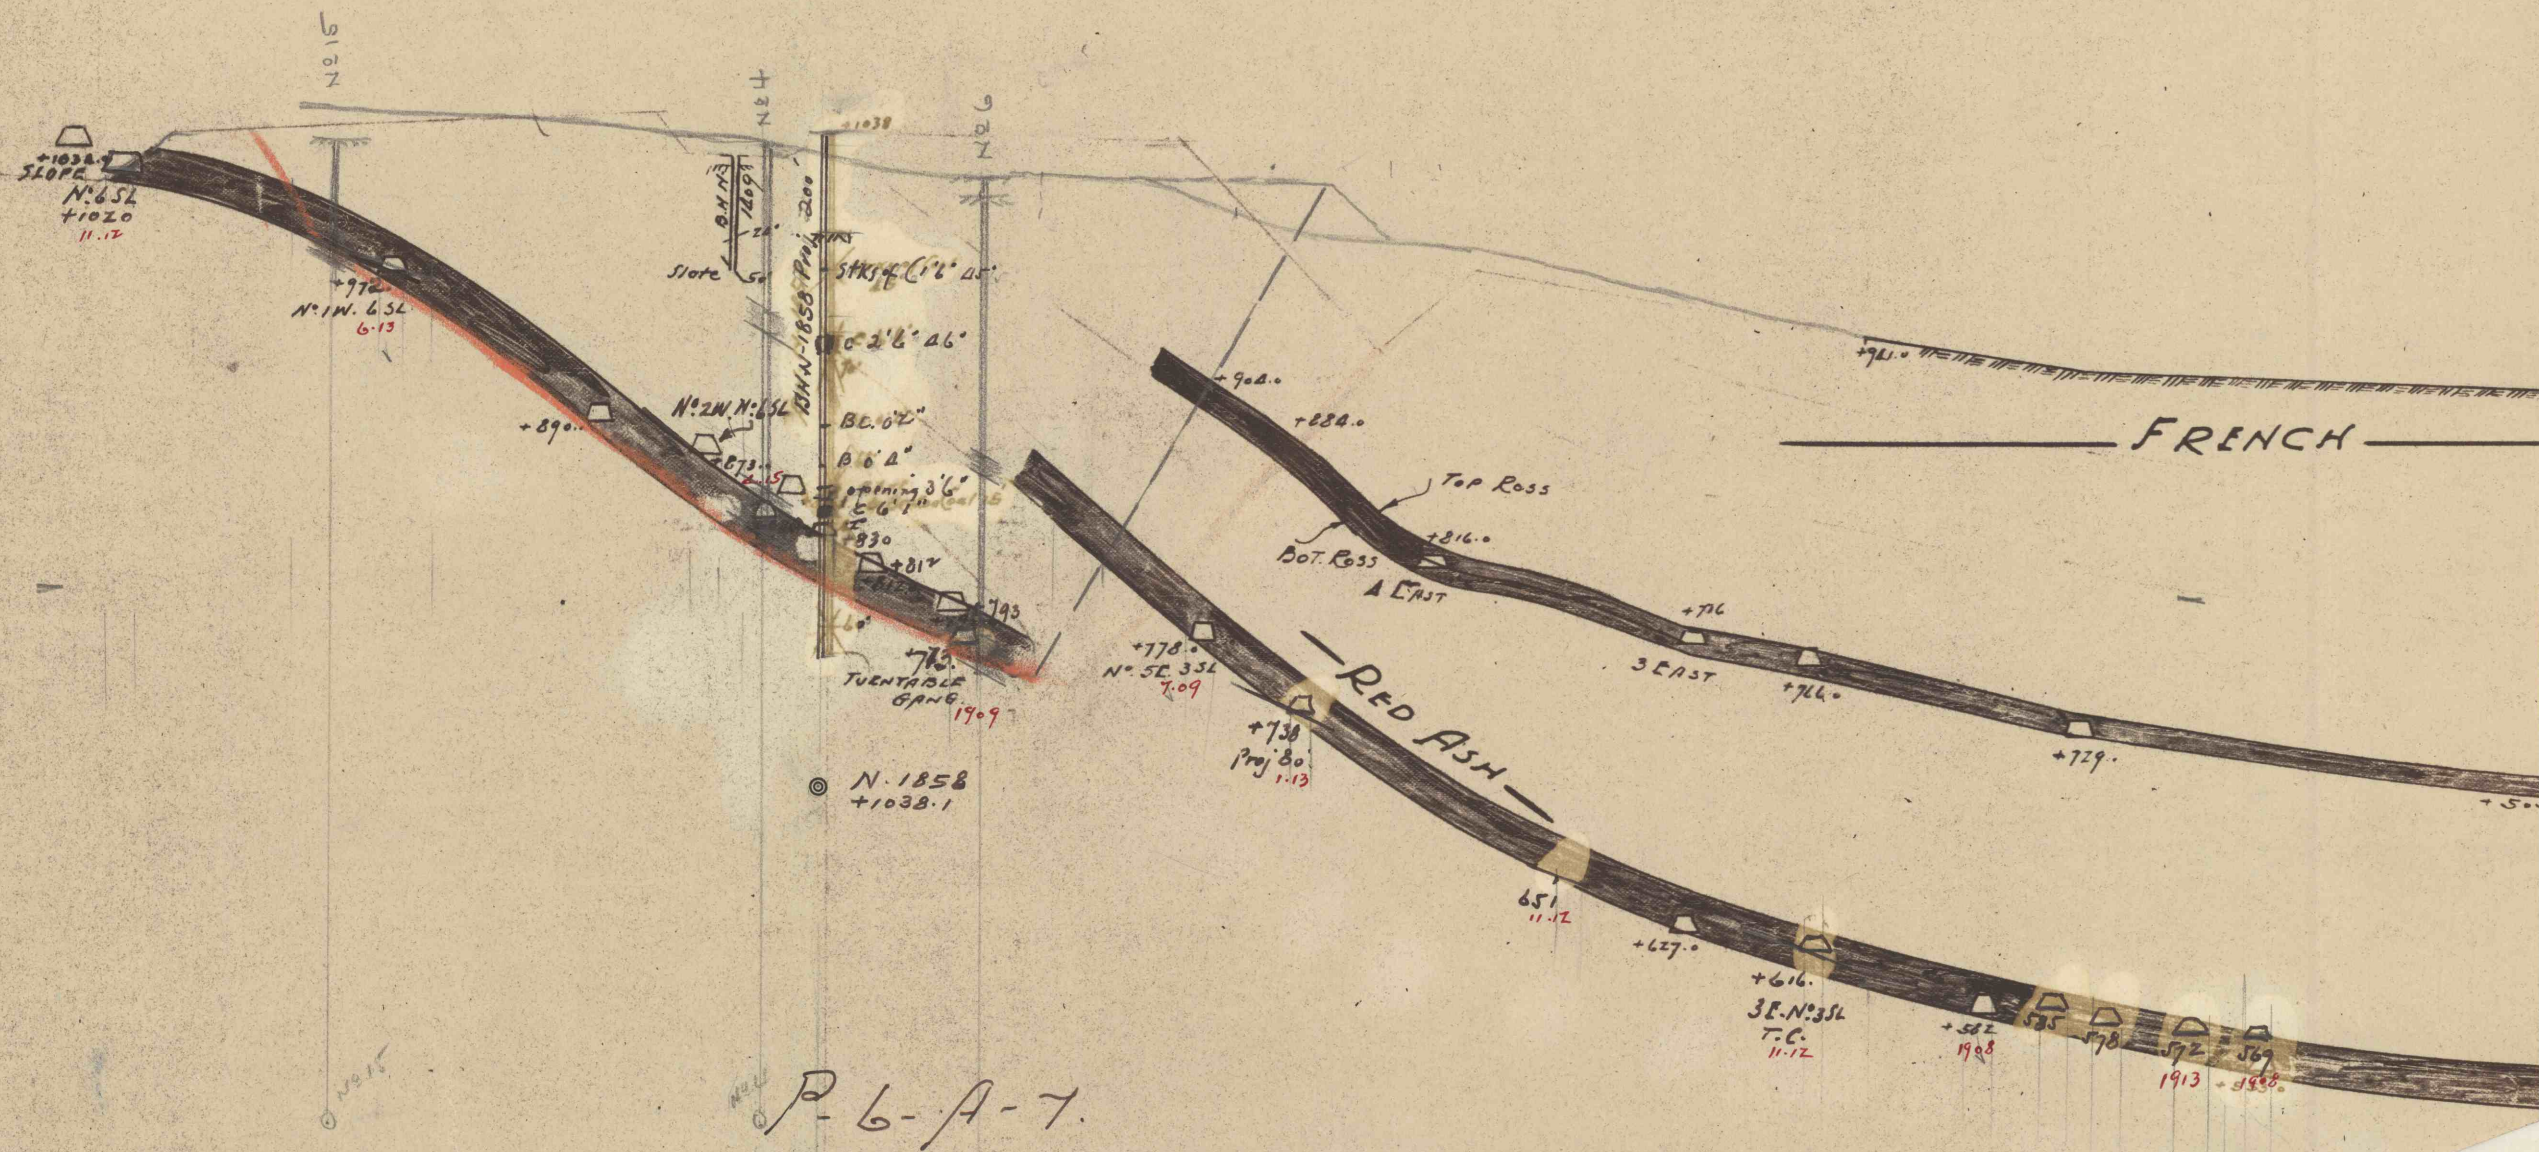

+500

P-6-A-7

20007