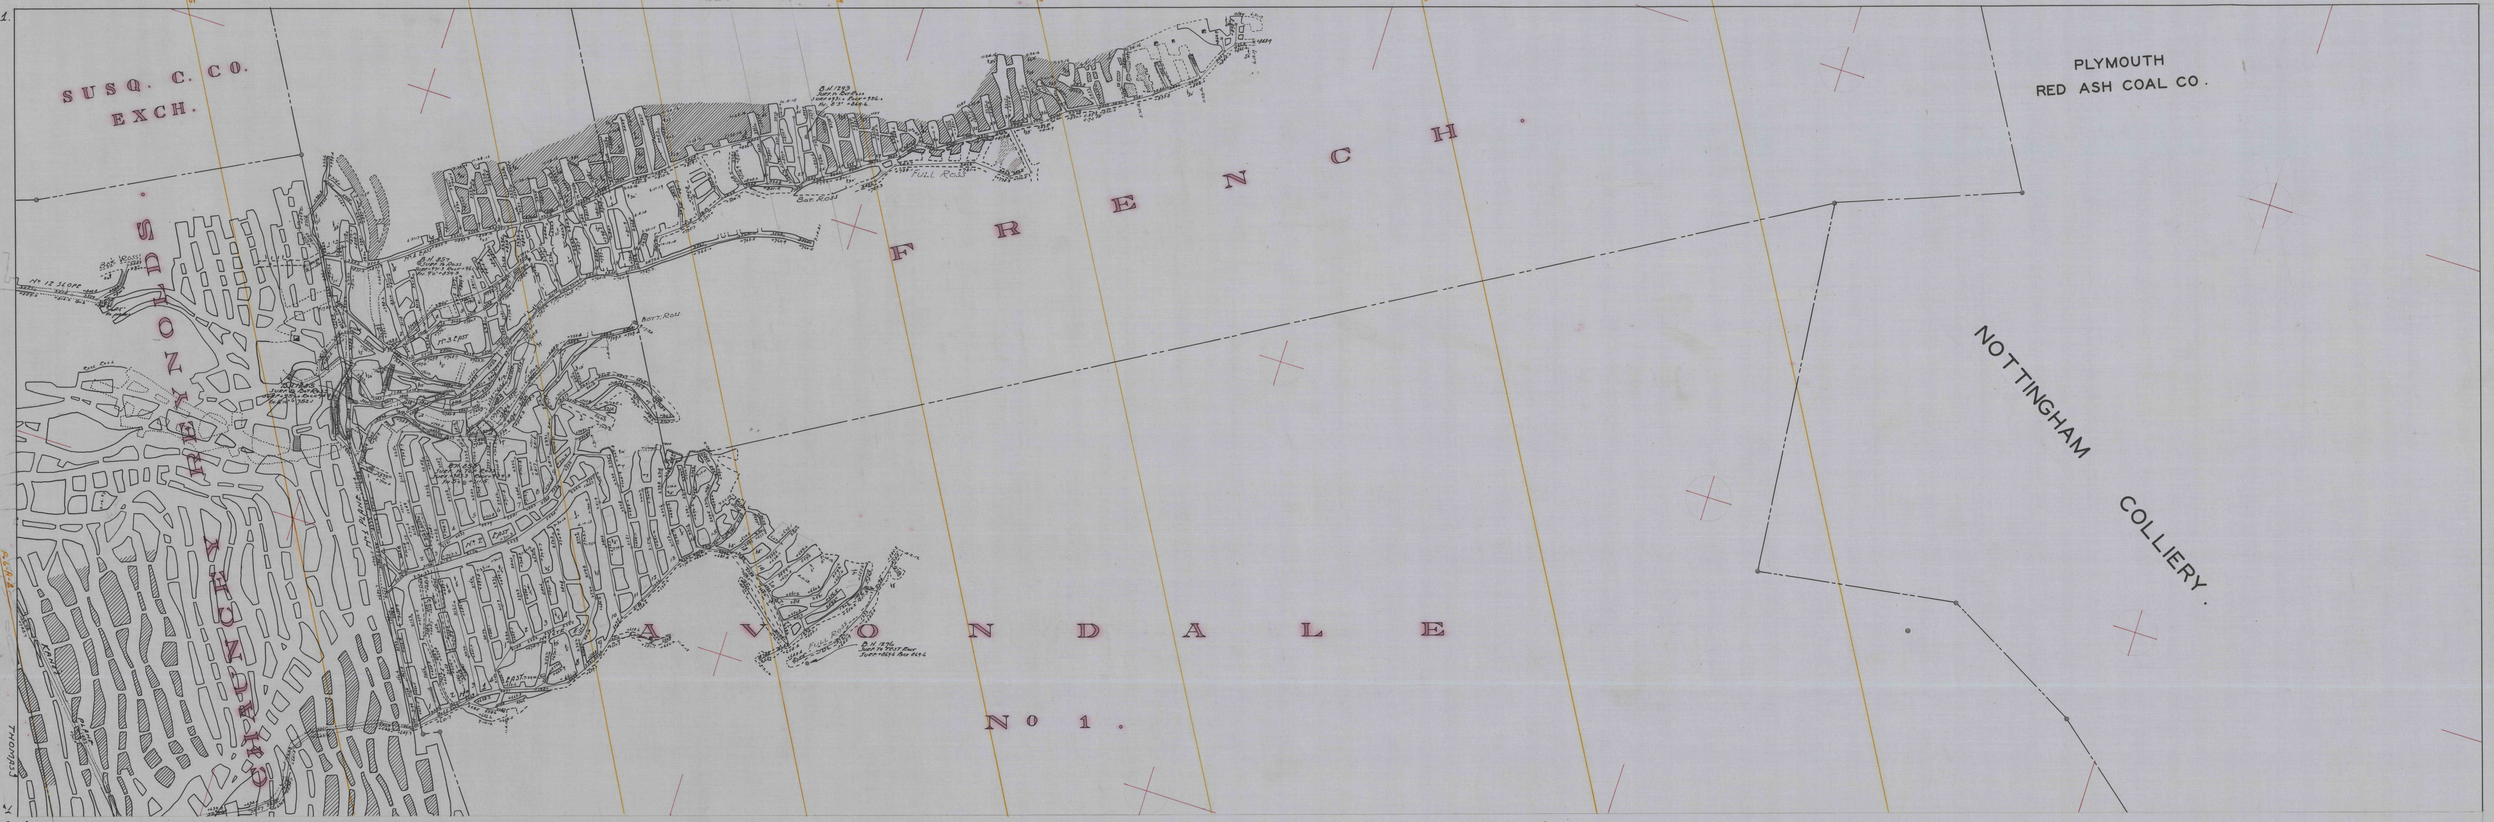
SUSQ. C. CO.
EXCH.
PLYMOUTH
RED ASH COAL CO.
NOTTINGHAM
COLLIERY.
F R E N C H
A V O N D A L E
No 1.
PLYMOUTH

TOP ROSS 2.