


P-6-A-4

P-6-A-5

P-6-A-6

P-6-A-7

P-6-A-8

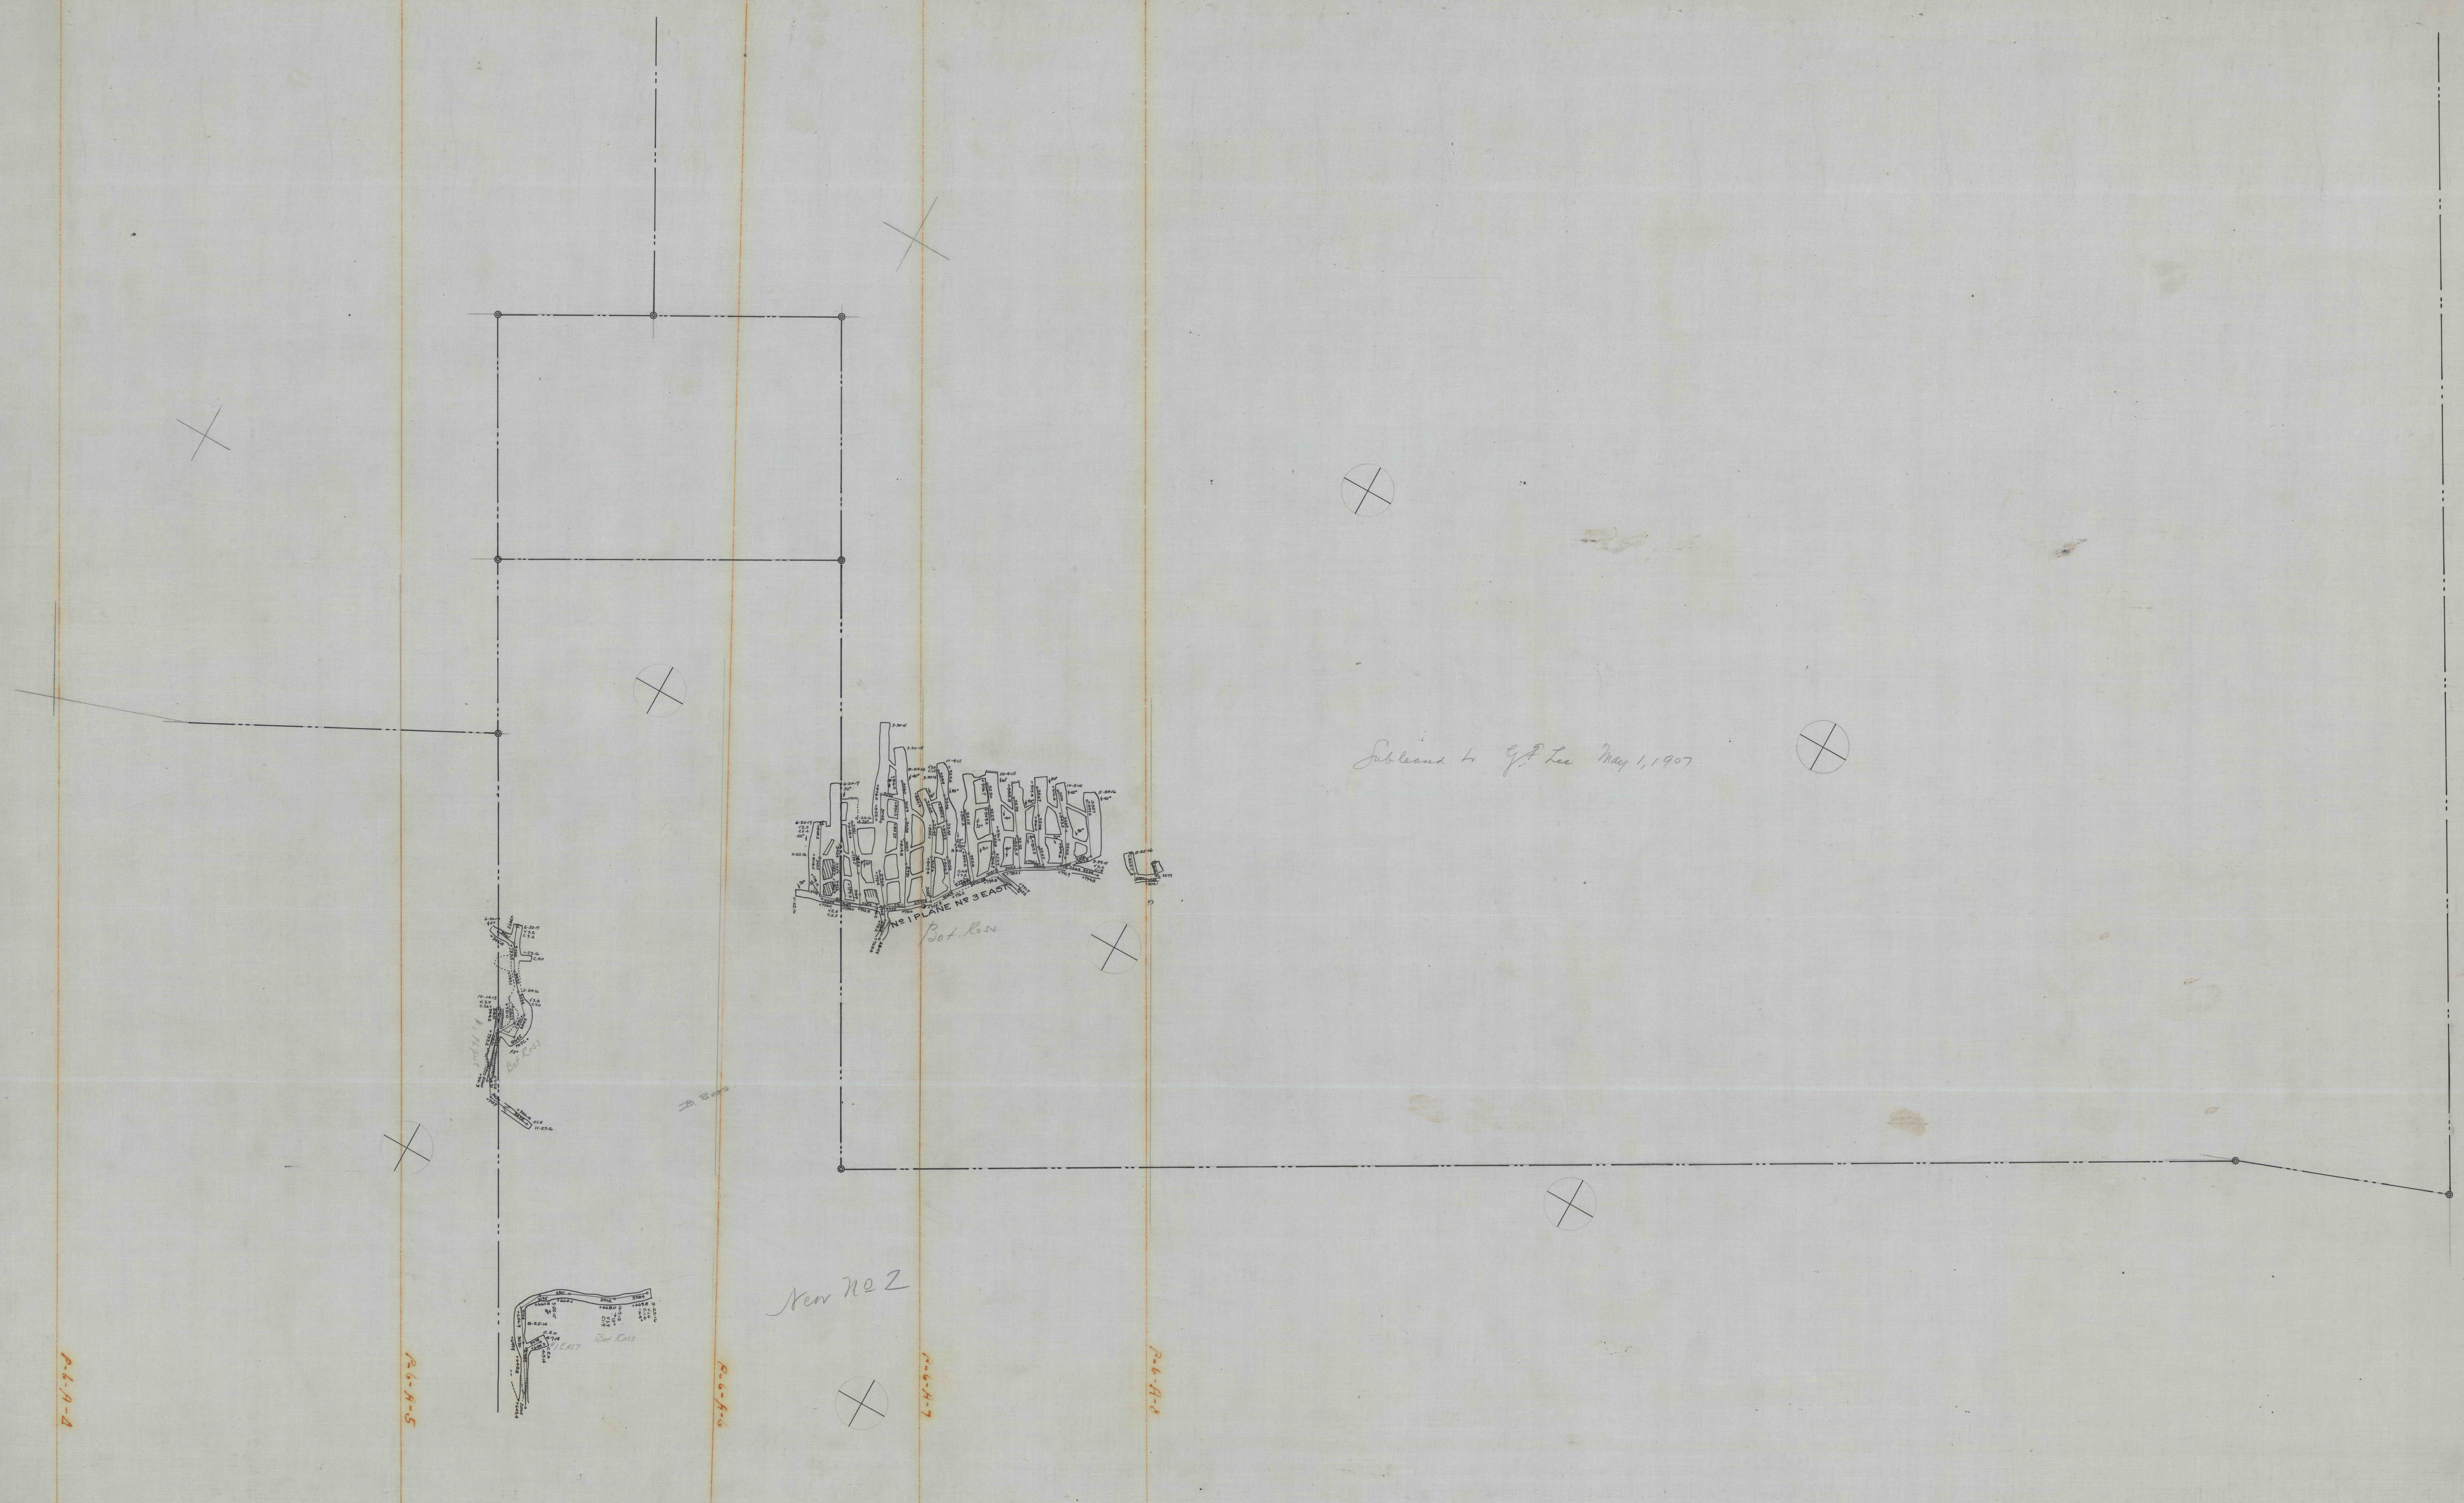

New No 2

Subland to G.A. Lee May 1, 1907

