


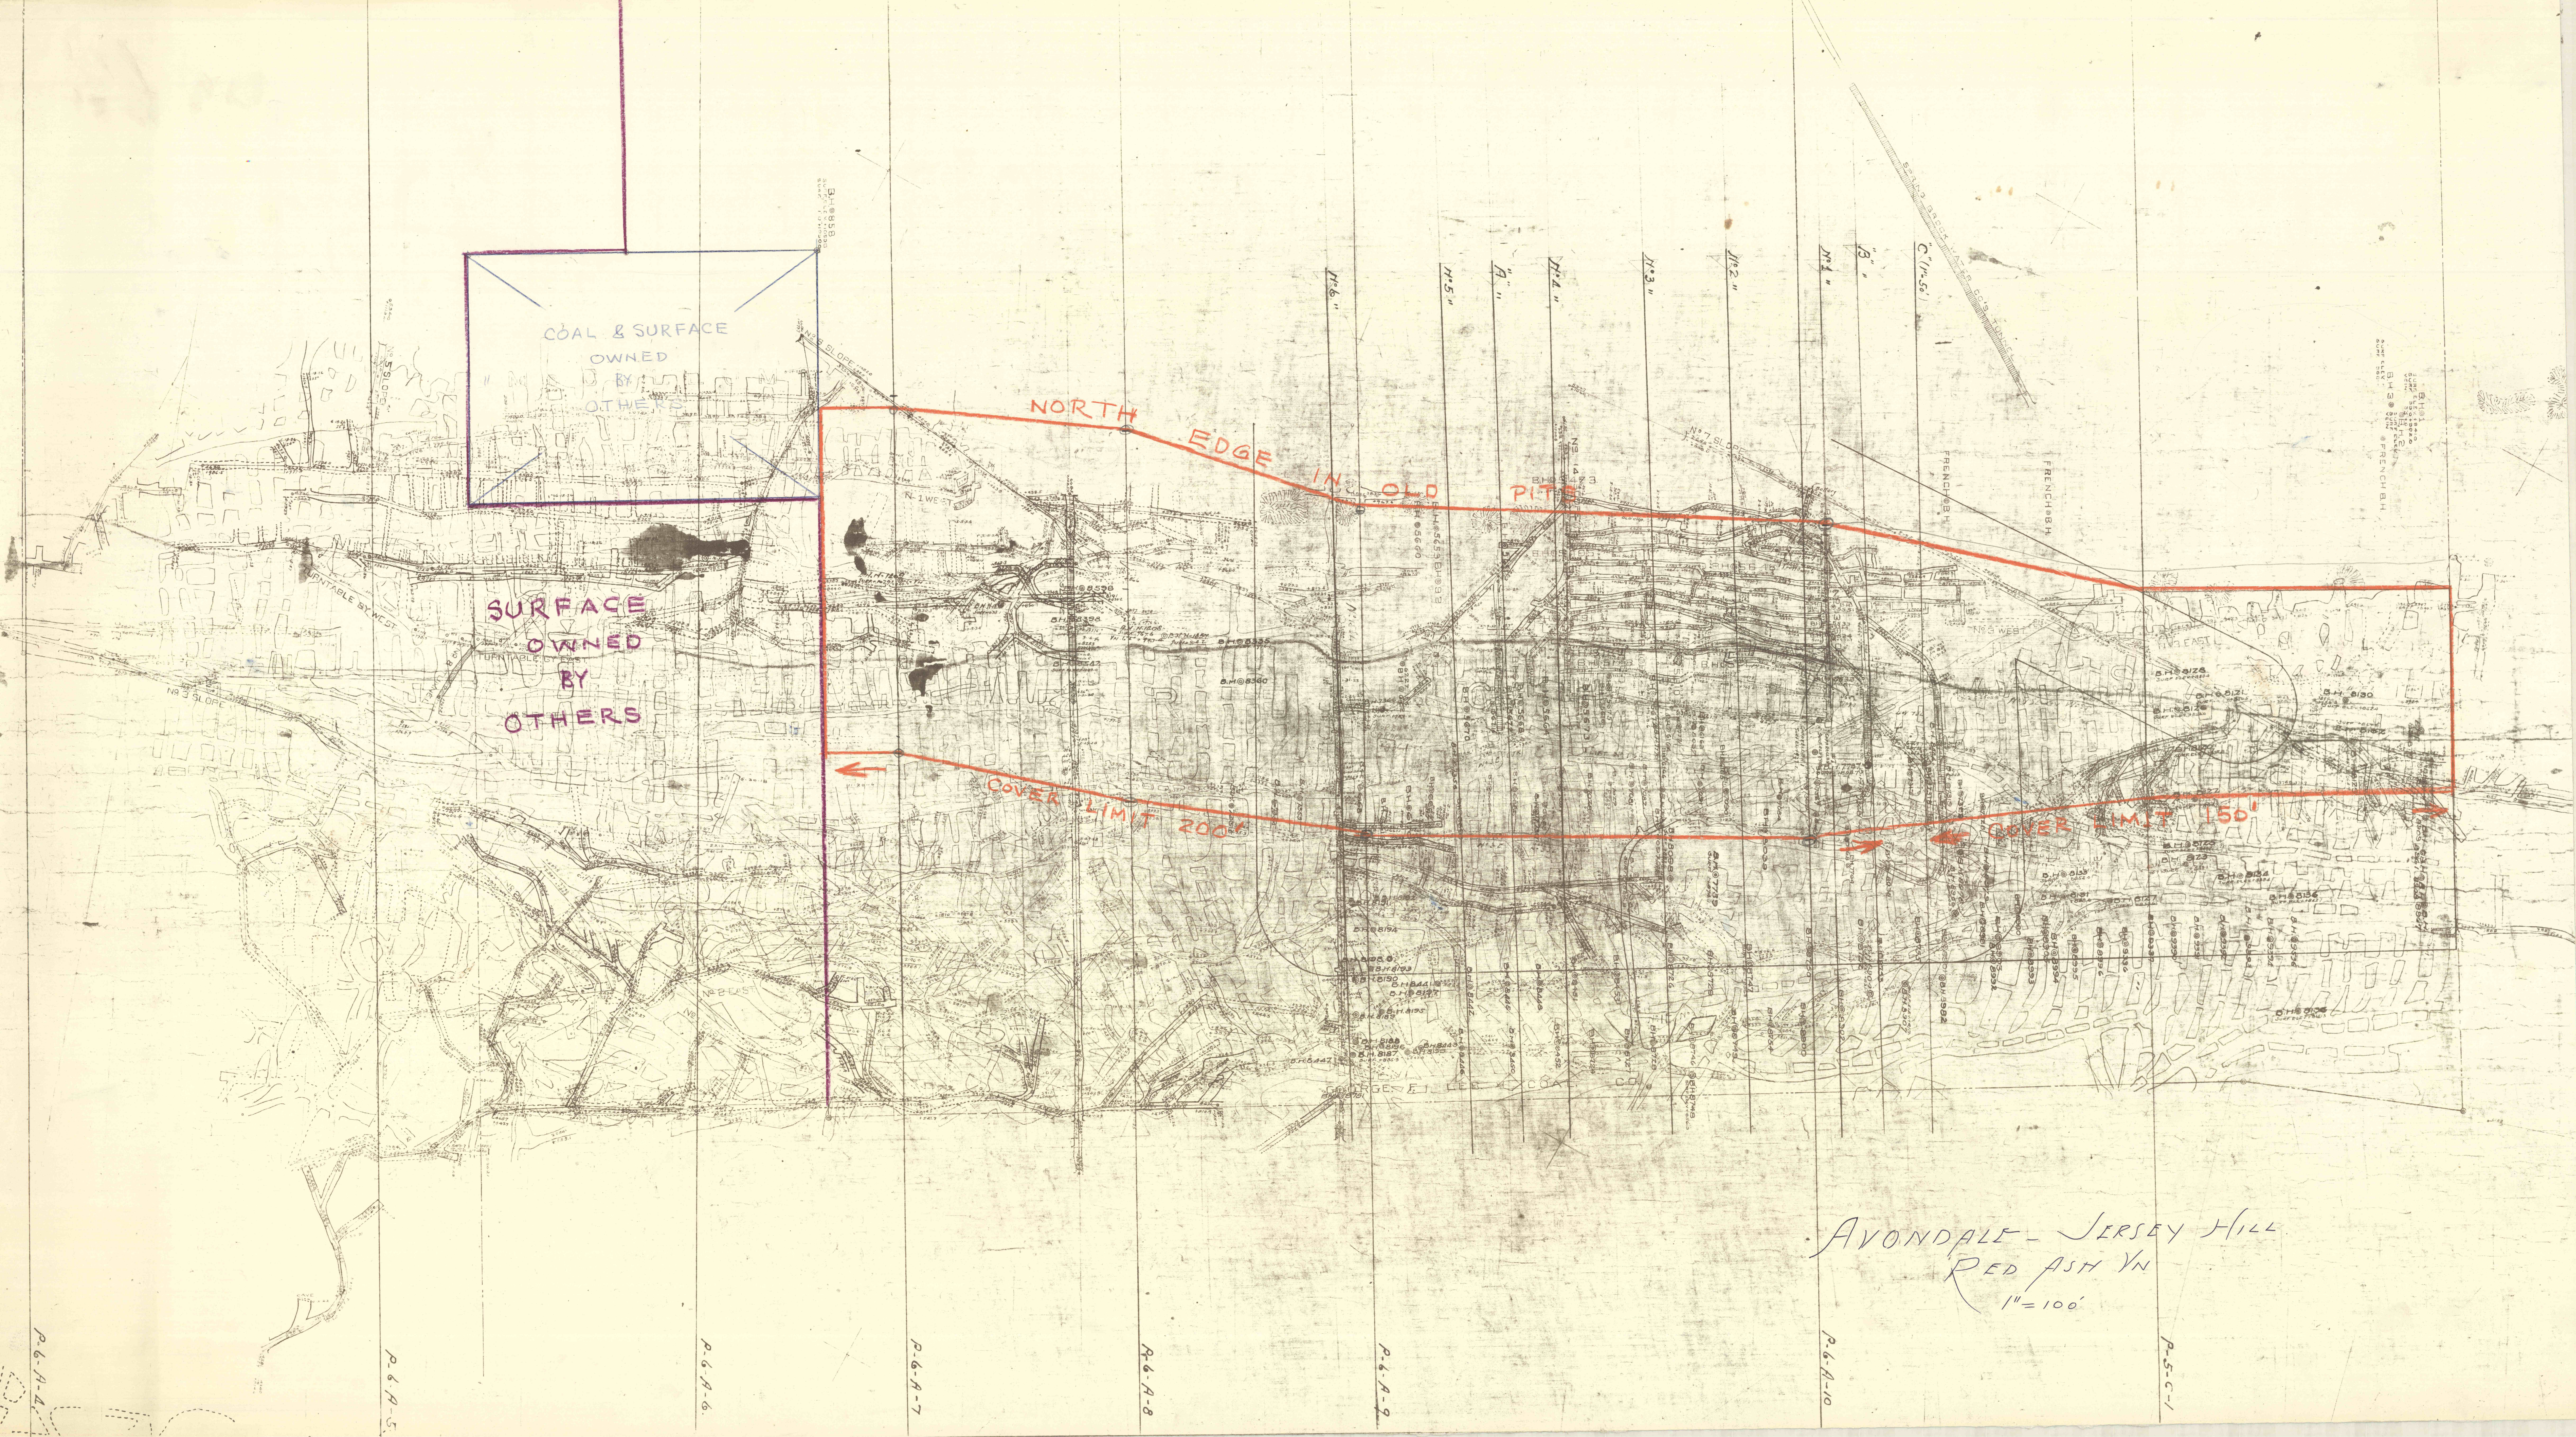

COAL & SURFACE
OWNED
BY
OTHERS

SURFACE
OWNED
BY
OTHERS

NORTH
EDGE IN OLD
PITS

COVER LIMIT 200'

COVER LIMIT 150'

AVONDALE - JERSEY HILL
RED ASH VN
1" = 100'

P-6-A-4

P-6-A-5

P-6-A-6

P-6-A-7

P-6-A-8

P-6-A-9

P-6-A-10

P-5-C-1