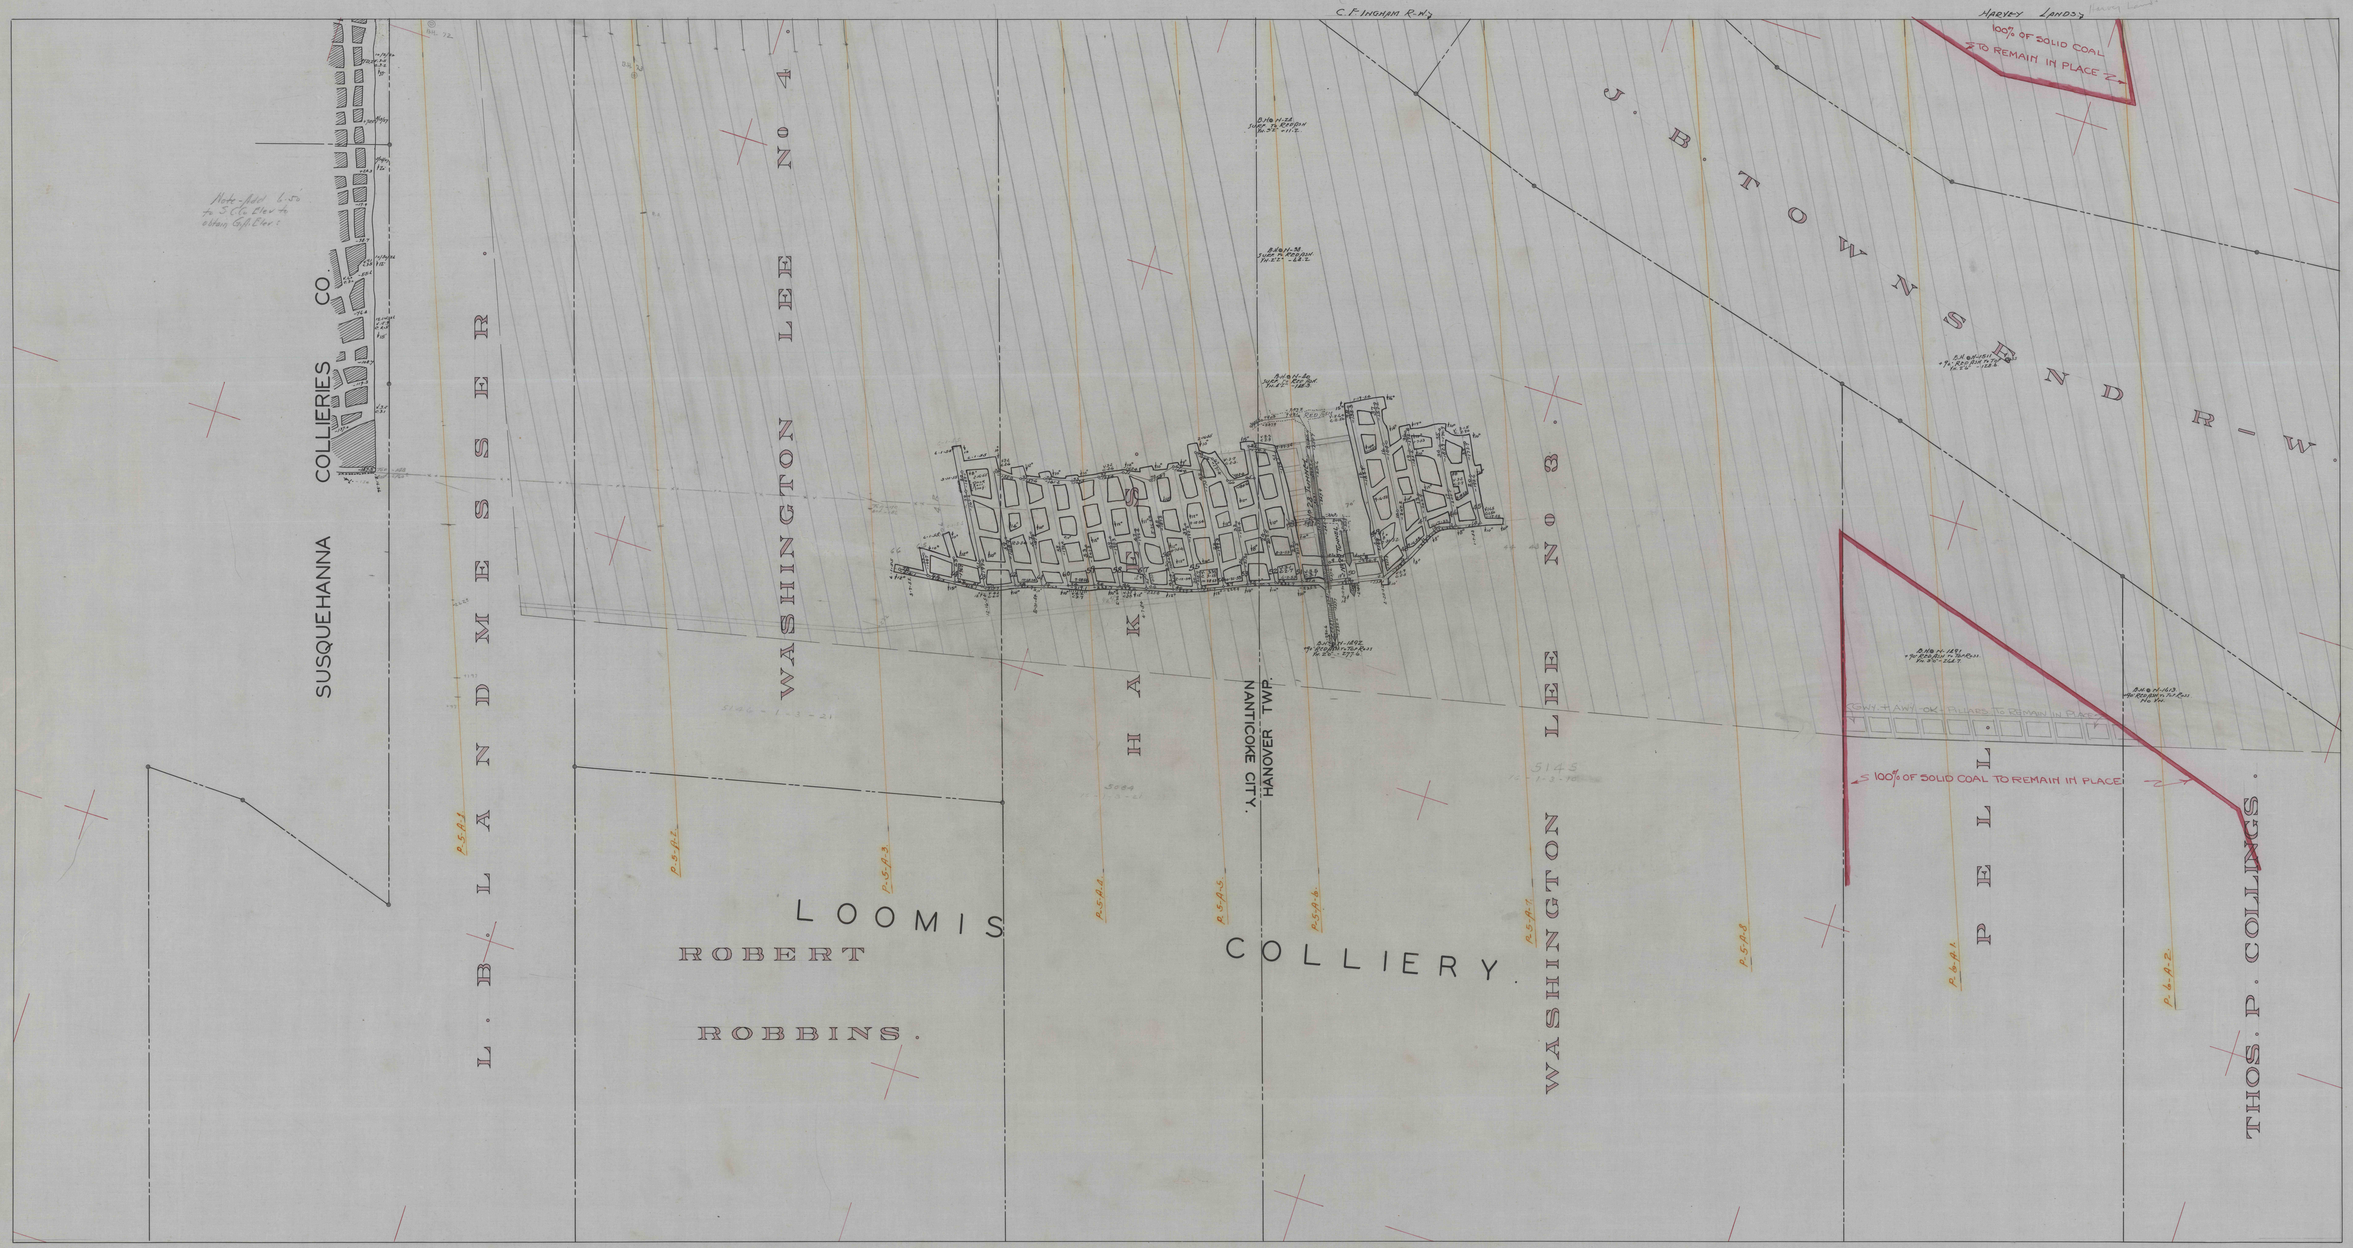

C. P. INGHAM R.W.
HARVEY LANDS
100% OF SOLID COAL TO REMAIN IN PLACE
J. B. TOWNSEND R-W.
SUSQUEHANNA COLLIERIES CO.
L. B. LANDMESSER.
WASHINGTON LEE No 4.
HAKES
NANTICOKE CITY.
HANOVER TWP.
WASHINGTON LEE No 3.
PELL.
THOS. P. COLLINGS.
LOOMIS COLLIERY.
ROBERT ROBBINS.
100% OF SOLID COAL TO REMAIN IN PLACE

CHAUNCEY 5.