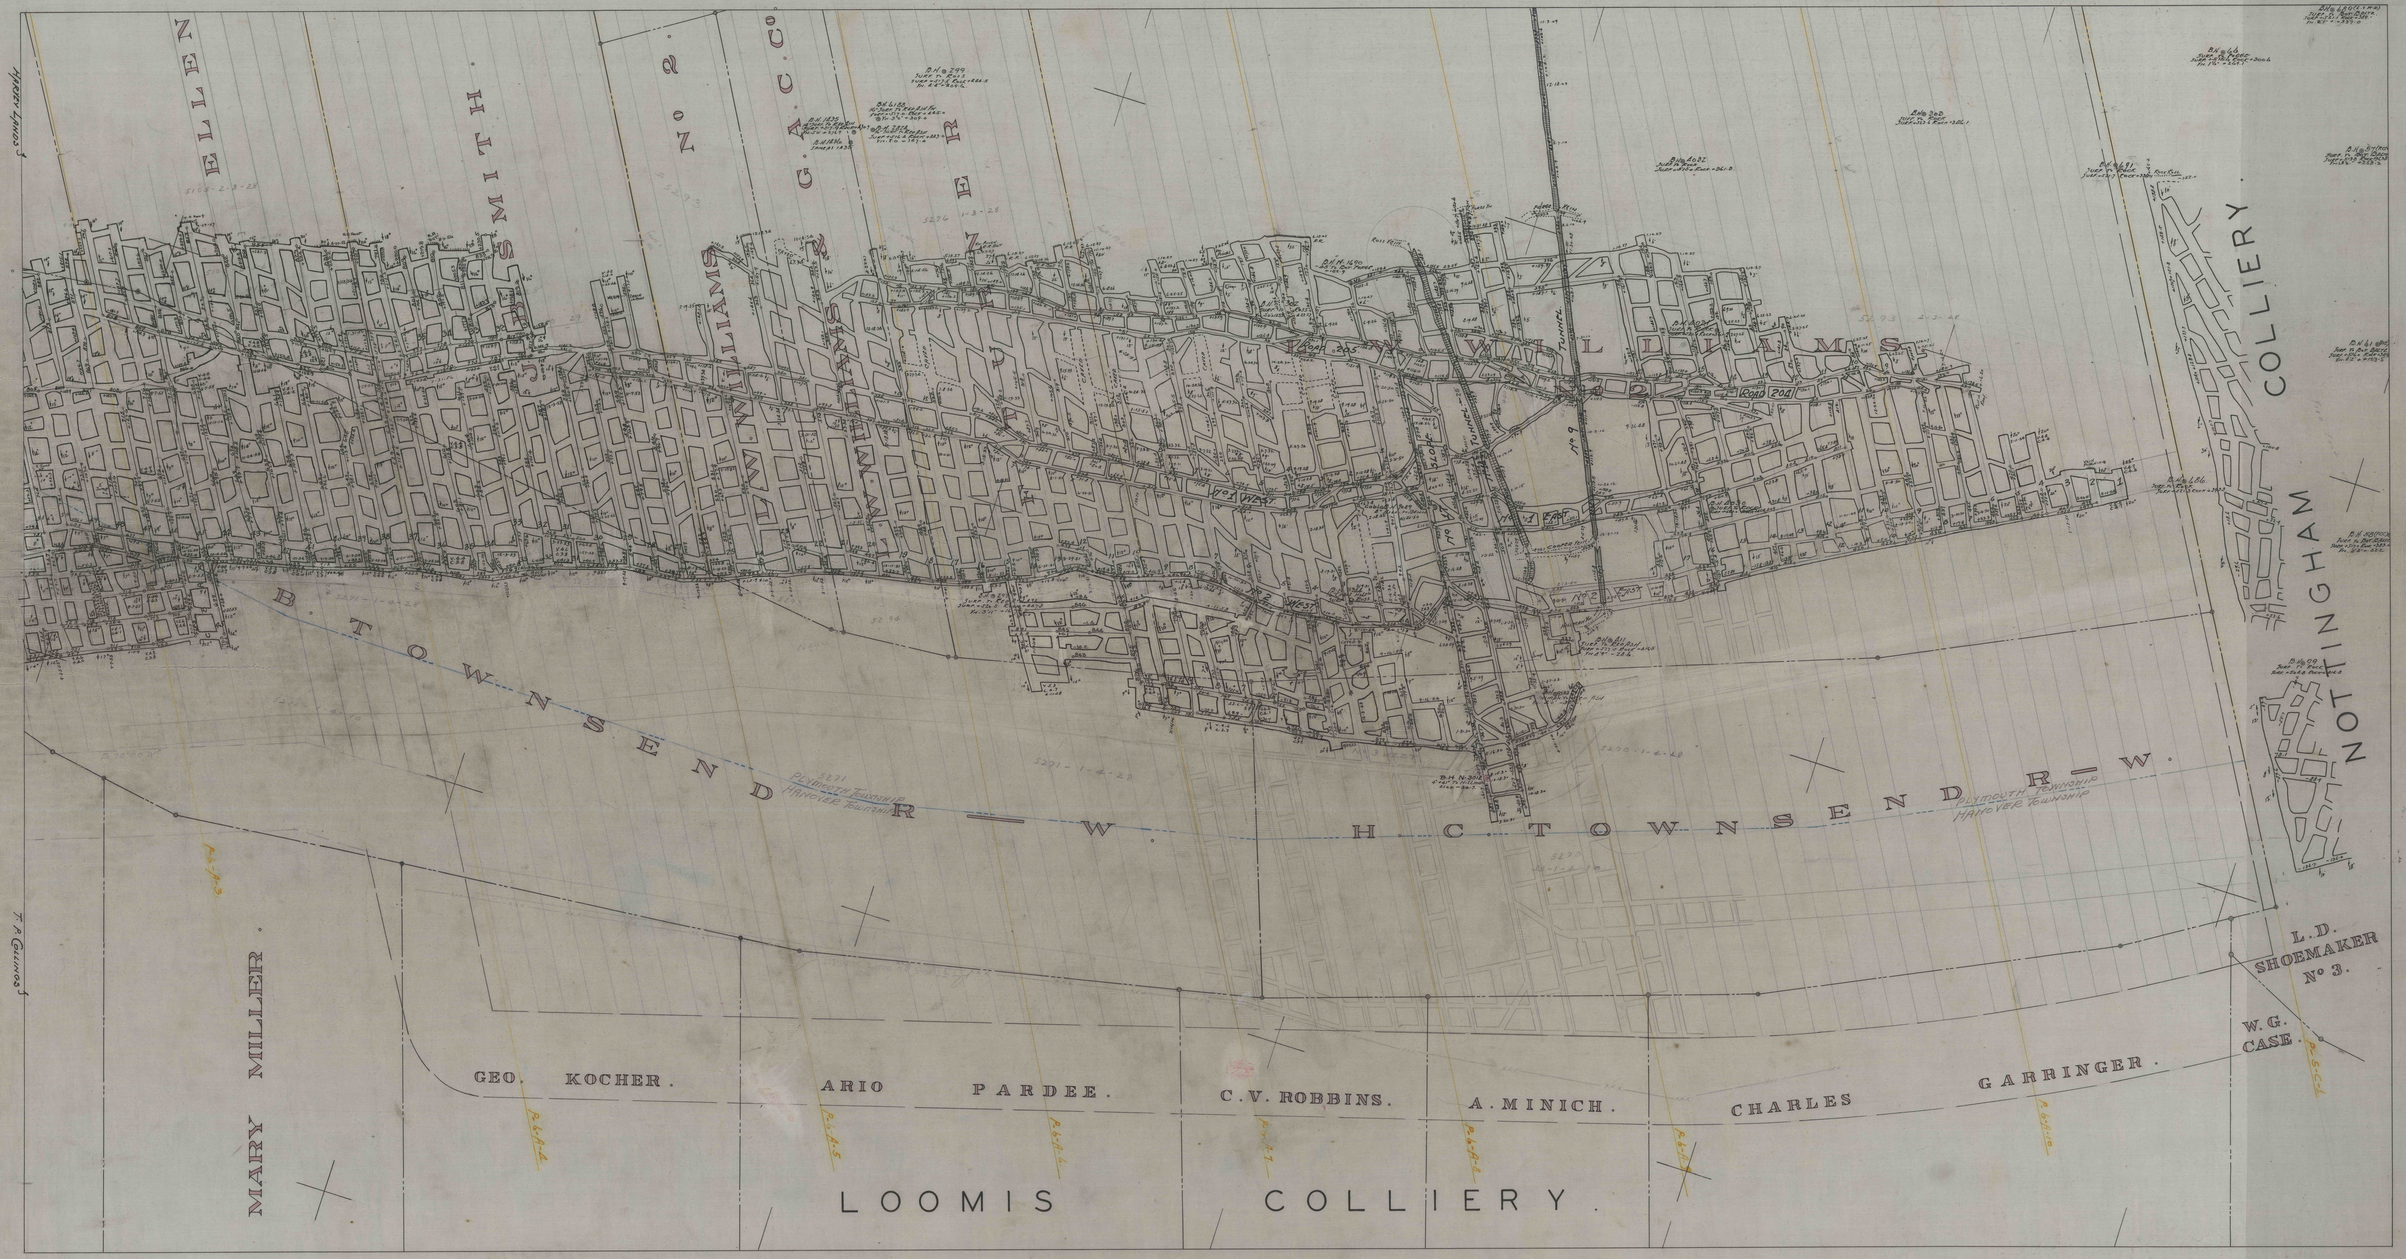

HARVEY LANDS
ELLEN
SMITH
No 2
G. A. C. Co
L. W. WILLIAMS
W. W. WILLIAMS
J. W. WILLIAMS
No 2
B. H. @ 299 SURF. TO ROSS SURF + 517.5 ROCK + 222.5 VN. 2'6" + 209.6
5105-2-3-28
5276 1-3-28
5293 2-3-28
ROAD 205
ROAD 204
No 1 WEST
No 2 WEST
No 1 EAST
No 2 EAST
SLOPE
TUNNEL
No 9
FORGE VEIN
ROSS VEIN
COOPER VEIN
HILLMAN VN.
CAVED
B.H. @ 303 SURF. TO ROCK SURF + 523.6 ROCK + 326.1
B.H. @ 2032 SURF TO ROCK SURF + 515.0 ROCK + 361.3
B.H. @ 691 SURF. TO ROCK SURF + 521.7 ROCK + 338.4
B.H. @ 686 SURF. TO ROCK SURF + 521.3 ROCK + 393.3
B.H. @ 66 SURF. TO FORGE SURF + 515.0 ROCK + 300.6 VN. 1'6" + 269.1
B.H. @ 689 (L.C.W.D) SURF. TO BOT. BALTI. SURF + 521.1 ROCK + 329.1 VN. 2'1" + 337.0
B.H. @ 99 SURF. TO ROCK SURF + 504.8 ROCK + 212.8
B.H. @ 211 SURF. TO RED ASH. SURF + 527.5 ROCK + 216.5 VN 2'9" - 28.6
B.H. N-3012
NOTTINGHAM COLLIERY
B. TOWNSEND R-W. H. C. TOWNSEND R-W.
PLYMOUTH TOWNSHIP
HANOVER TOWNSHIP
5271 1-4-28
5270 1-4-28
MARY MILLER.
GEO. KOCHER.
ARIO PARDEE.
C. V. ROBBINS.
A. MINICH.
CHARLES GARRINGER.
W. G. CASE.
L. D. SHOEMAKER No 3.
LOOMIS COLLIERY.
P-6-A-3
P-6-A-4
P-6-A-5
P-6-A-6
P-6-A-7
P-6-A-8
P-6-A-9
P-6-A-10
P-5-C-1
T. P. COLLINGS

BENNETT 6.