


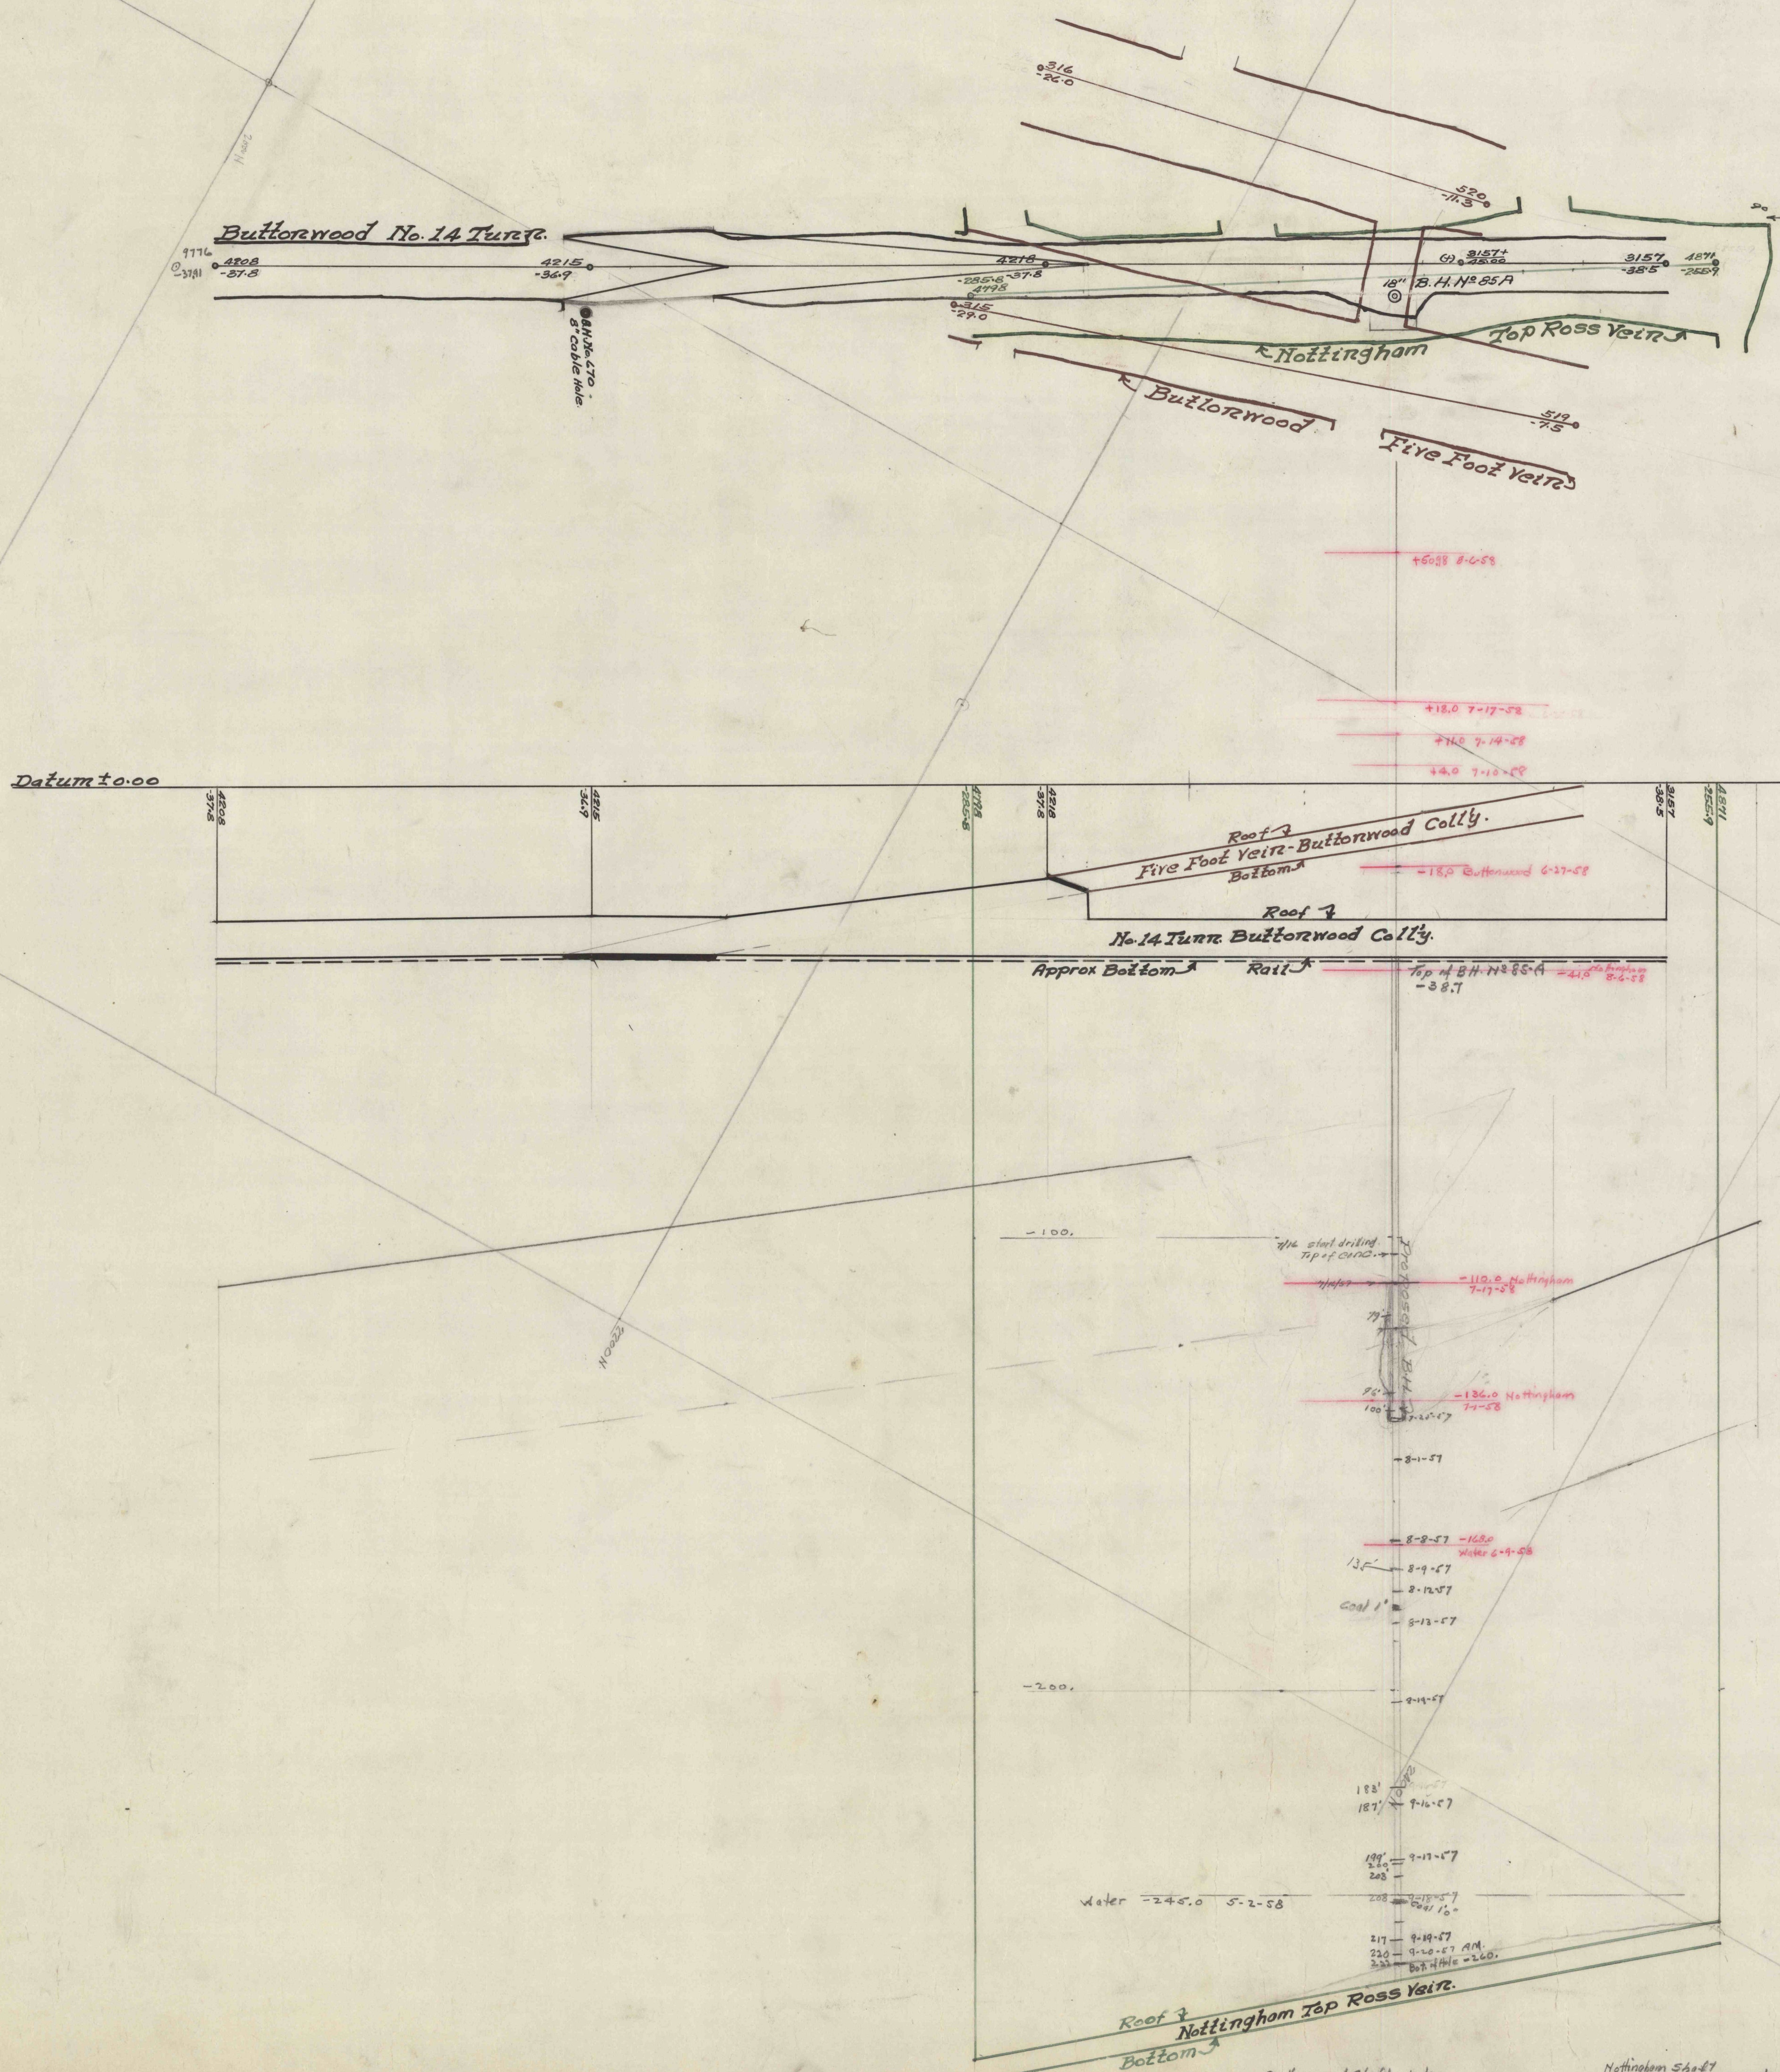

Plan & Profile
Proposed 18" Water Hole No. 85-A
From No. 14 Turn, Butterwood Colly. To Top Ross Vein, Nottingham Colly.
Feb. 1957. Scale: 1"=20'
 2 pumps out at Butterwood Foot 4-23-58
 All pumps out at De Henwood foot 5-22-58
 Stopped pumping at Nottingham 4-23-58