


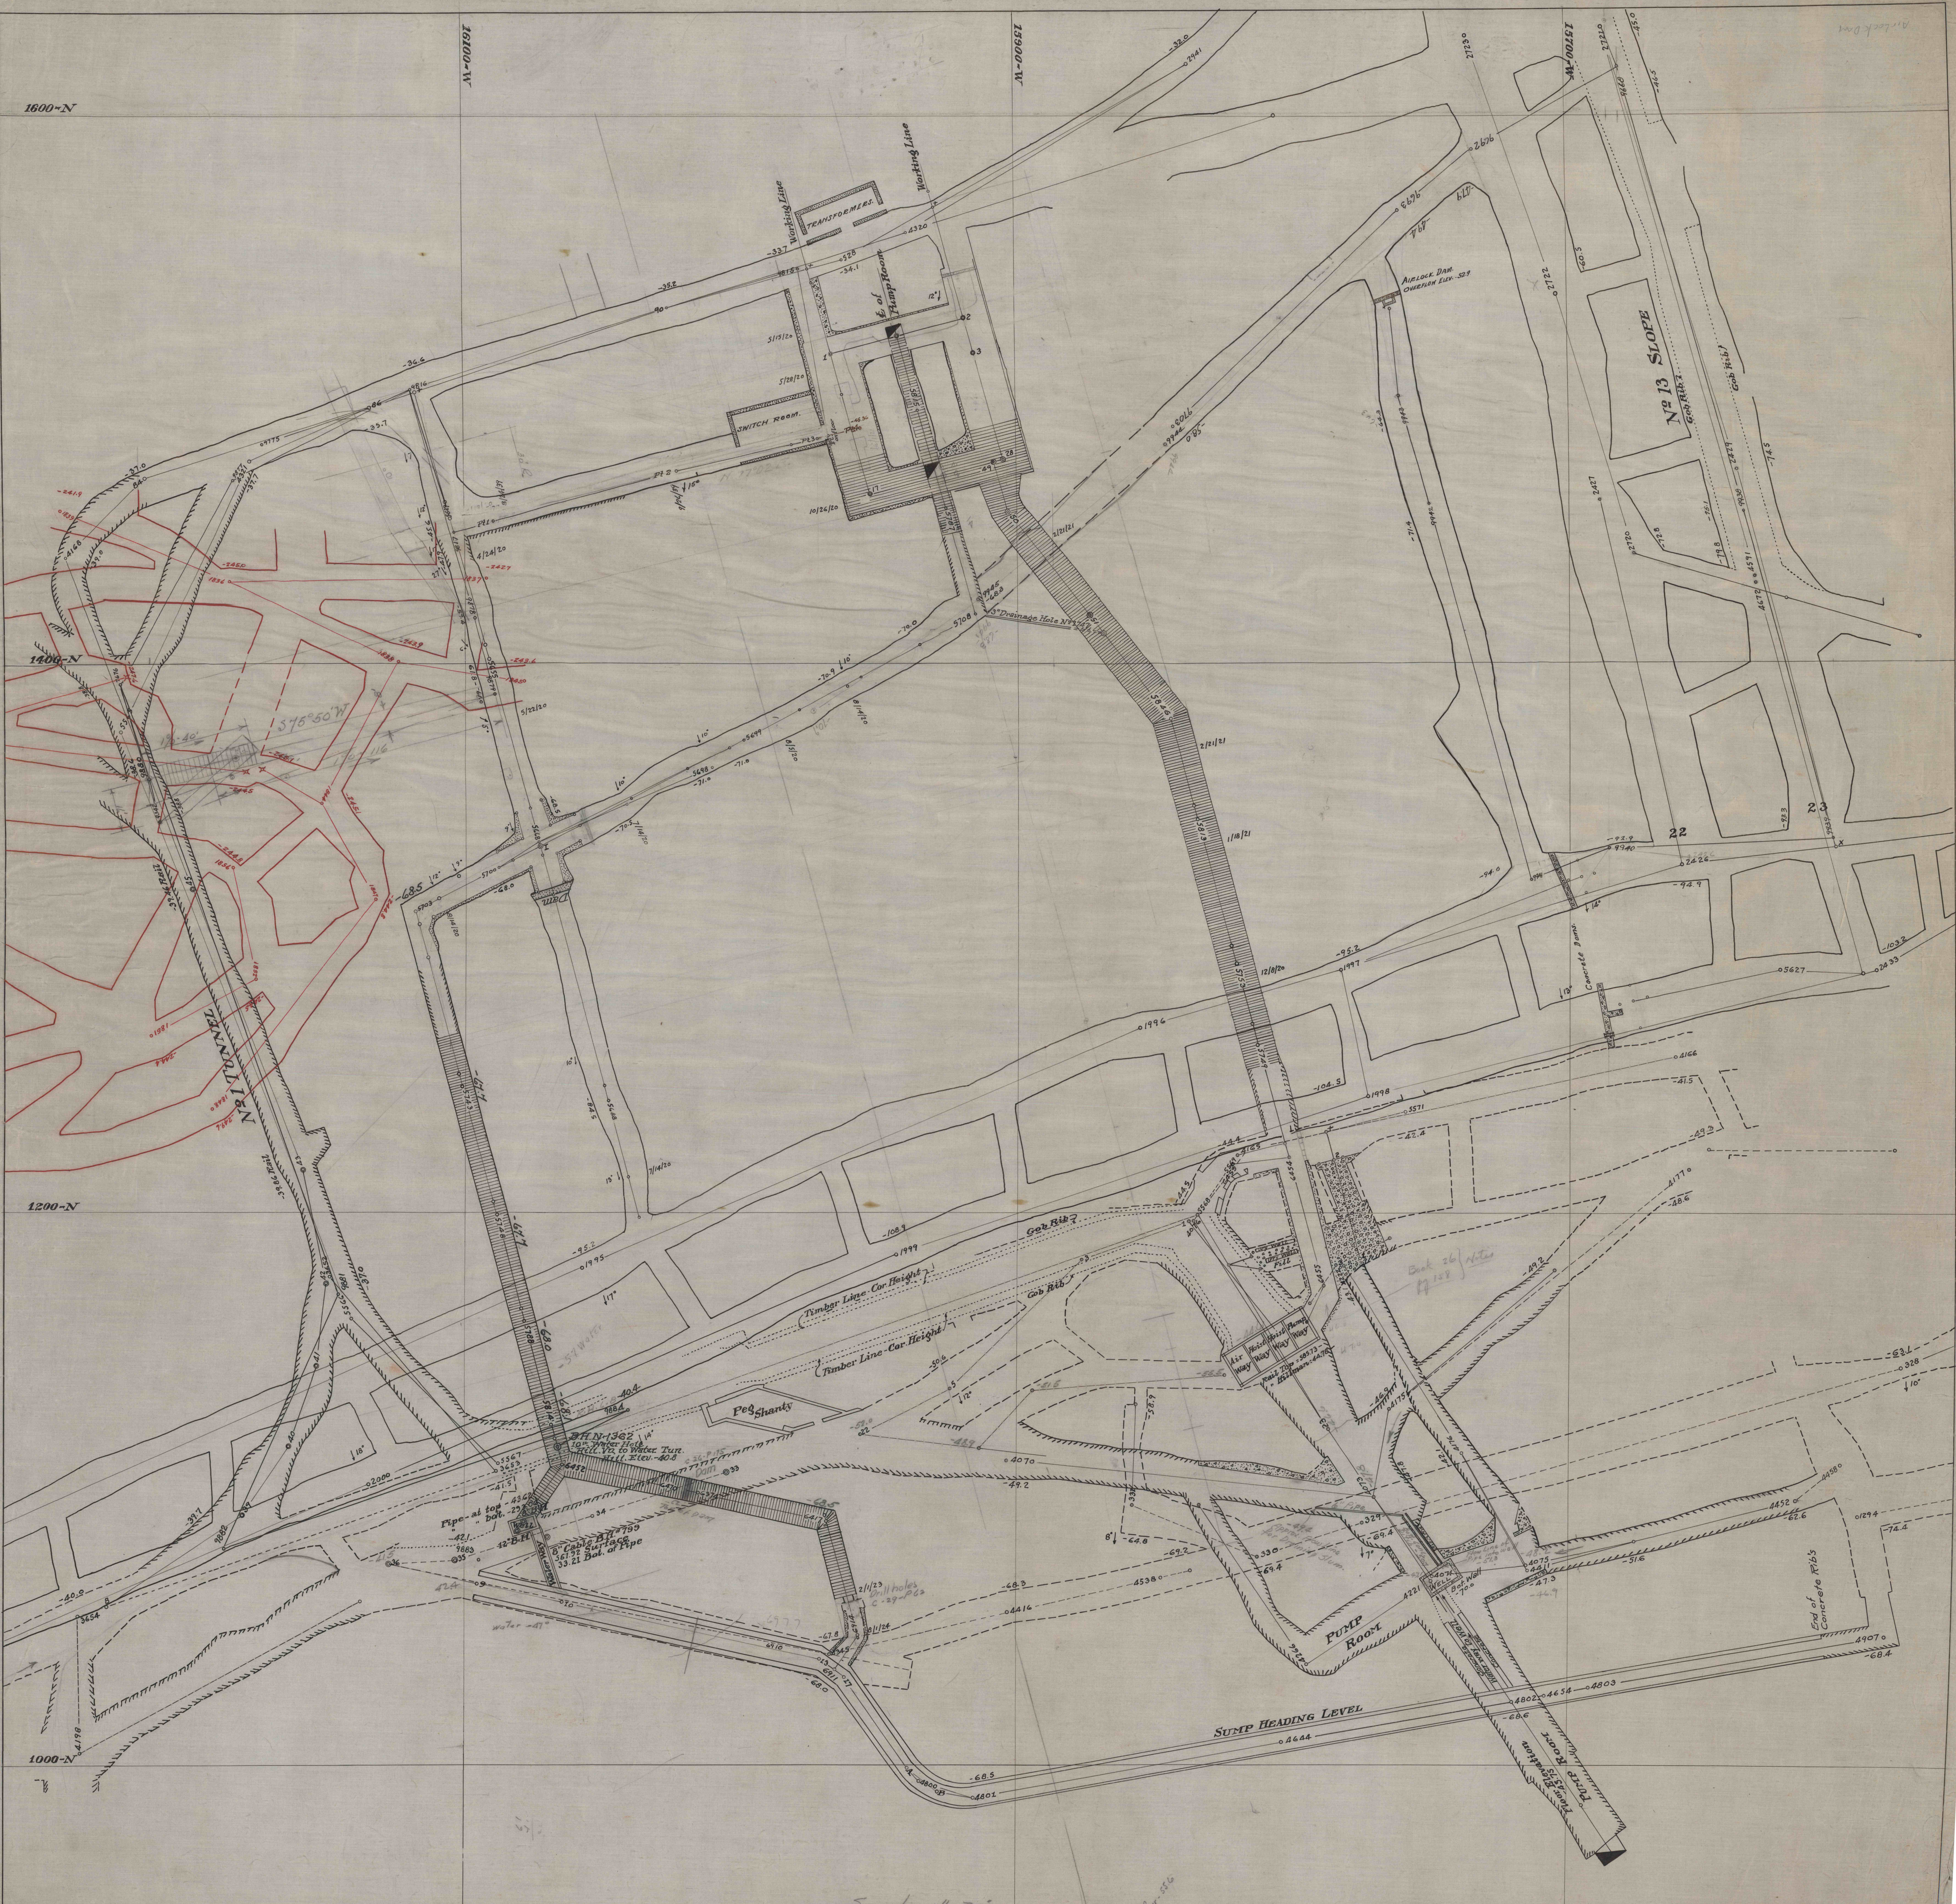

Scale 1"=20'