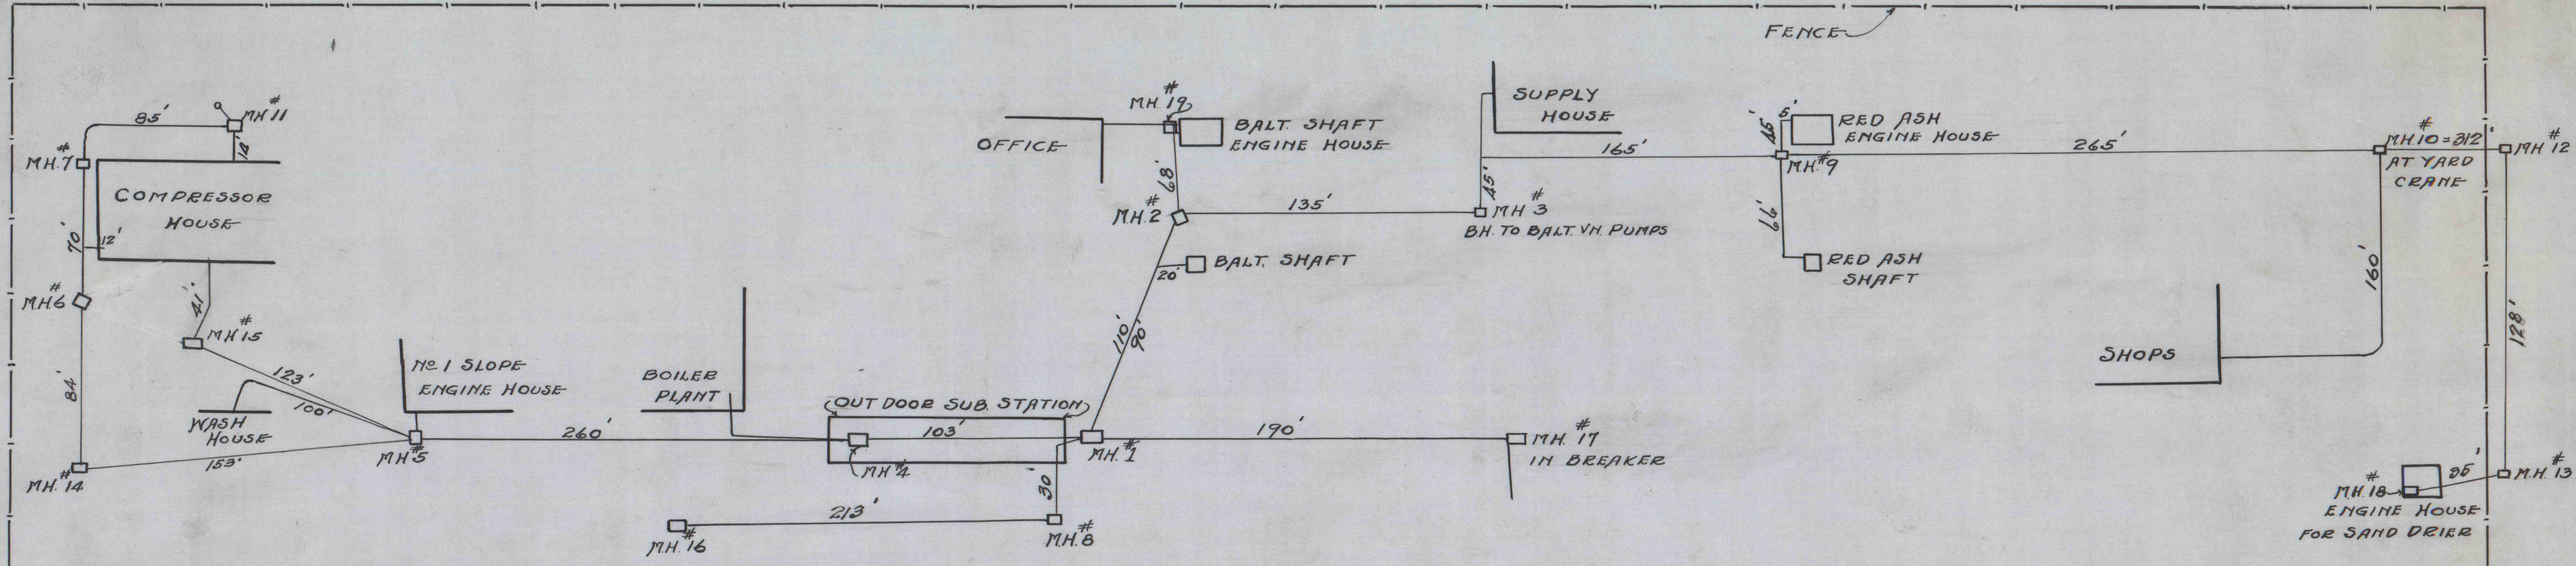

CABLES ON P.A. 77977

CABLES AS ORDERED			CABLES AS REQUIRED	
1375' - 3 COND. 400000 CM 5000 VOLTS	FROM O.C.B. AT M.H. #4 TO BALTIMORE SHAFT		300'	
(FURNISHED IN 2 PCS 700 AND 675')	" " " " " " " "	BORE HOLE IN YARD	400'	MH #3 BALT. VN PUMPS
	" " " " " " " "	M.H. #11 AND TOWER	675'	HILL BORE HOLE
775' - 3 COND. 4/0 5000 VOLTS	" " " " " " " "	M.H. #11 AND SUBSTATION	775'	ROTARY CONVERTERS
1100' - 3 COND. 1/0 (ONE LENGTH) 5000 VOLTS	" " " " " " " "	M.H. #6 AND COMPRESSOR HOUSE	550'	FAN 550' COMPRESSOR
1000' - 3 COND. 600000 C.M. 600 VOLTS	FROM OUTDOOR SUB. STATION TO BREAKER 4 PIECES		250' EACH	THRU. M.H. #1
300' - 3 COND. 300000 C.M. 600 VOLTS	" " " " " "	BOILER PLANT	300'	THRU. M.H. #4
1025' - 3 COND. 4/0 600 VOLTS	" M.H. #4 AND LIGHTING TRANSF. AT OUT DOOR SUBSTATION		450' - TO BREAKER	
(FURNISHED IN ONE LENGTH OR IN 2 LENGTHS 450' + 575')	" " " " " " " " " " " "		275' - TO M.H. #2 AT BALTIMORE SHAFT.	
	" " " " " " " " " " " "		300' - TO BOILER PLANT.	
900' - 3 COND. 3/0 600 VOLTS	" M.H. #2 TO SHOPS		900'	
800' - 3 COND. #4 600 VOLTS	" M.H. #4 TO M.H. #5		300'	
(FURNISHED IN ONE LENGTH)	" M.H. #5 TO WASH HOUSE		150'	
	" M.H. #5 TO COMPRESSOR HOUSE		350'	
4000' - 1 COND. 1000000 C.M. 600 VOLTS.	" SUB STATION IN COMPRESSOR HOUSE TO SHAFT 4 PCS 1000' EACH			

CABLES ON PA 76832

900' - 3 COND. 4/0 5000 VOLTS	FROM O.C.B. AT M.H. #4 TO YARD CRANE	900'
2000' - 1 COND. 4/0 600 VOLTS	" MH #4 TO SHOP FOR BATTERY CHARGING PANEL	2000' IN 2 PIECES

FENCE

LANCE COLLIERY
MAP SHOWING
OUTSIDE TRANSMISSION SYSTEM

JAN. 4, 1945.